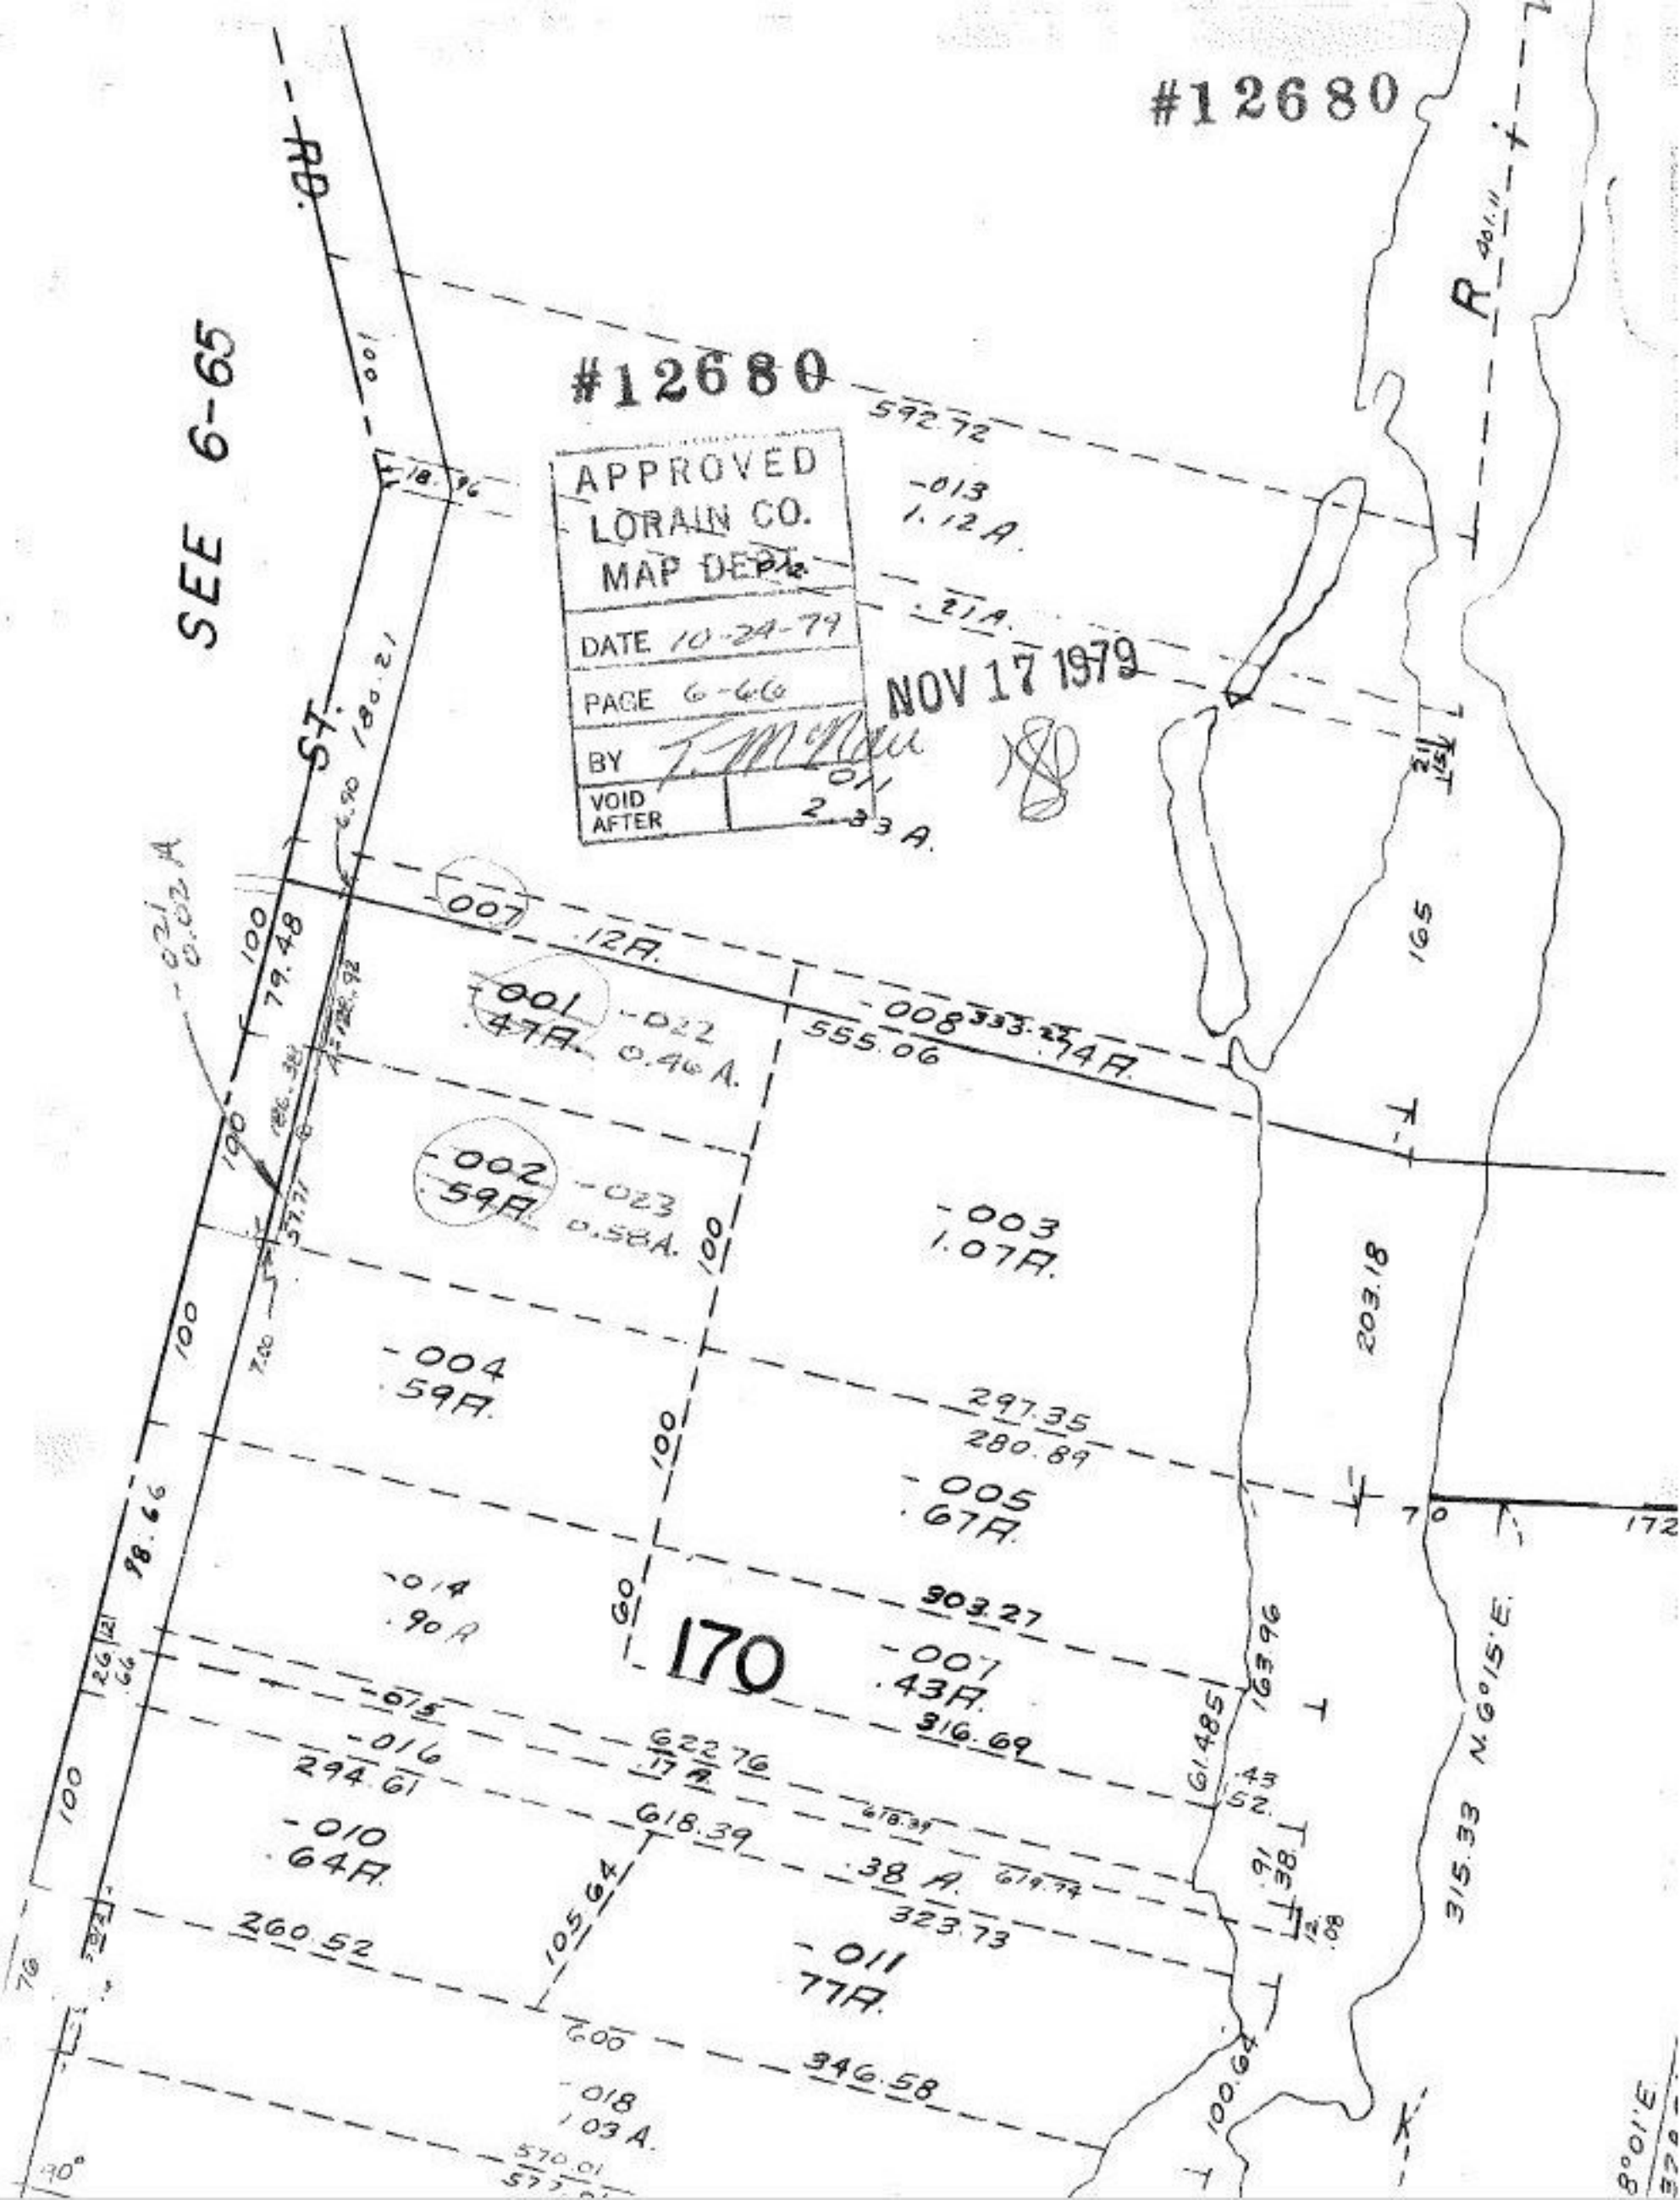

#12680
#12680
SEE 6-65
RD.
ST.
APPROVED
LORAIN CO.
MAP DEPT.
DATE 10-24-79
PAGE 6-66
BY T. McNau
VOID AFTER
NOV 17 1979
592.72
-013
1.12 A.
.21 A.
-011
2.33 A.
-007
.12 A.
-001
.47 A.
-022
0.46 A.
-008
333.22
.74 A.
555.06
-002
.59 A.
-023
0.58 A.
-003
1.07 A.
-004
.59 A.
297.35
280.89
-005
.67 A.
-014
.90 A.
303.27
-007
.43 A.
316.69
170
-015
-016
294.61
622.76
.17 A.
618.39
.38 A.
323.73
-010
.64 A.
260.52
105.64
-011
.77 A.
346.58
-018
1.03 A.
570.01
79.48
98.66
203.18
165
163.96
61.485
315.33
N. 6°15' E.
100.64