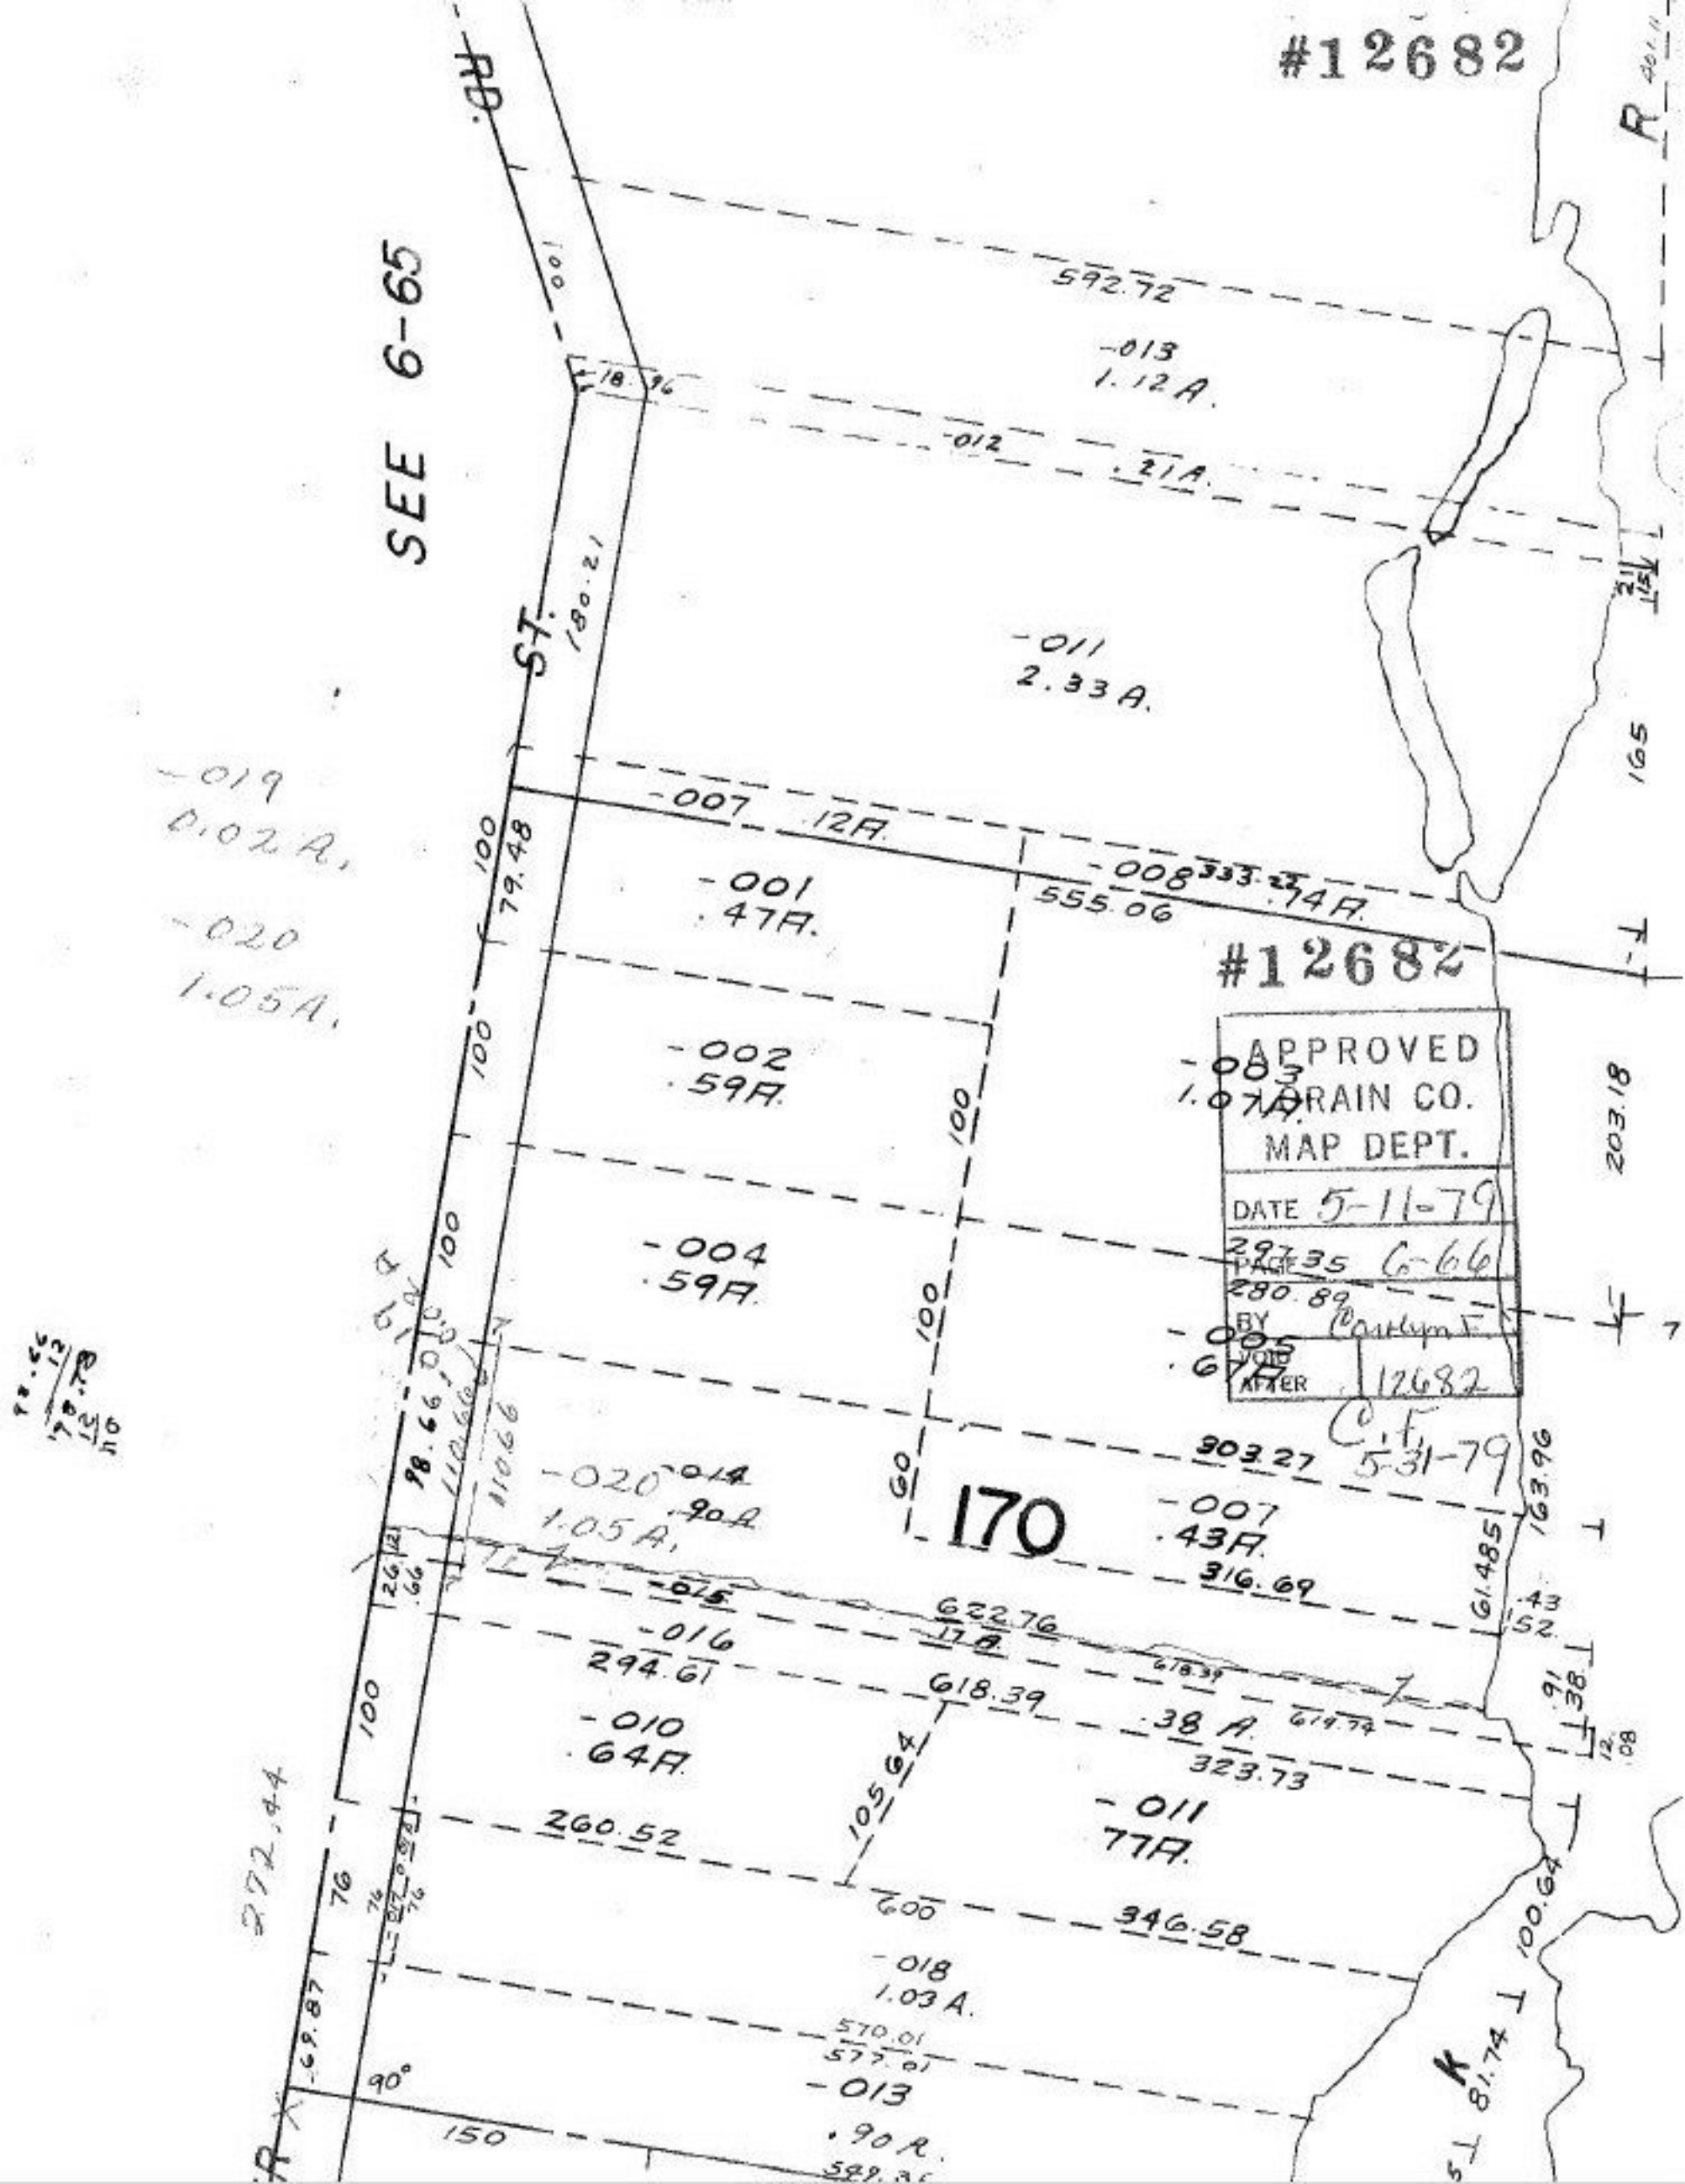
#12682
SEE 6-65
RD.
ST.
592.72
-013
1.12 A.
-012
.21 A.
-011
2.33 A.
-019
0.02 A.
-020
1.05 A.
-007
.12 A.
-008
333.22
.74 A.
555.06
-001
.47 A.
-002
.59 A.
-003
1.07 A.
-004
.59 A.
-005
.67 A.
303.27
-007
.43 A.
316.69
170
-020
1.05 A.
-014
.90 A.
-015
622.76
.17 A.
-016
294.61
618.39
.38 A.
-010
.64 A.
323.73
-011
77 A.
260.52
346.58
-018
1.03 A.
570.01
577.01
-013
.90 A.
272.44
90°
150
#12682
APPROVED
DRAIN CO.
MAP DEPT.
DATE 5-11-79
PAGE 6-66
BY
VOID
AFTER 12682
C.F.
5-31-79
203.18
163.96
61.485
100.64
81.74
165
R
K