#12705

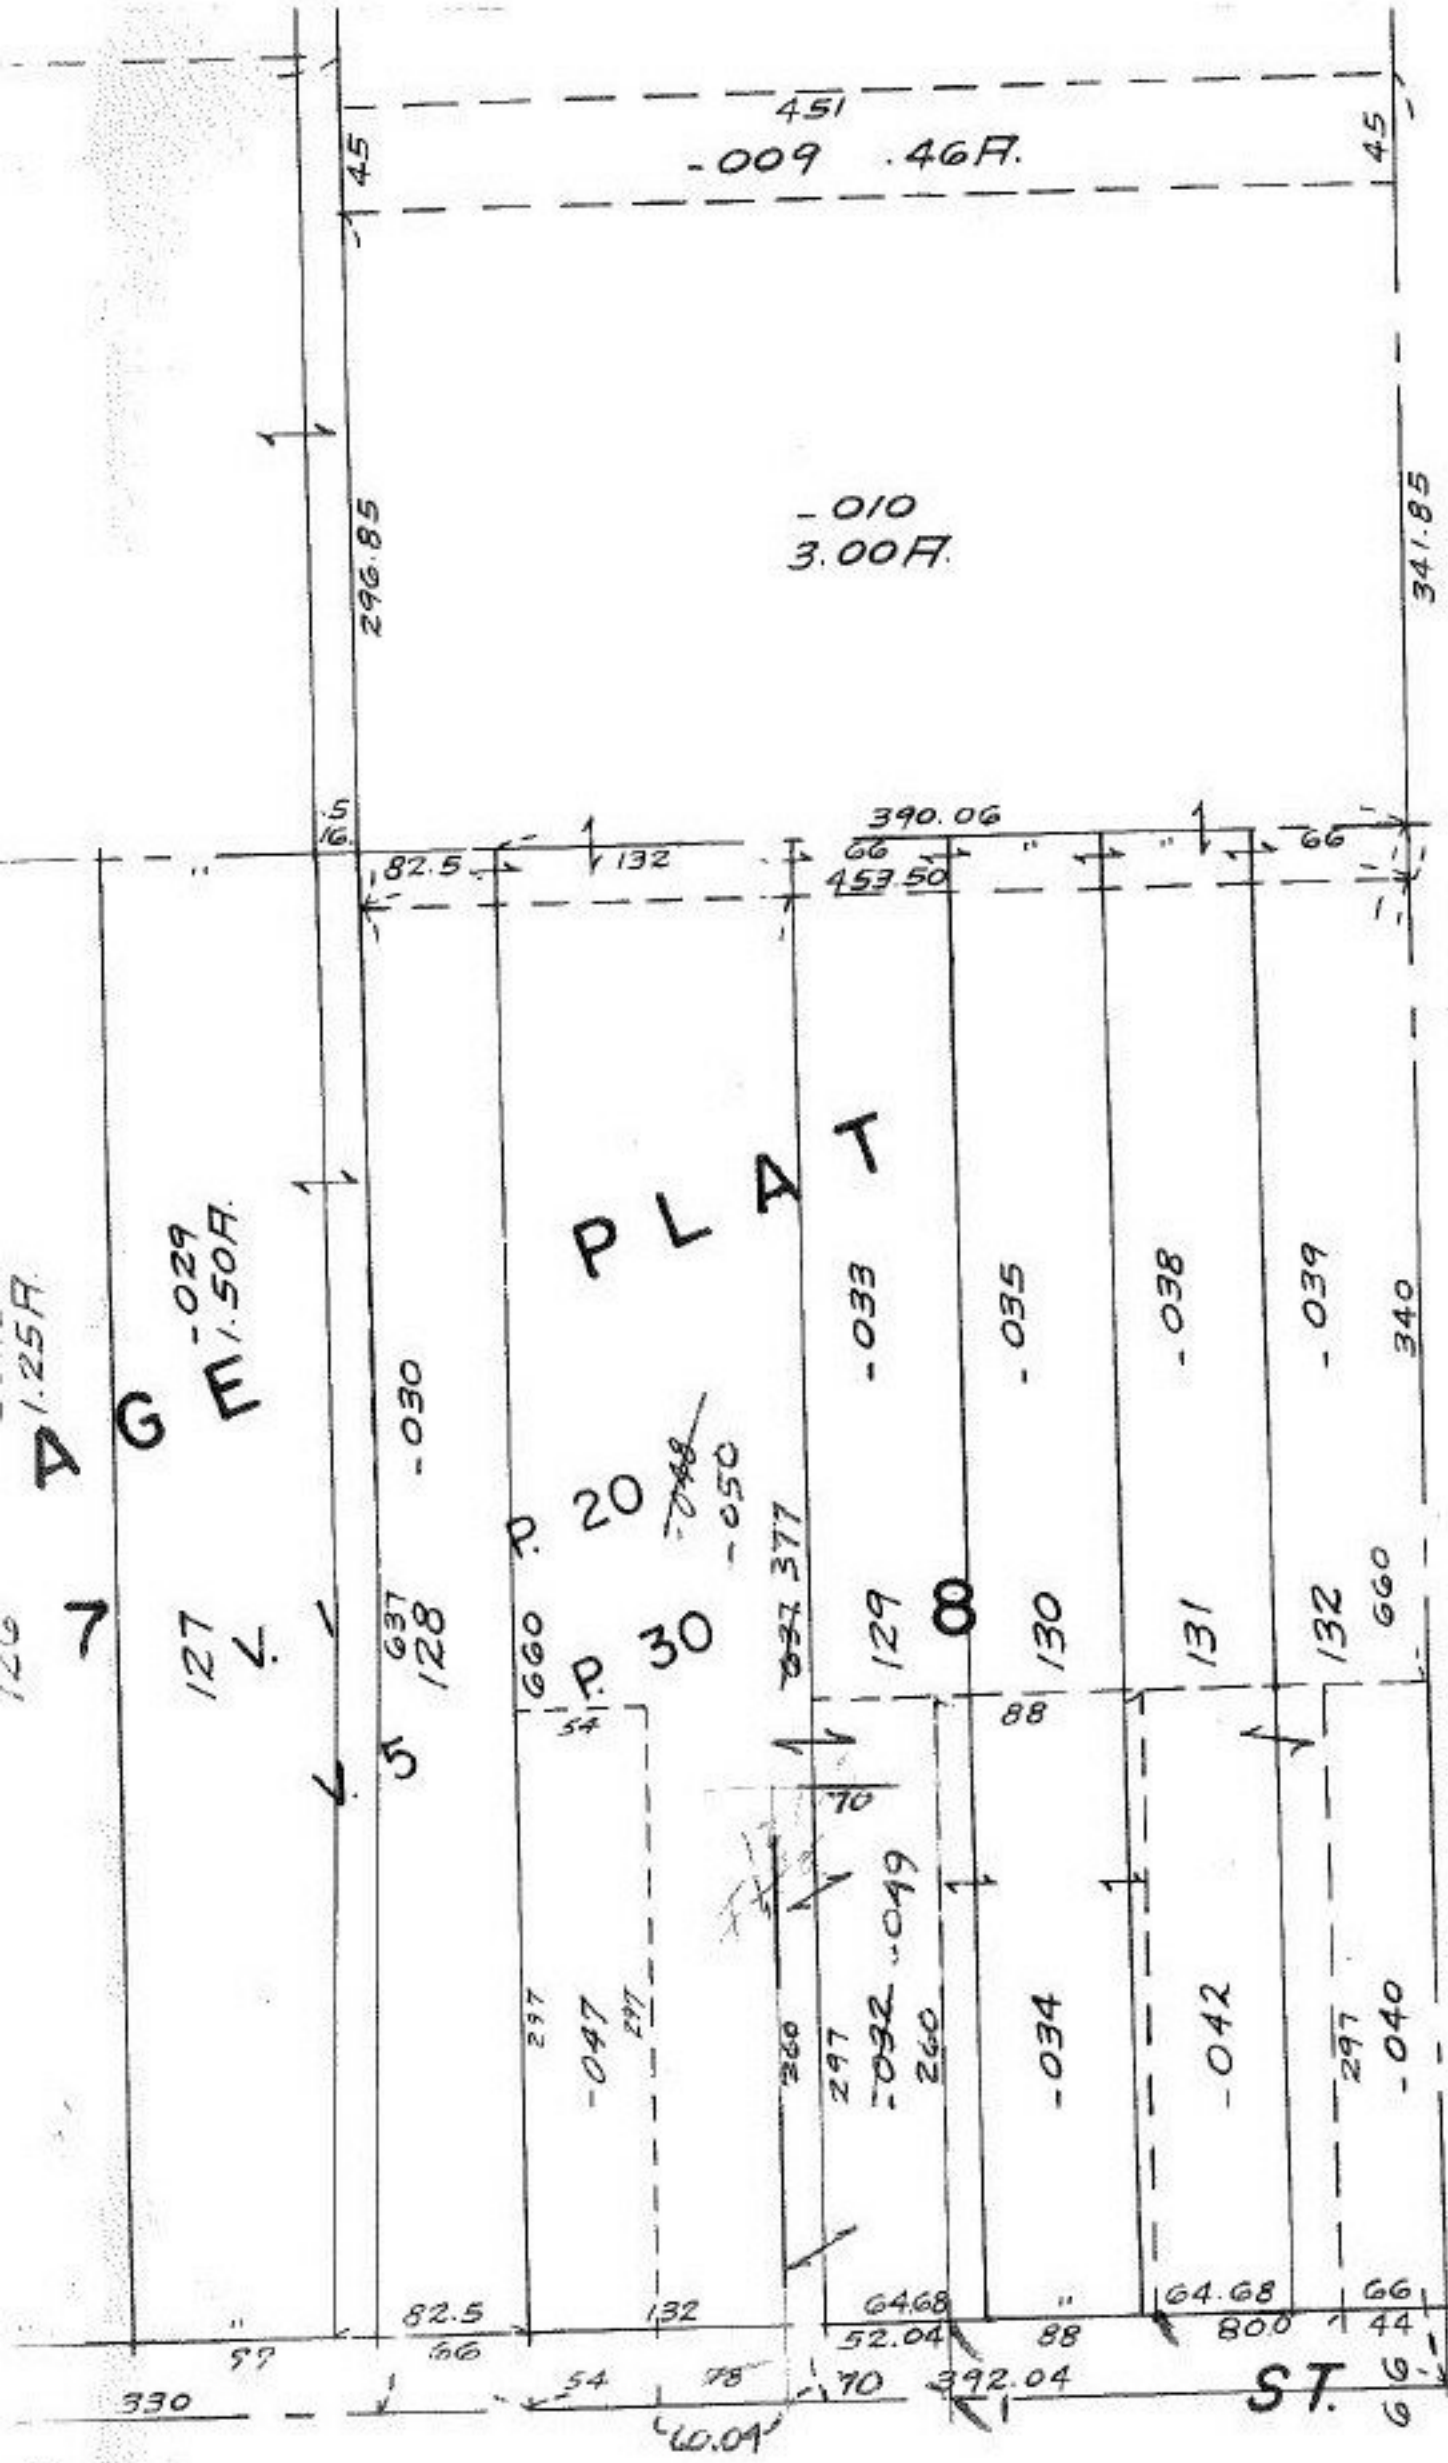

#12705

APPROVED
LORAIN CO.
MAP DEPT.
DATE 6-21-79
PAGE 900-076-B
BY T. McNair
VOID AFTER

NOV 1 1979

52.04
78
130.04
70
60.04