


SEE 4-00-024-C

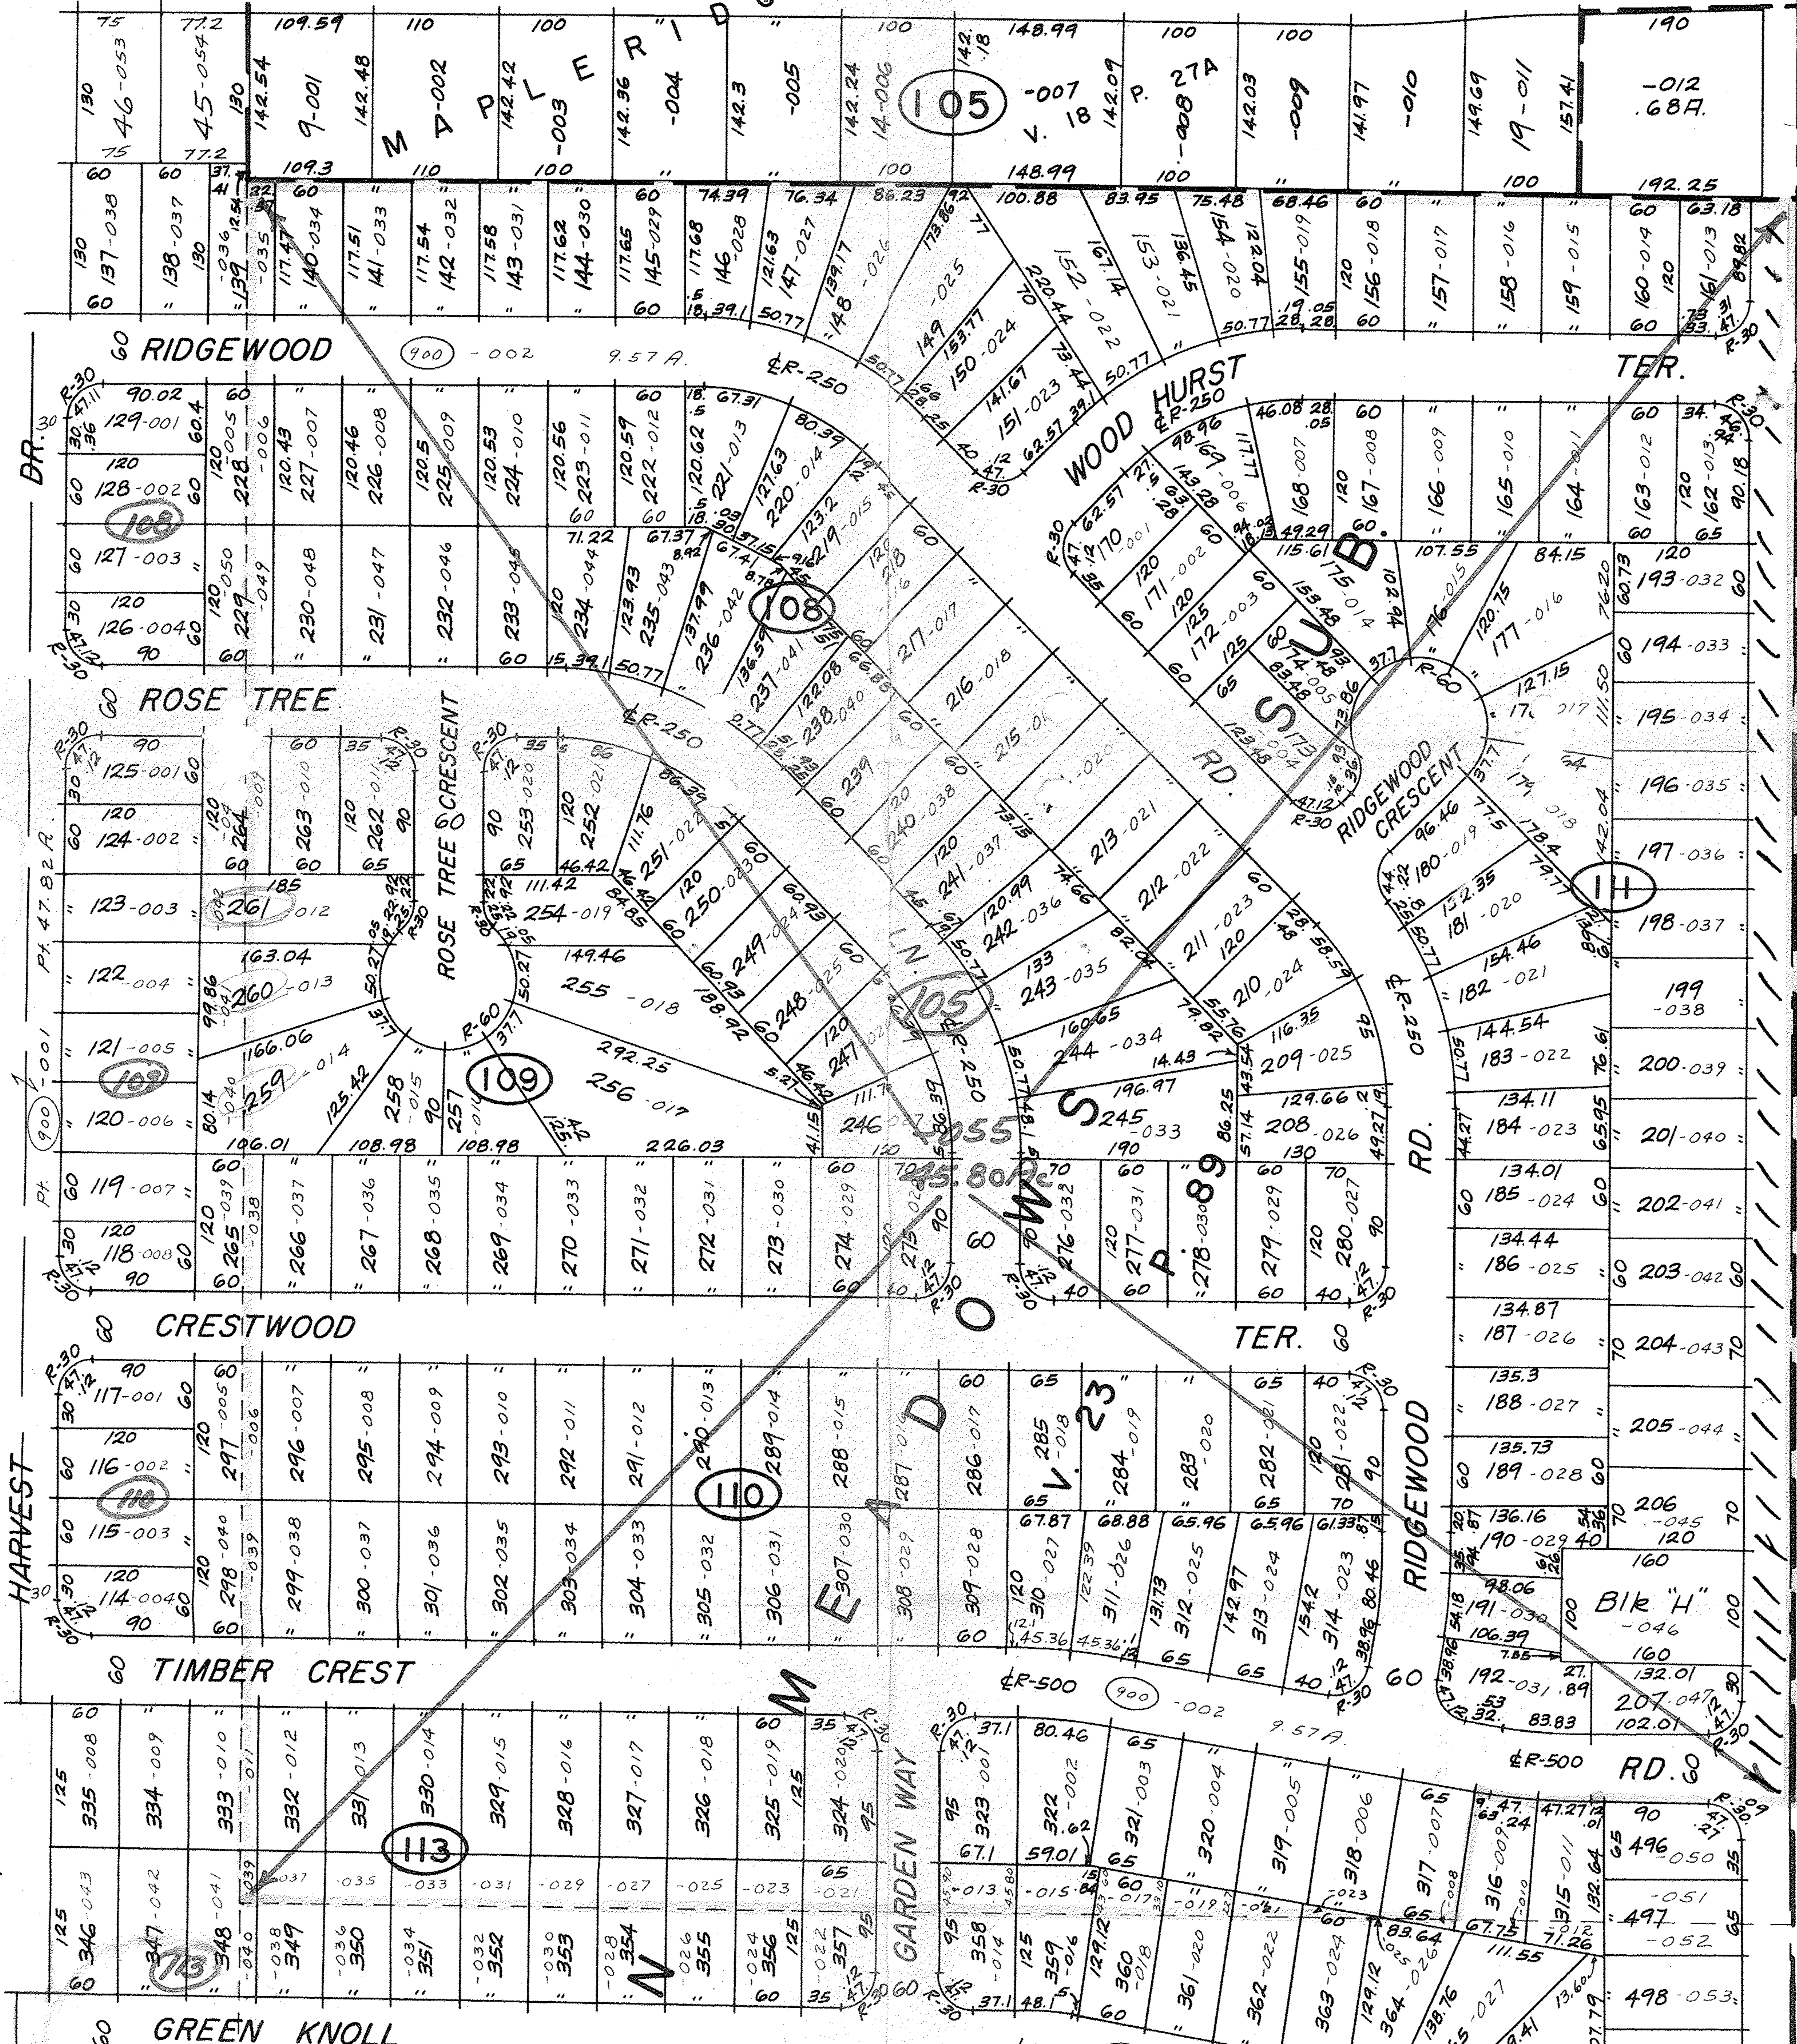

Everything Within
Yellow - Vacated

#12709
 APPROVED
 LORAIN CO.
 MAP DEPT.
 DATE 5-31-79
 PAGE 4-00-024-D
 BY [Signature]
 VOID AFTER

This Vacation Connected
 To Exclude Lear
 Nagle Road. [Signature]
 11-28-79

SEE 4-00-025-A

Number To
 Put Back To

HARVEST

GREEN KNOLL

TIMBER CREST

CRESTWOOD

ROSE TREE

RIDGEWOOD

GARDEN WAY

WOOD HURST

RIDGEWOOD CRESCENT

RIDGEWOOD

TER.

TER.

N. V. S. RD.

BR.

PT. 47.82 R.

PT. 1.001

R-30

R-30

R-30

R-30

R-30

Map containing numerous lot numbers and acreages, including circled numbers 105, 108, 109, 110, 113, 114, and a yellow-shaded area on the right side.