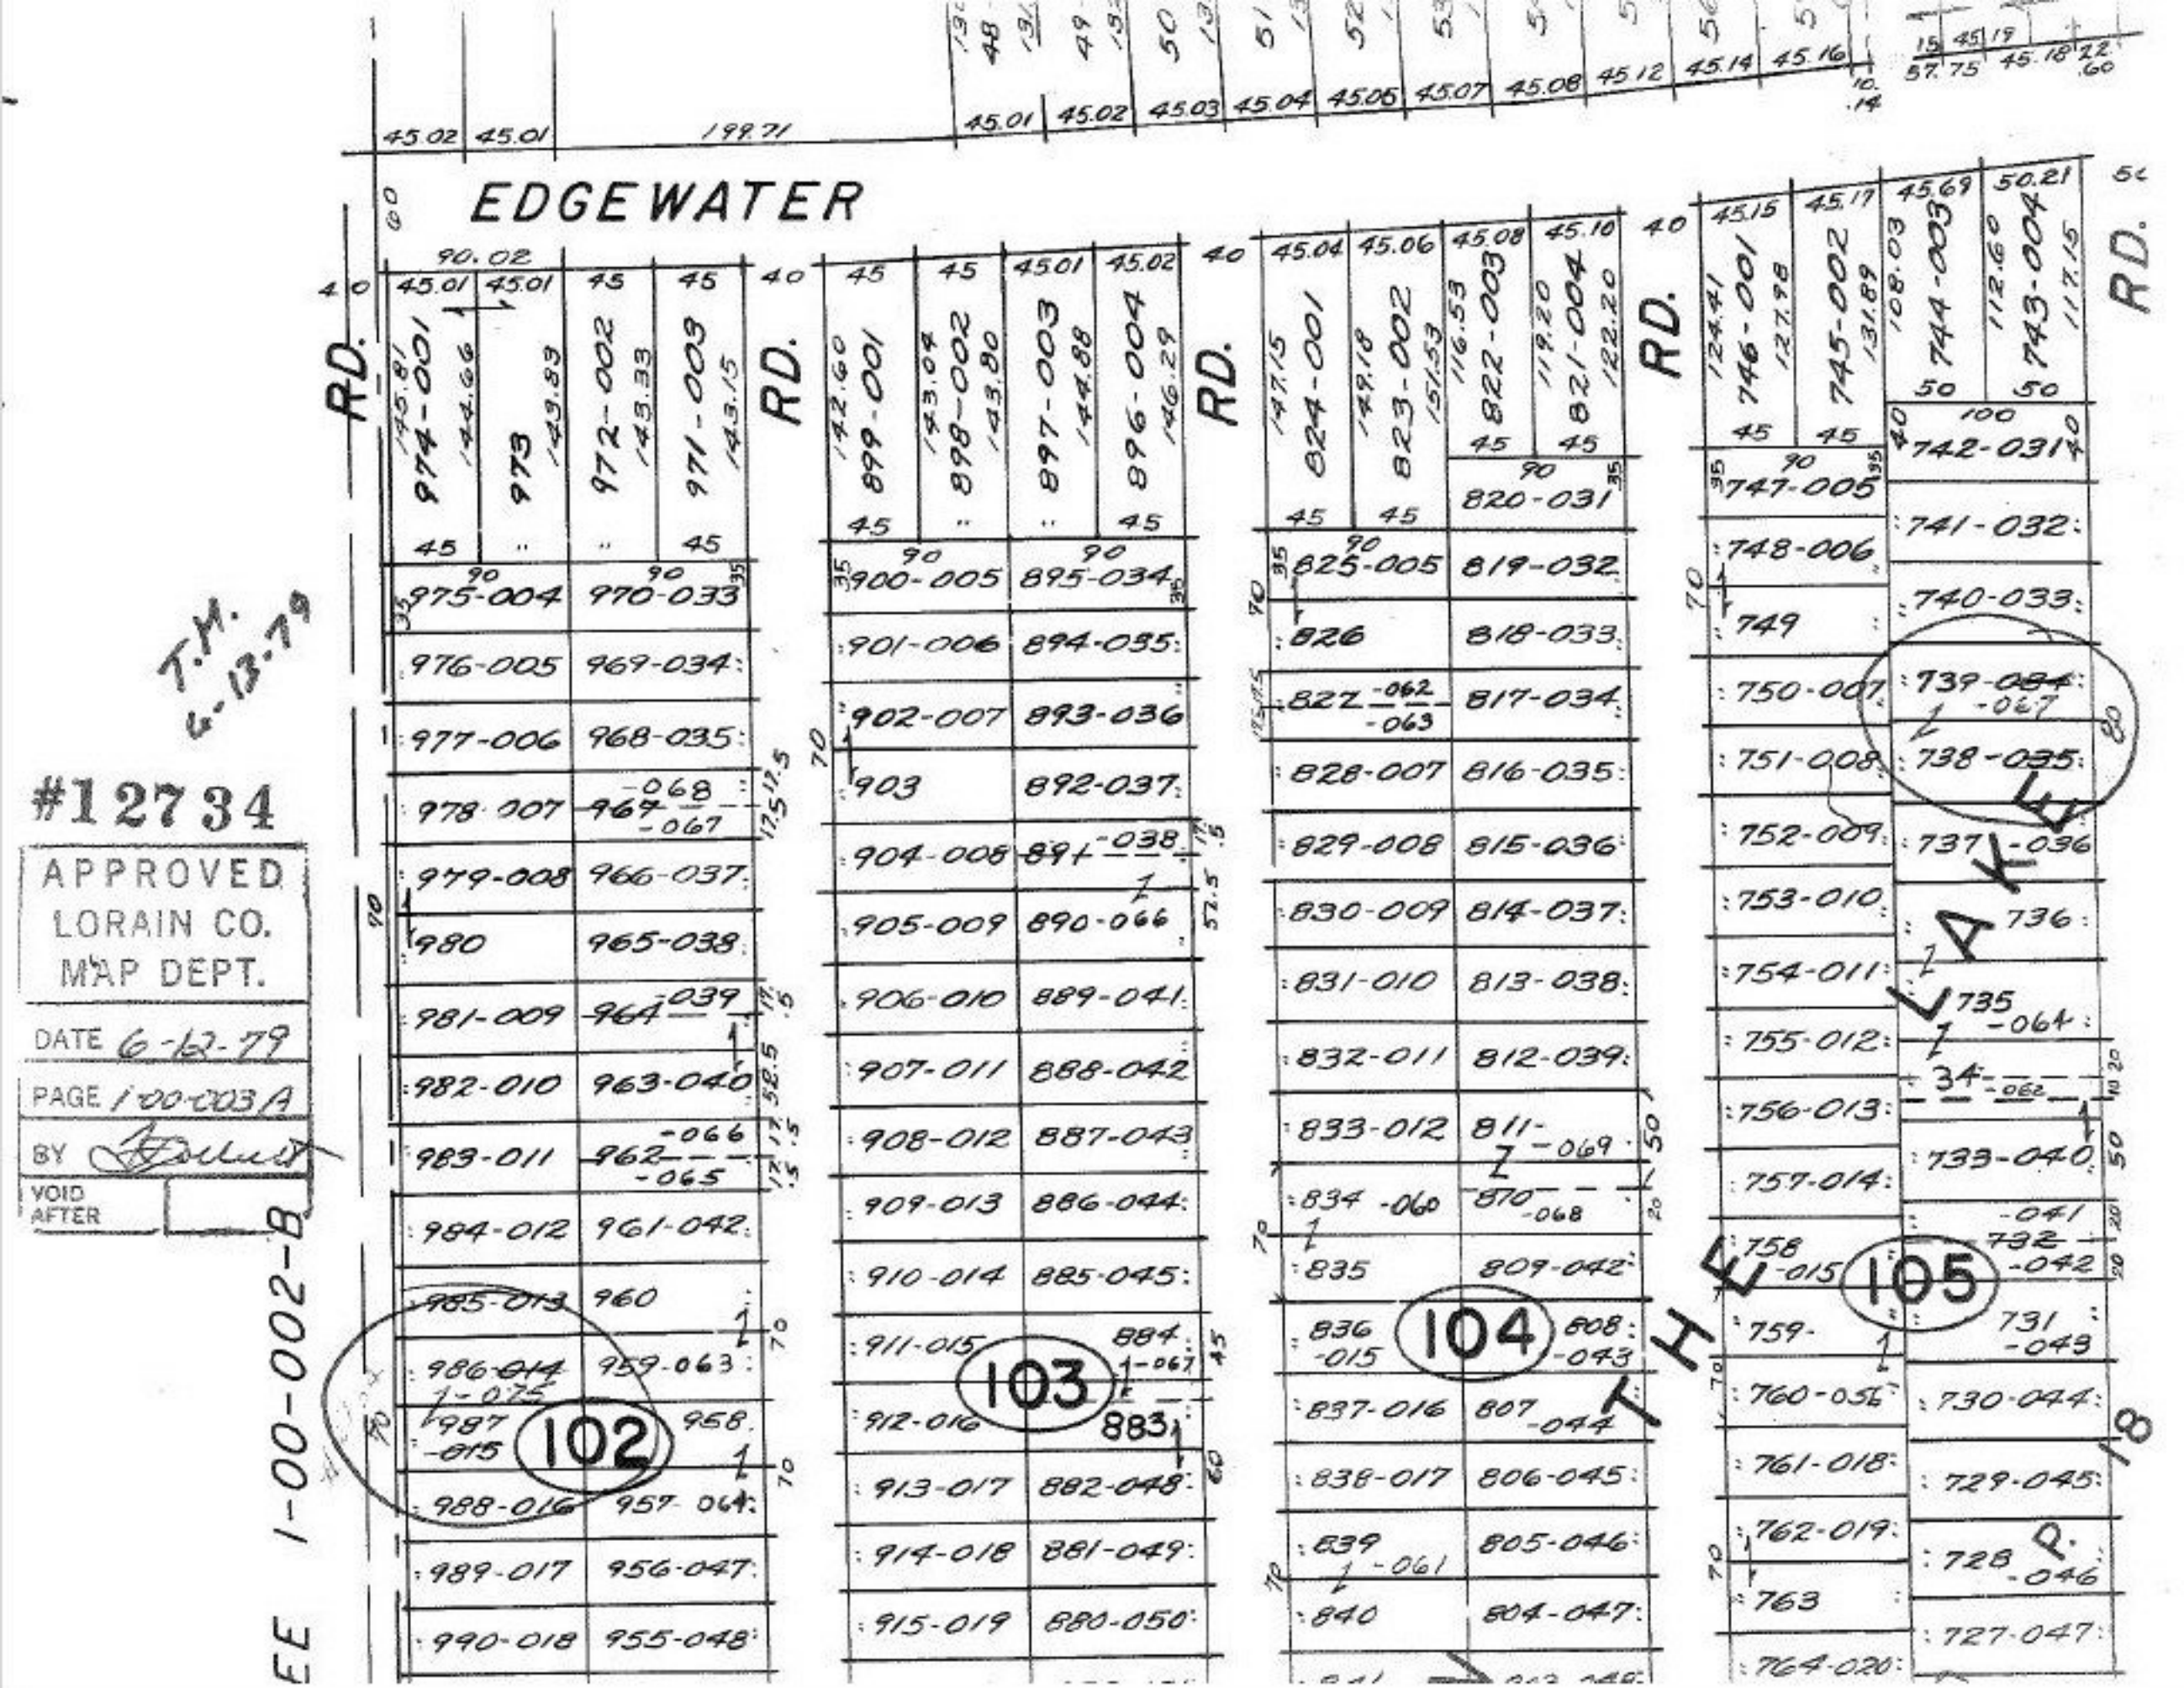

EDGEWATER
RD.
974-001
973
972-002
971-003
899-001
898-002
897-003
896-004
824-001
823-002
822-003
821-004
746-001
745-002
744-003
743-004
975-004
970-033
976-005
969-034
977-006
968-035
978-007
979-008
966-037
980
965-038
981-009
982-010
963-040
983-011
984-012
961-042
985-013
960
986-014
959-063
987-015
958
988-016
957-064
989-017
956-047
990-018
955-048
900-005
895-034
901-006
894-035
902-007
893-036
903
892-037
904-008
891-038
905-009
890-066
906-010
889-041
907-011
888-042
908-012
887-043
909-013
886-044
910-014
885-045
911-015
884
912-016
883
913-017
882-048
914-018
881-049
915-019
880-050
825-005
819-032
826
818-033
822-062
-063
817-034
828-007
816-035
829-008
815-036
830-009
814-037
831-010
813-038
832-011
812-039
833-012
811-069
834-060
870-068
835
809-042
836-015
808-043
837-016
807-044
838-017
806-045
839-061
805-046
840
804-047
820-031
747-005
748-006
749
750-007
751-008
752-009
753-010
754-011
755-012
756-013
757-014
758-015
759
760-056
761-018
762-019
763
764-020
742-031
741-032
740-033
739-084
-067
738-035
737-036
736
735-064
34-062
733-040
-041
732-042
731-043
730-044
729-045
728-046
727-047
102
103
104
105
T.M. 6-13-79
#12734
APPROVED
LORAIN CO.
MAP DEPT.
DATE 6-12-79
PAGE 1-00-003A
BY
VOID AFTER
1-00-002-B
P. 18