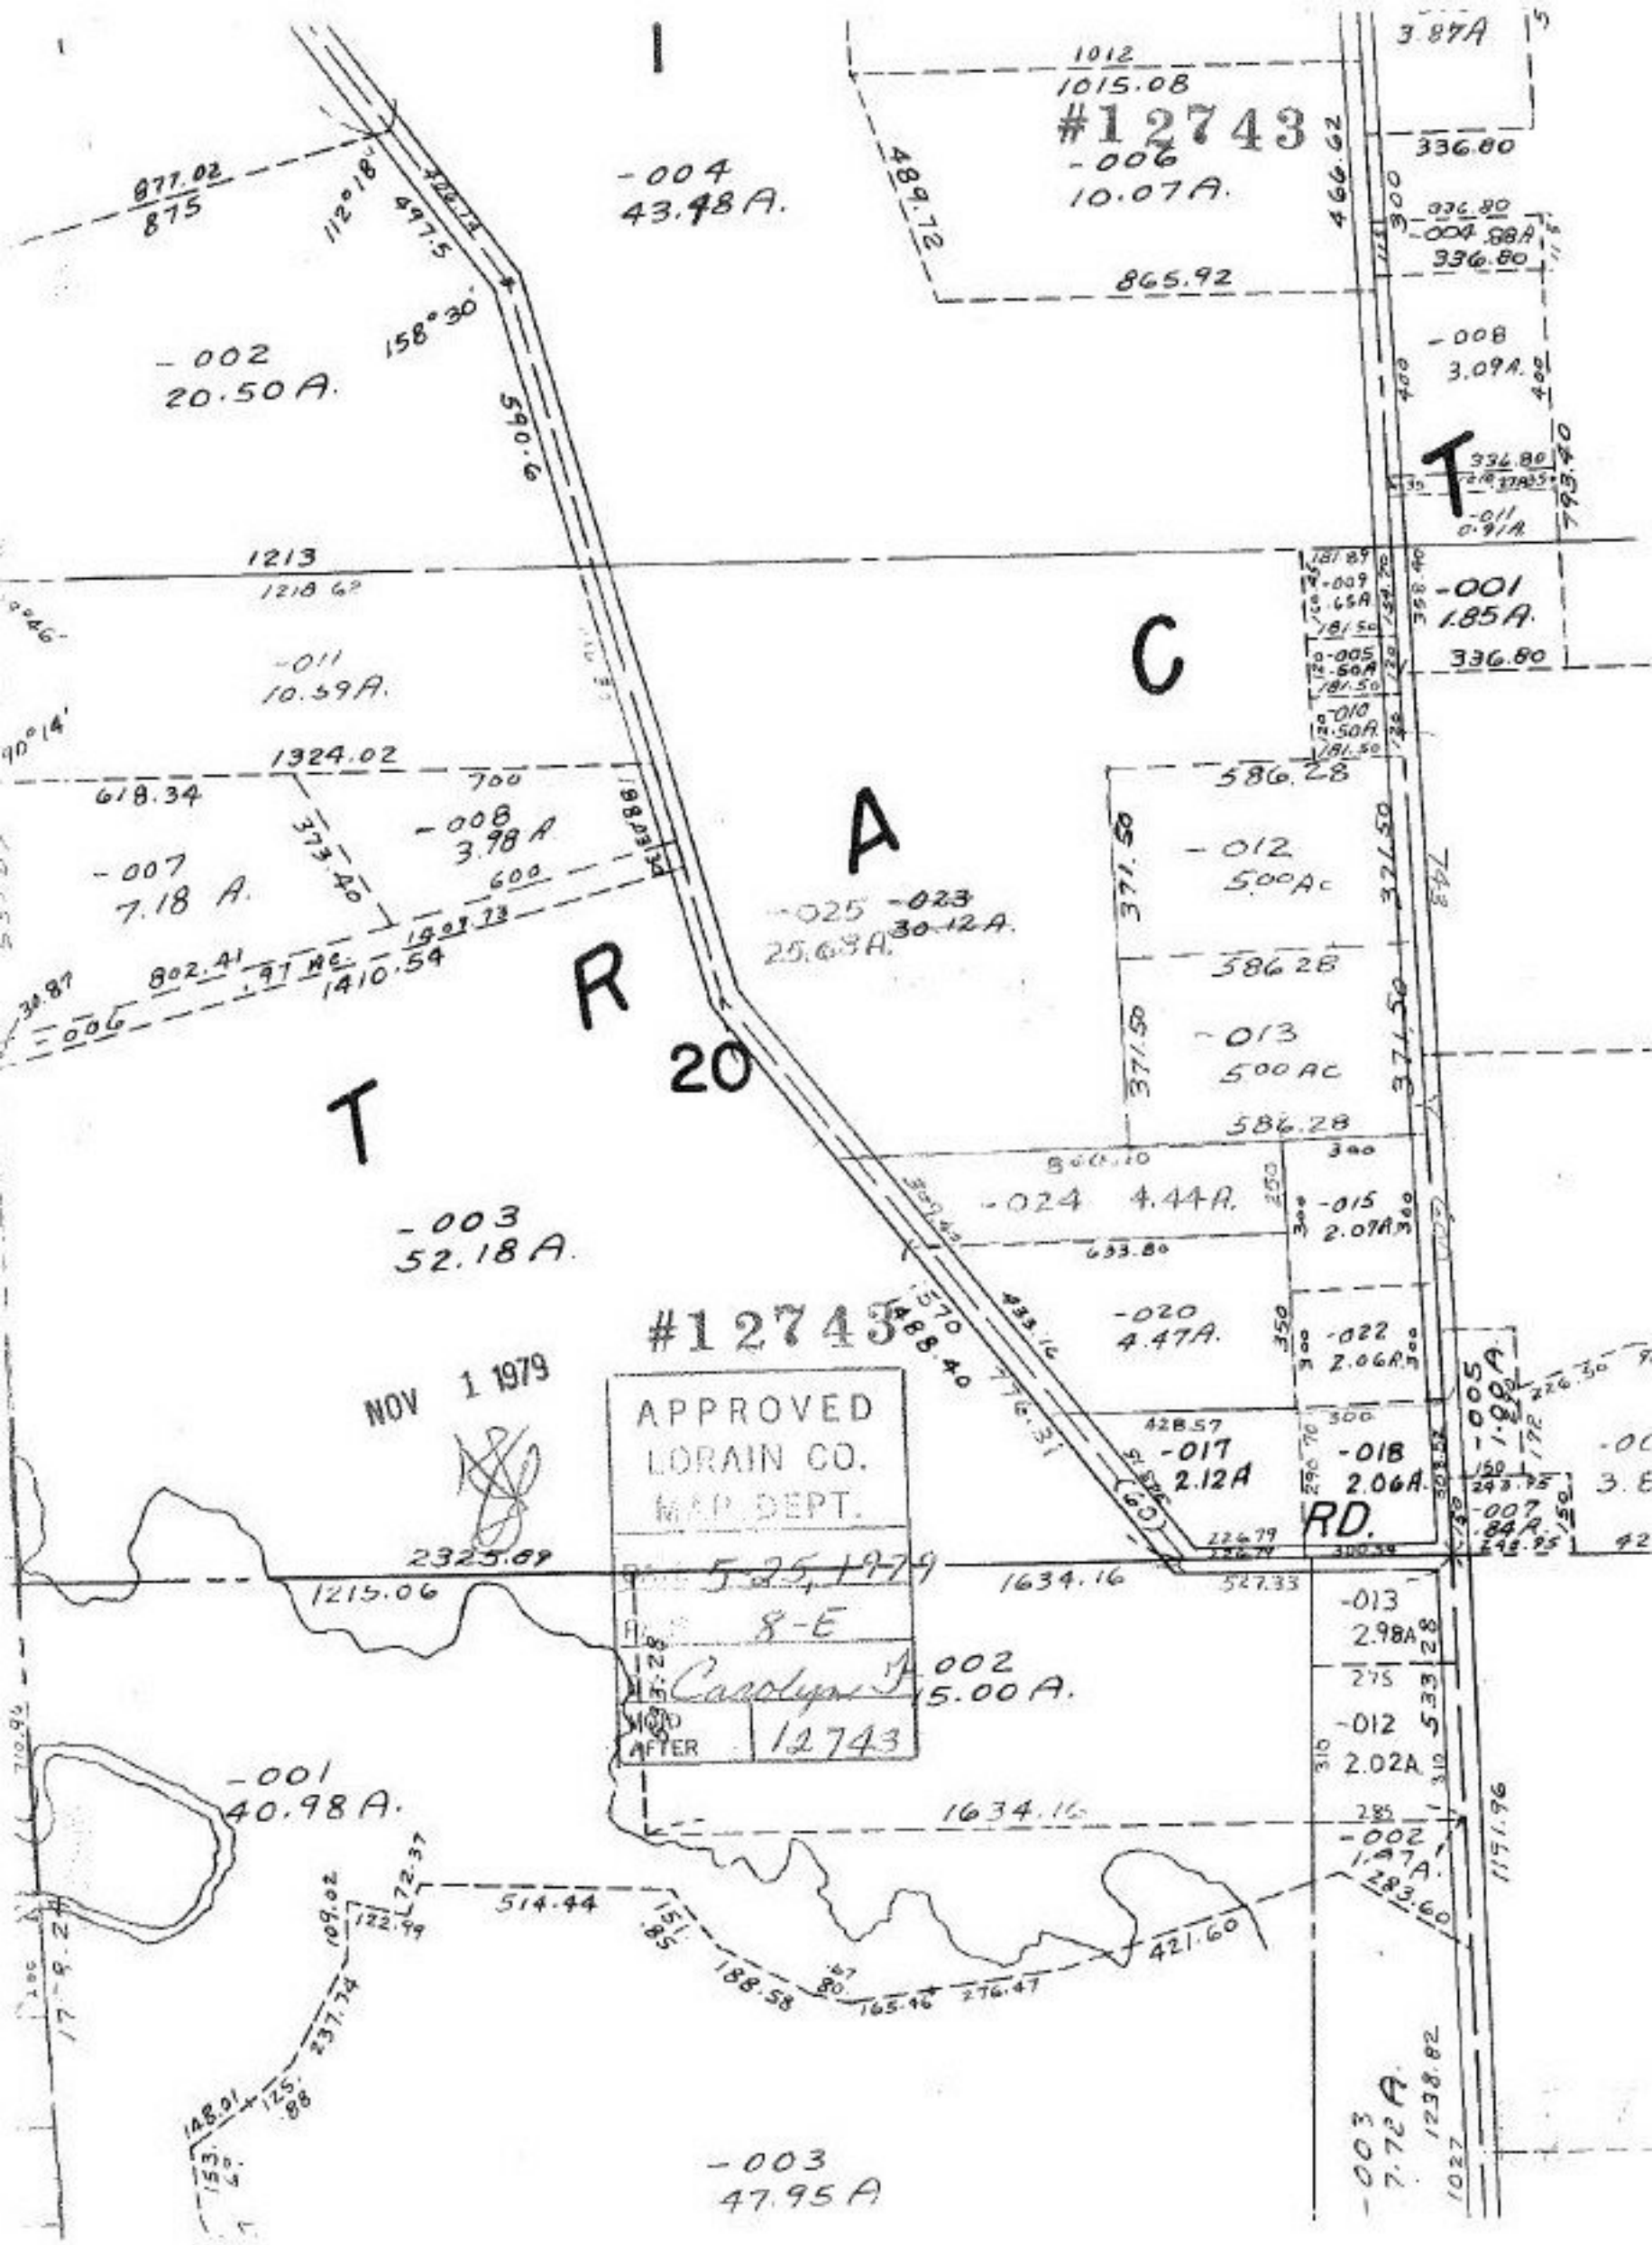

#12743
-006
10.07A.
-004
43.48A.
-002
20.50A.
-008
3.09A.
-001
1.85A.
-011
10.59A.
-007
7.18 A.
-008
3.98 A
-012
5.00Ac
-013
5.00 Ac
-025
25.63A.
-023
30.12A.
-003
52.18A.
-024
4.44A.
-015
2.07A
-020
4.47A.
-022
2.06A
-017
2.12A
-018
2.06A.
-005
1.00A
-013
2.98A
-012
2.02A
-002
1.47A
-002
5.00A.
-001
40.98A.
-003
47.95A
-003
7.72A
RD.
T R A C T 20
#12743
NOV 1 1979
APPROVED
LORAIN CO.
MAP DEPT.
5-25-1979
8-E
Carolyn
12743