12753

SEE 13-H

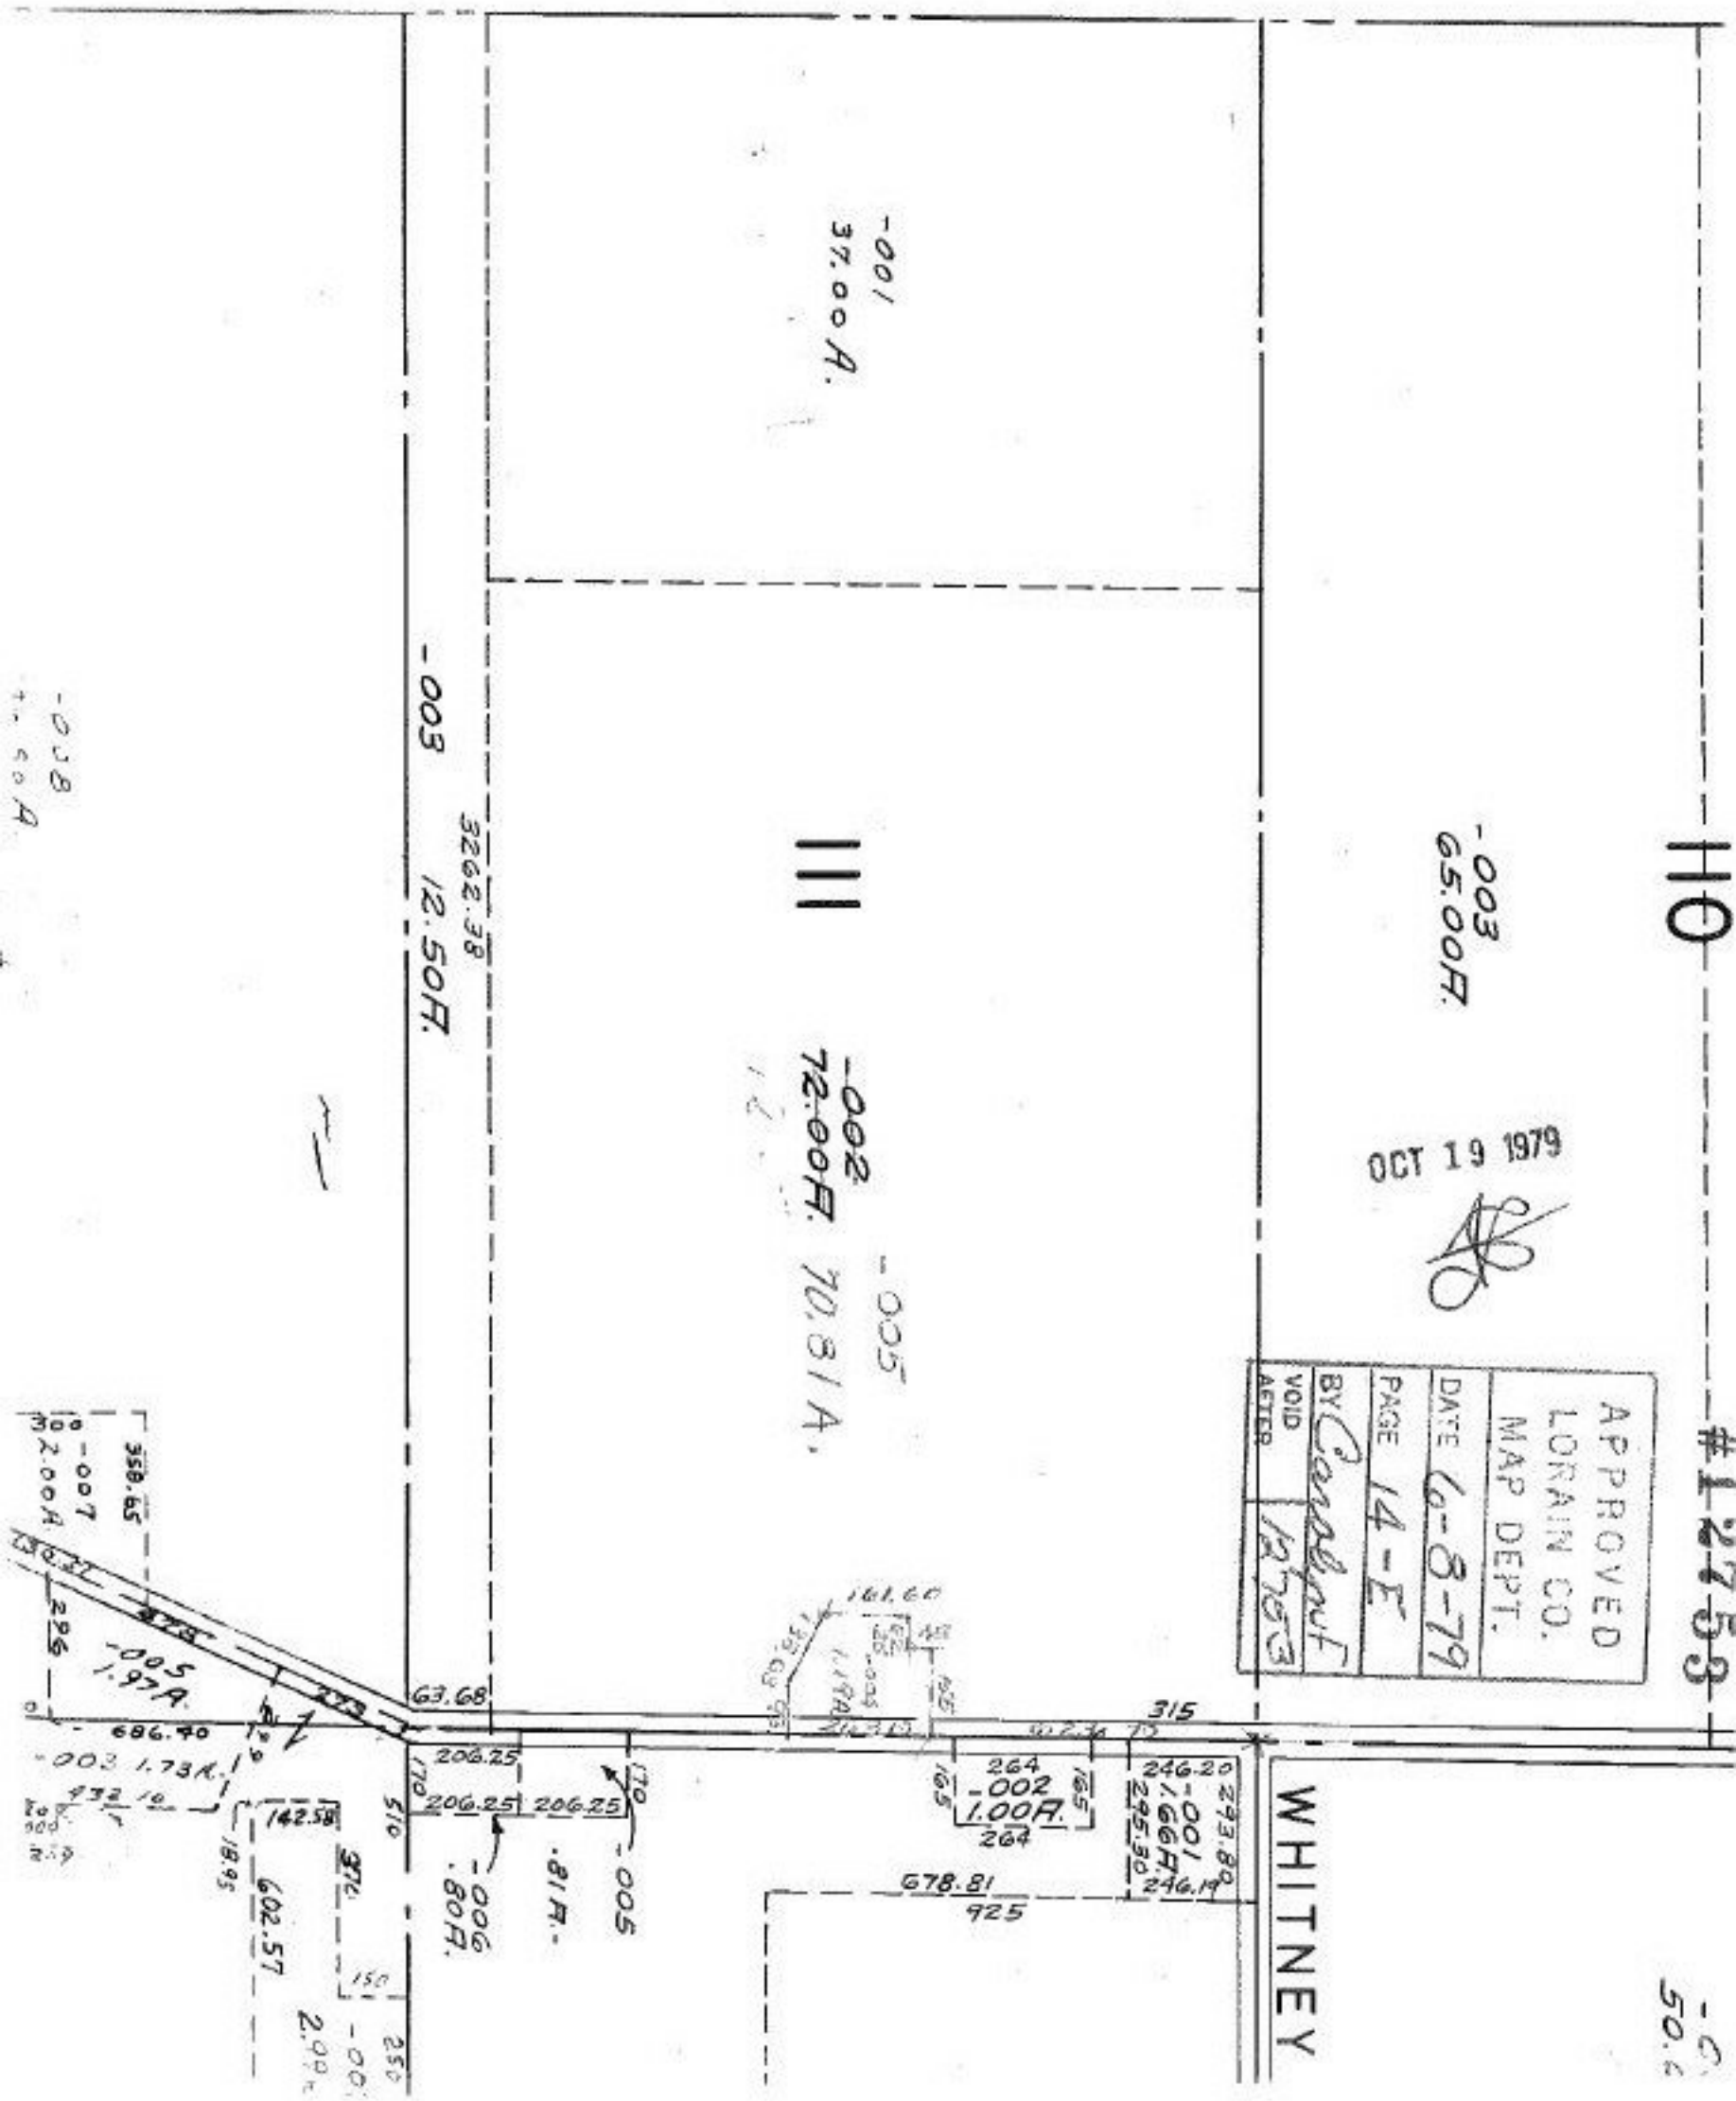

OCT 19 1979

APPROVED
LORAIN CO.
MAP DEPT.
DATE 6-8-79
PAGE 14-E
BY Carolyn F
VOID AFTER 12753