#12755

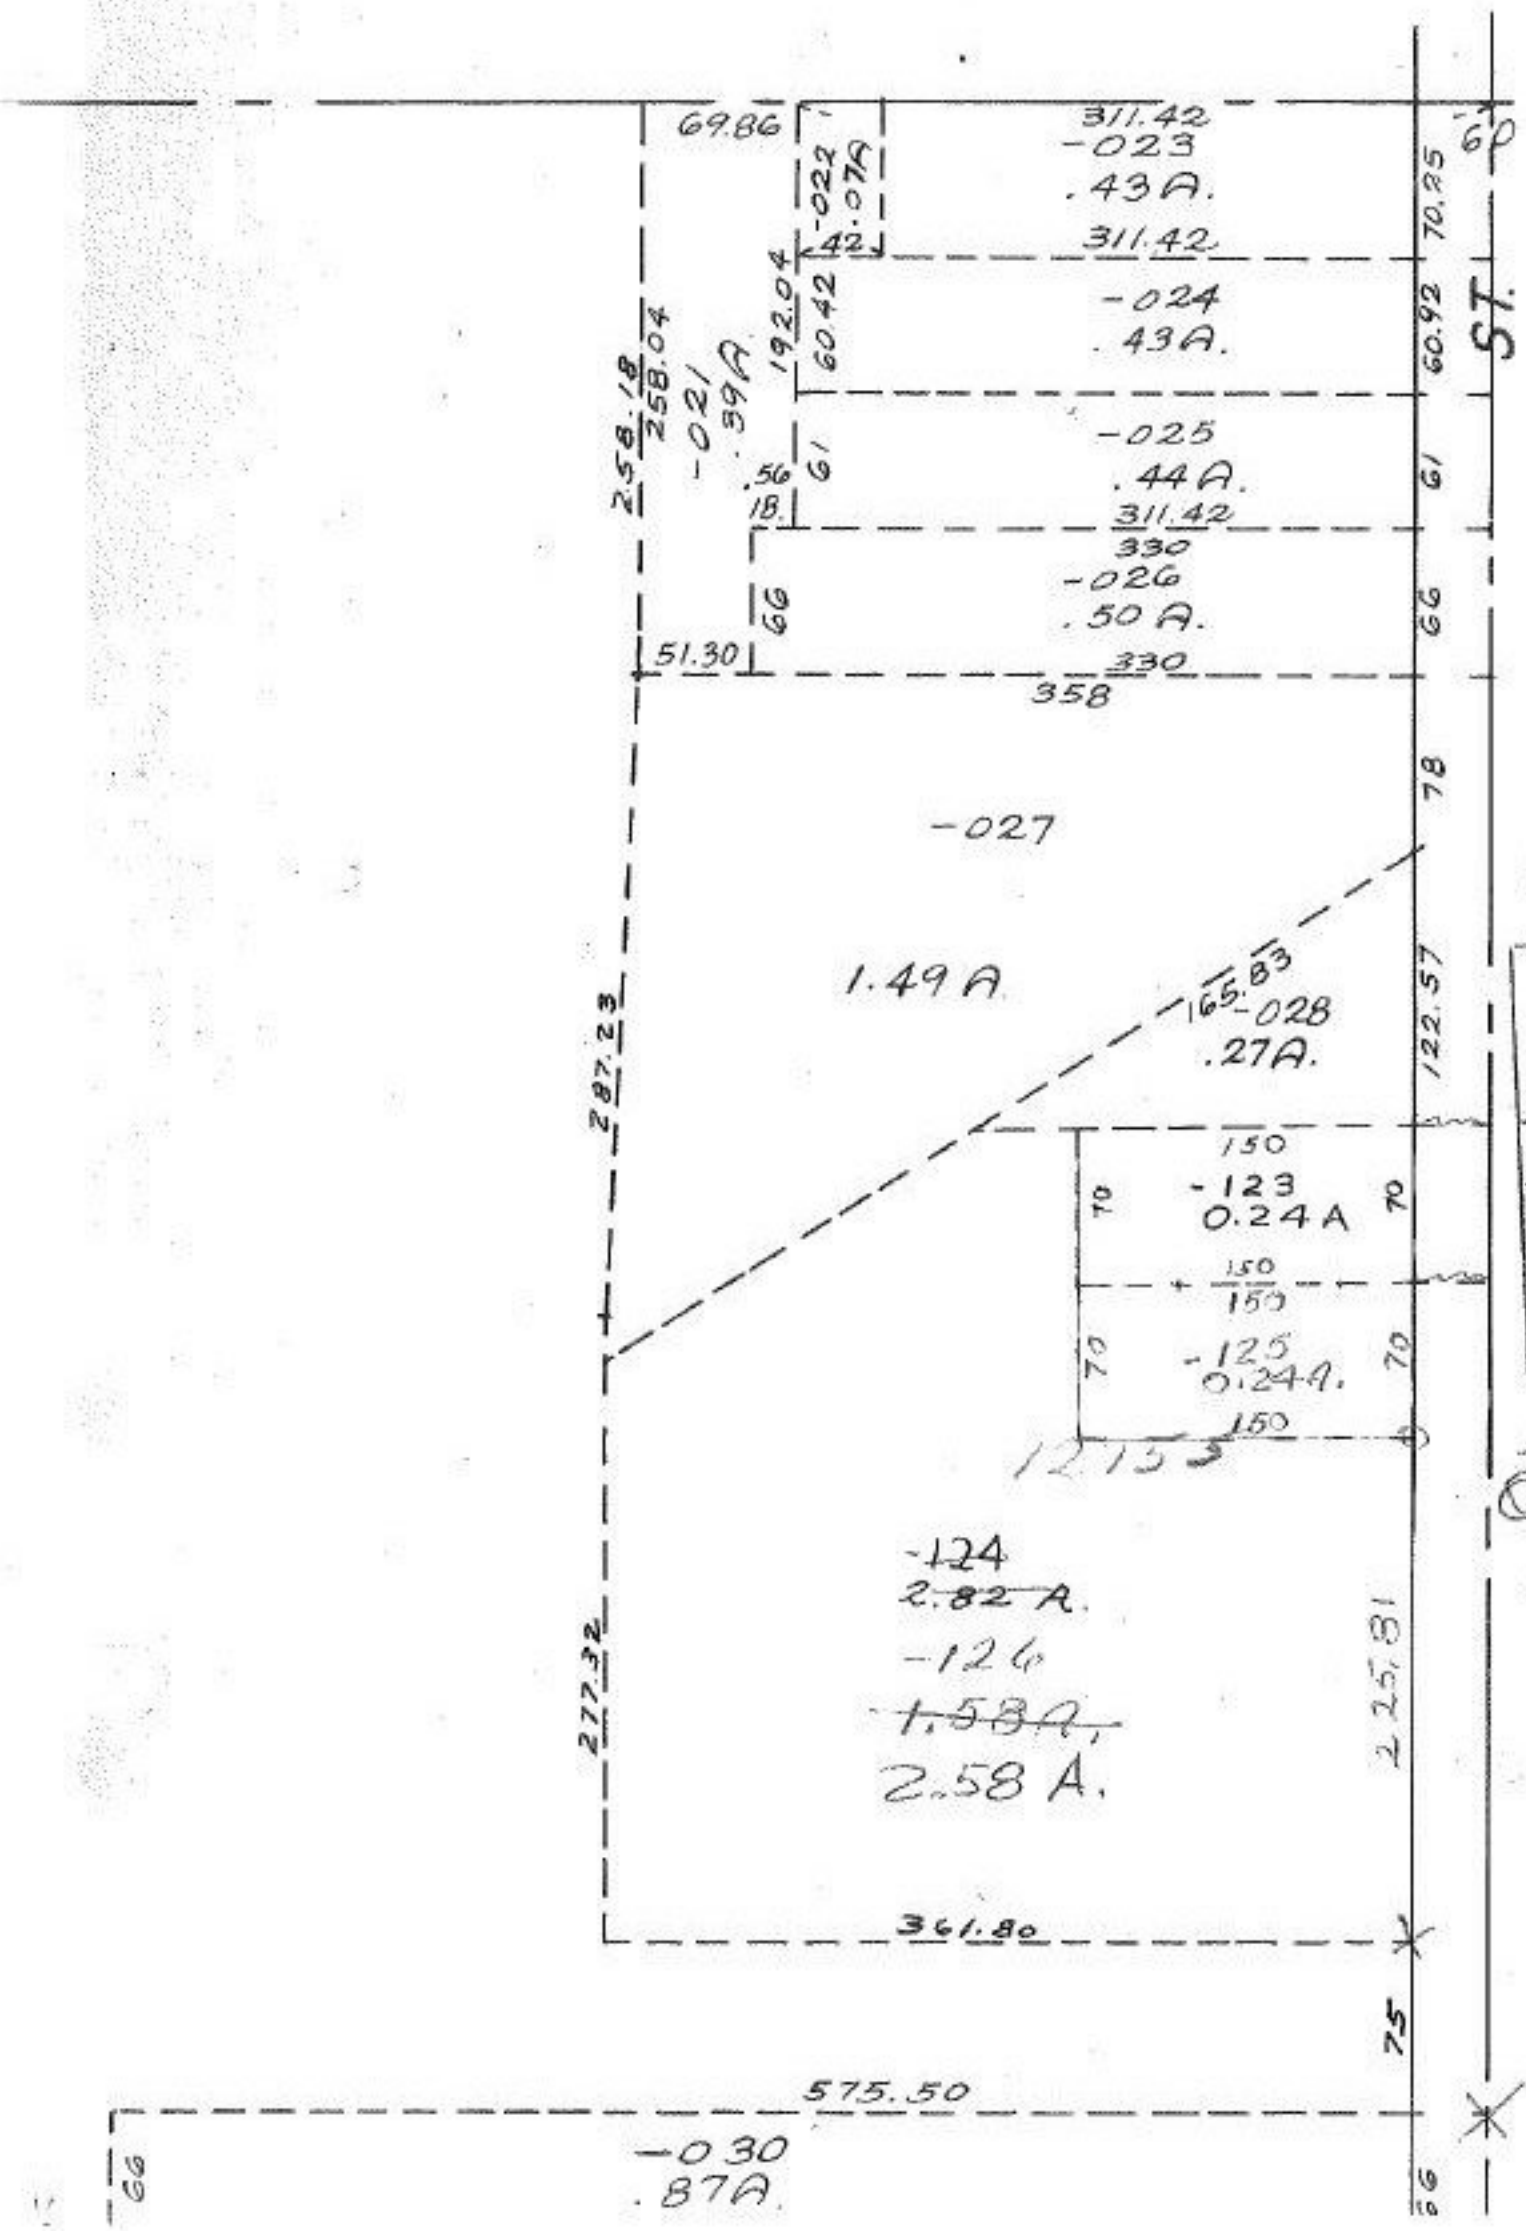

#12755

APPROVED
LORAIN CO.
MAP DEPT.
DATE 6-1-79
PAGE 18-00-022
BY Carolyn F
VOID AFTER 12755

OCT 13 1979

OCT 13 1979