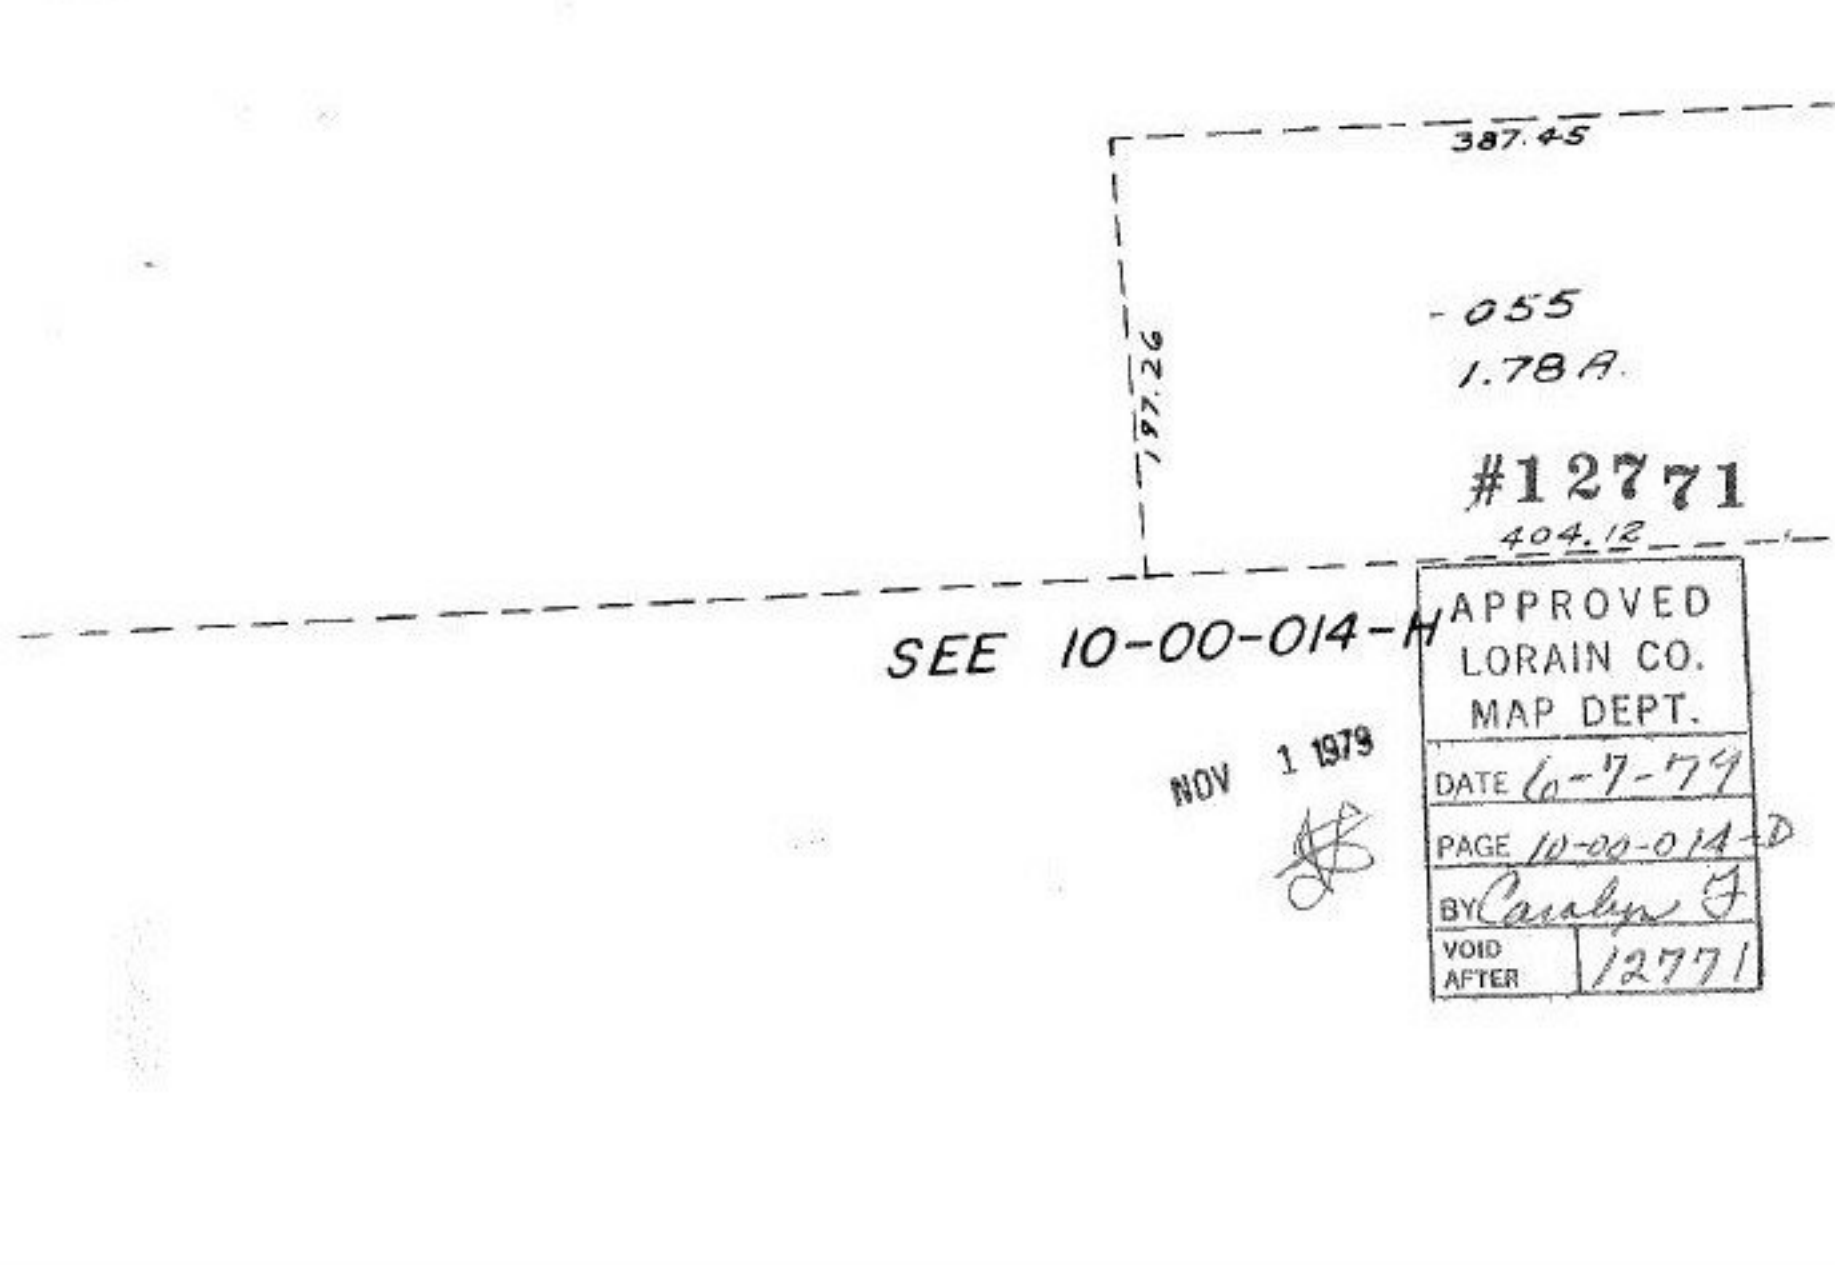~~112~~ -127
~~38 68 A~~ 38.22 A.