#12776

6-104

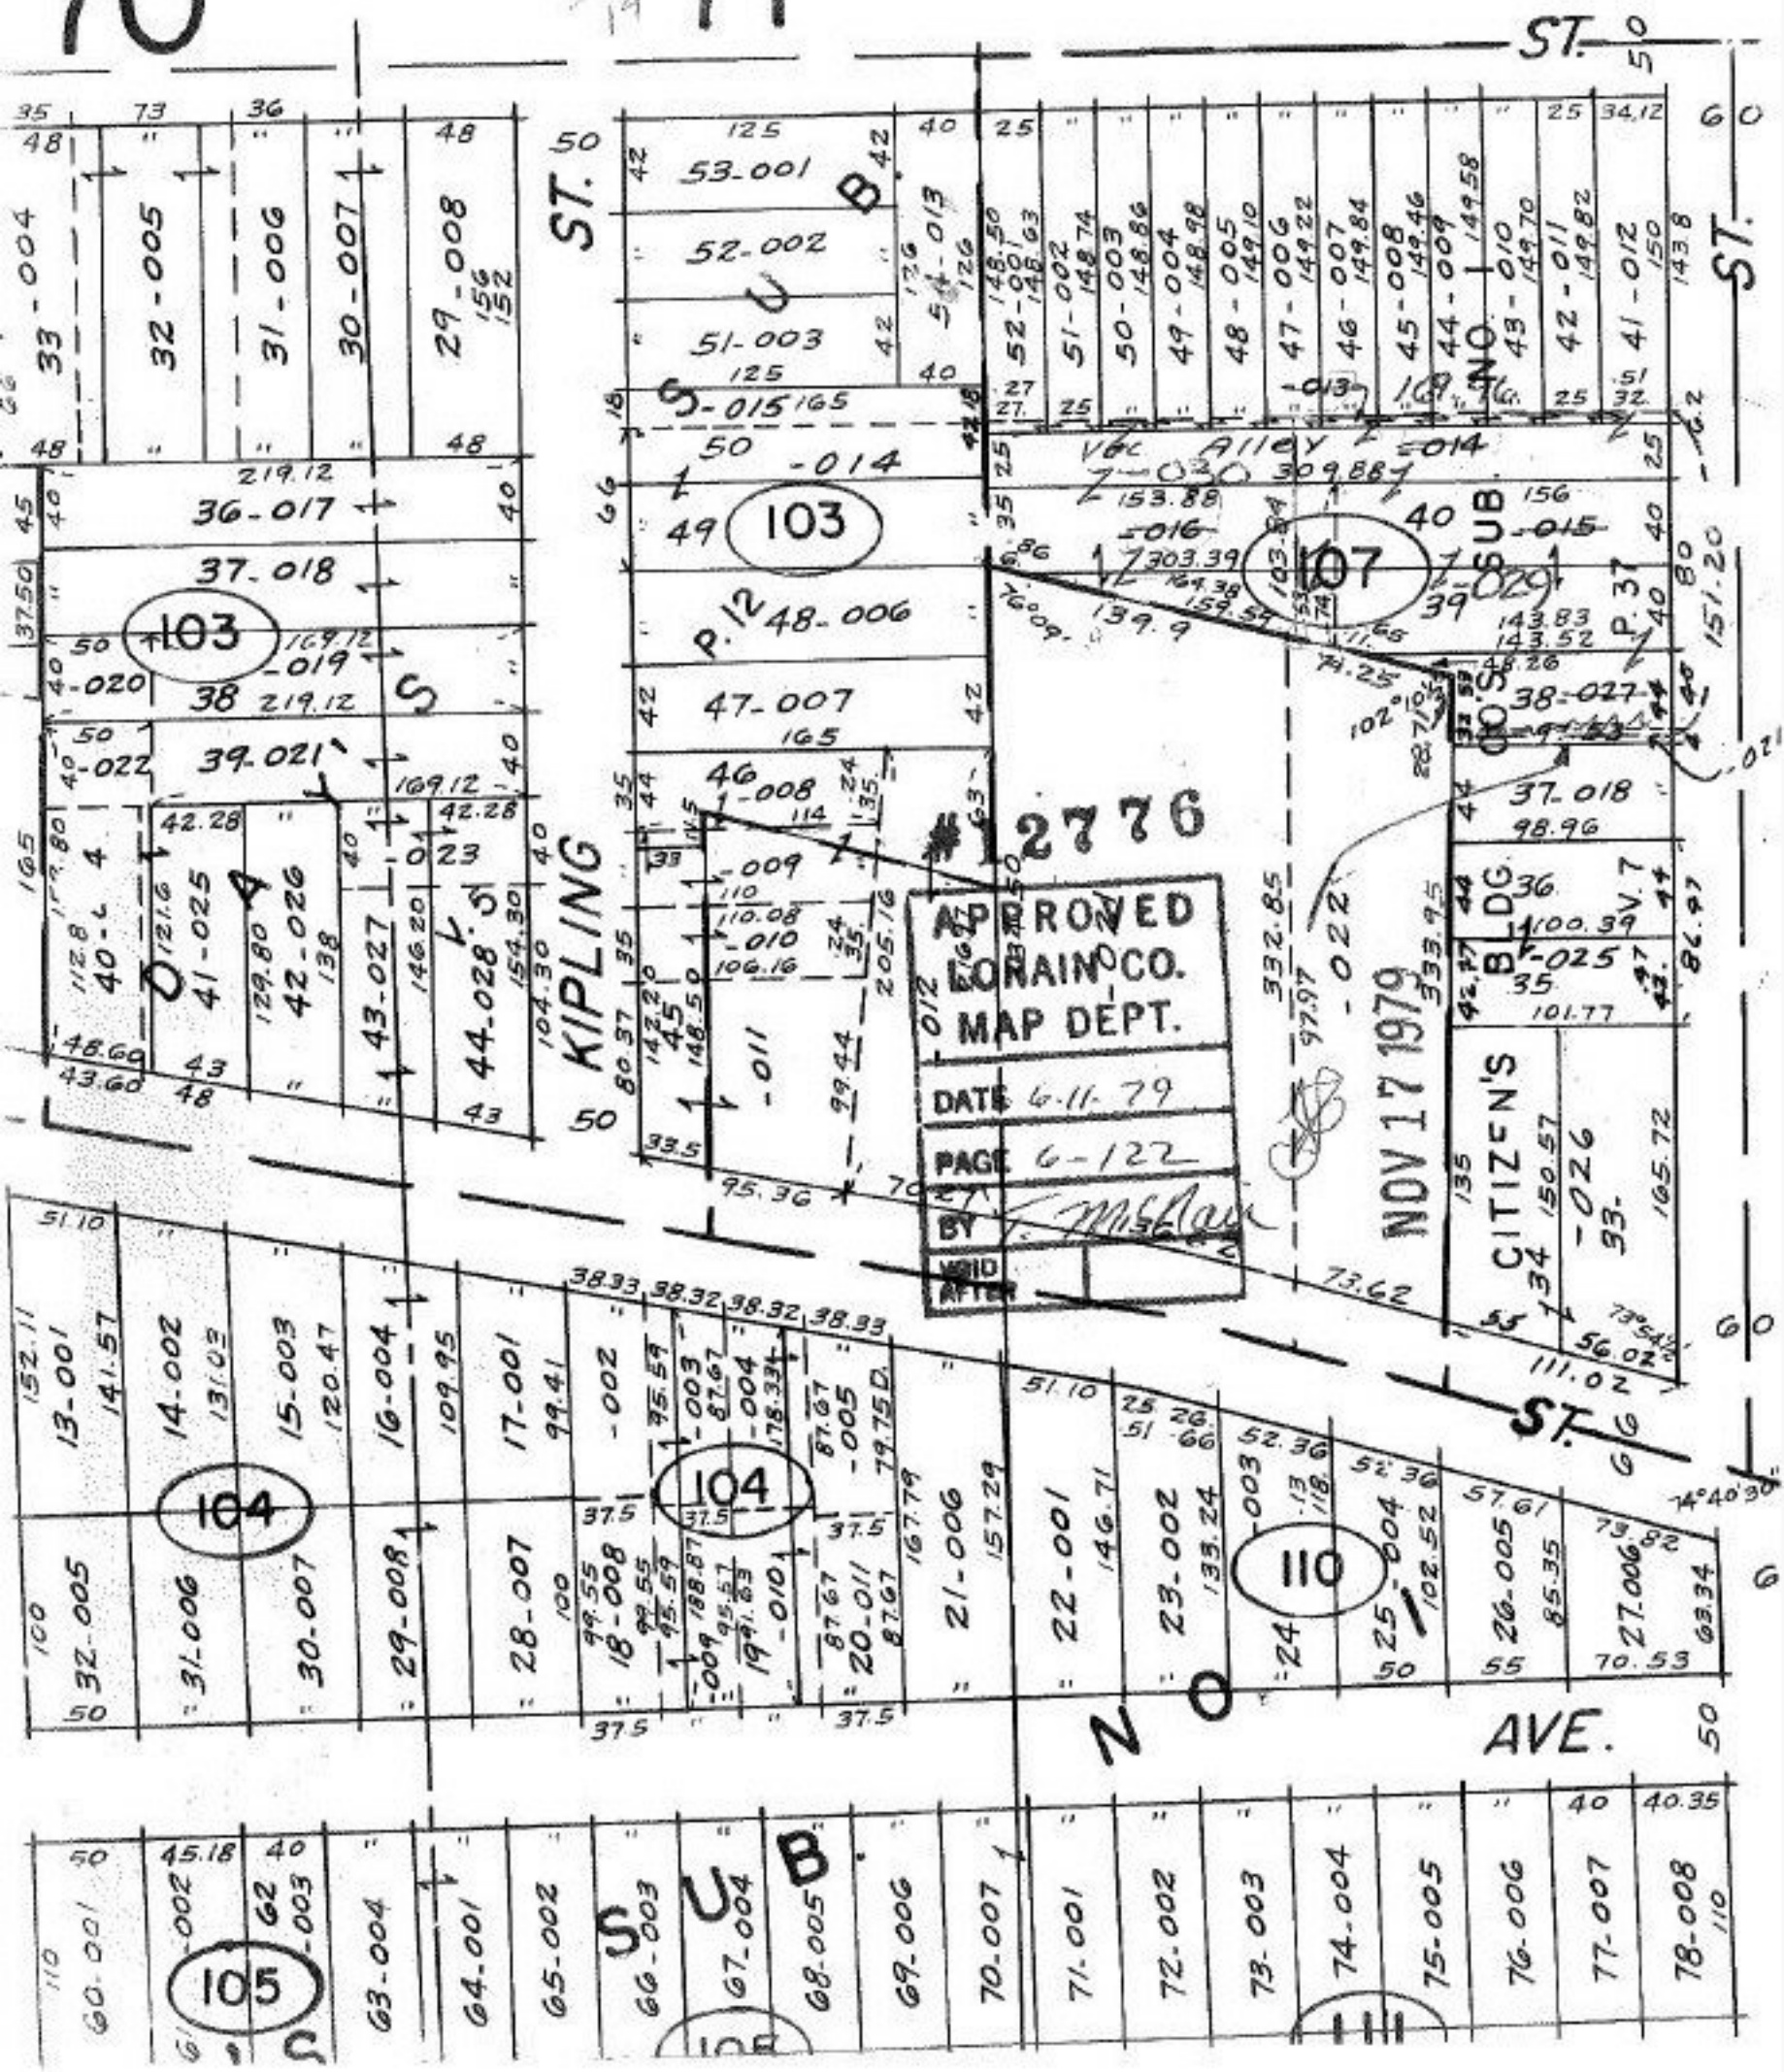

70
71
ST.
KIPLING
AVE.
SUB
103
104
105
107
110
111
Vac Alley
CITIZEN'S
BLDG.
#12776
APPROVED
LORAIN CO.
MAP DEPT.
DATE 6-11-79
PAGE 6-122
BY
VOID
AFTER
NOV 17 1979