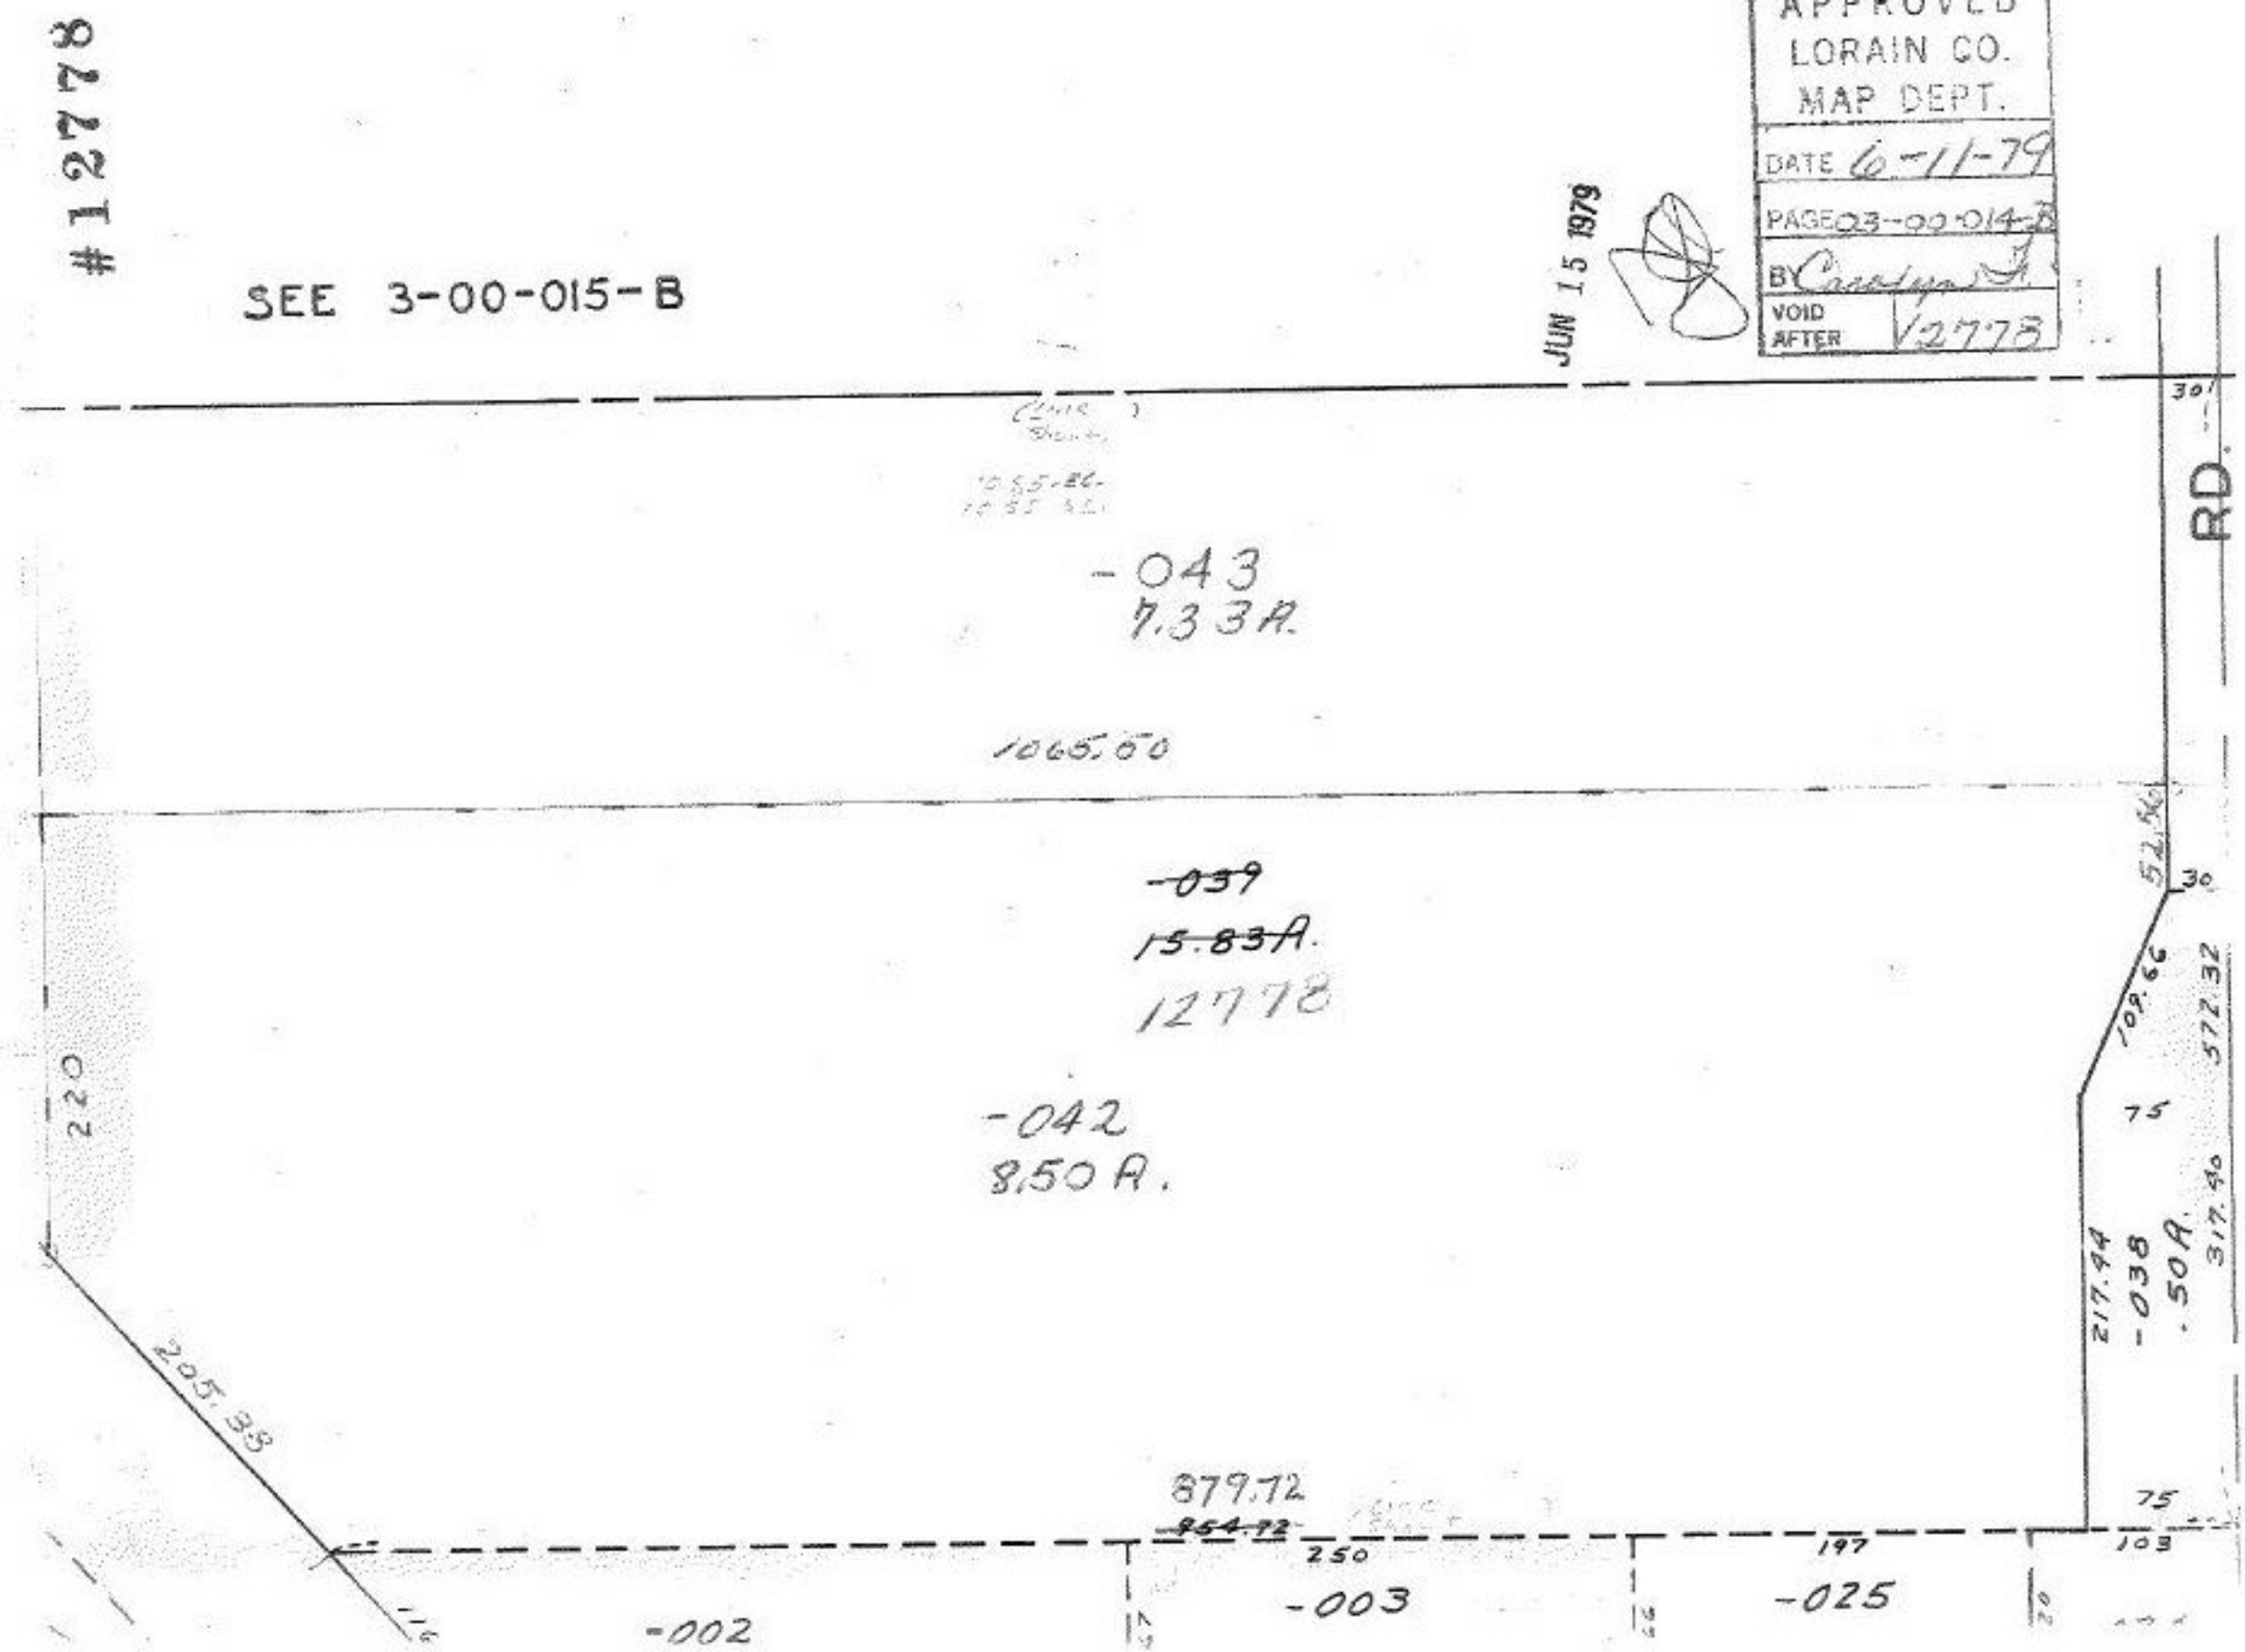

#12778
SEE 3-00-015-B
JUN 15 1979
APPROVED
LORAIN CO.
MAP DEPT.
DATE 6-11-79
PAGE 03-00-014-B
BY Carolyn
VOID AFTER 12778
-043
7.33A.
1065.50
~~-039~~
~~15.83A.~~
12778
-042
8.50 A.
220
205.38
879.72
~~854.72~~
250
197
103
75
75
30
30
52.56
109.66
572.32
317.40
217.44
-038
.50A.
-002
-003
-025
RD.