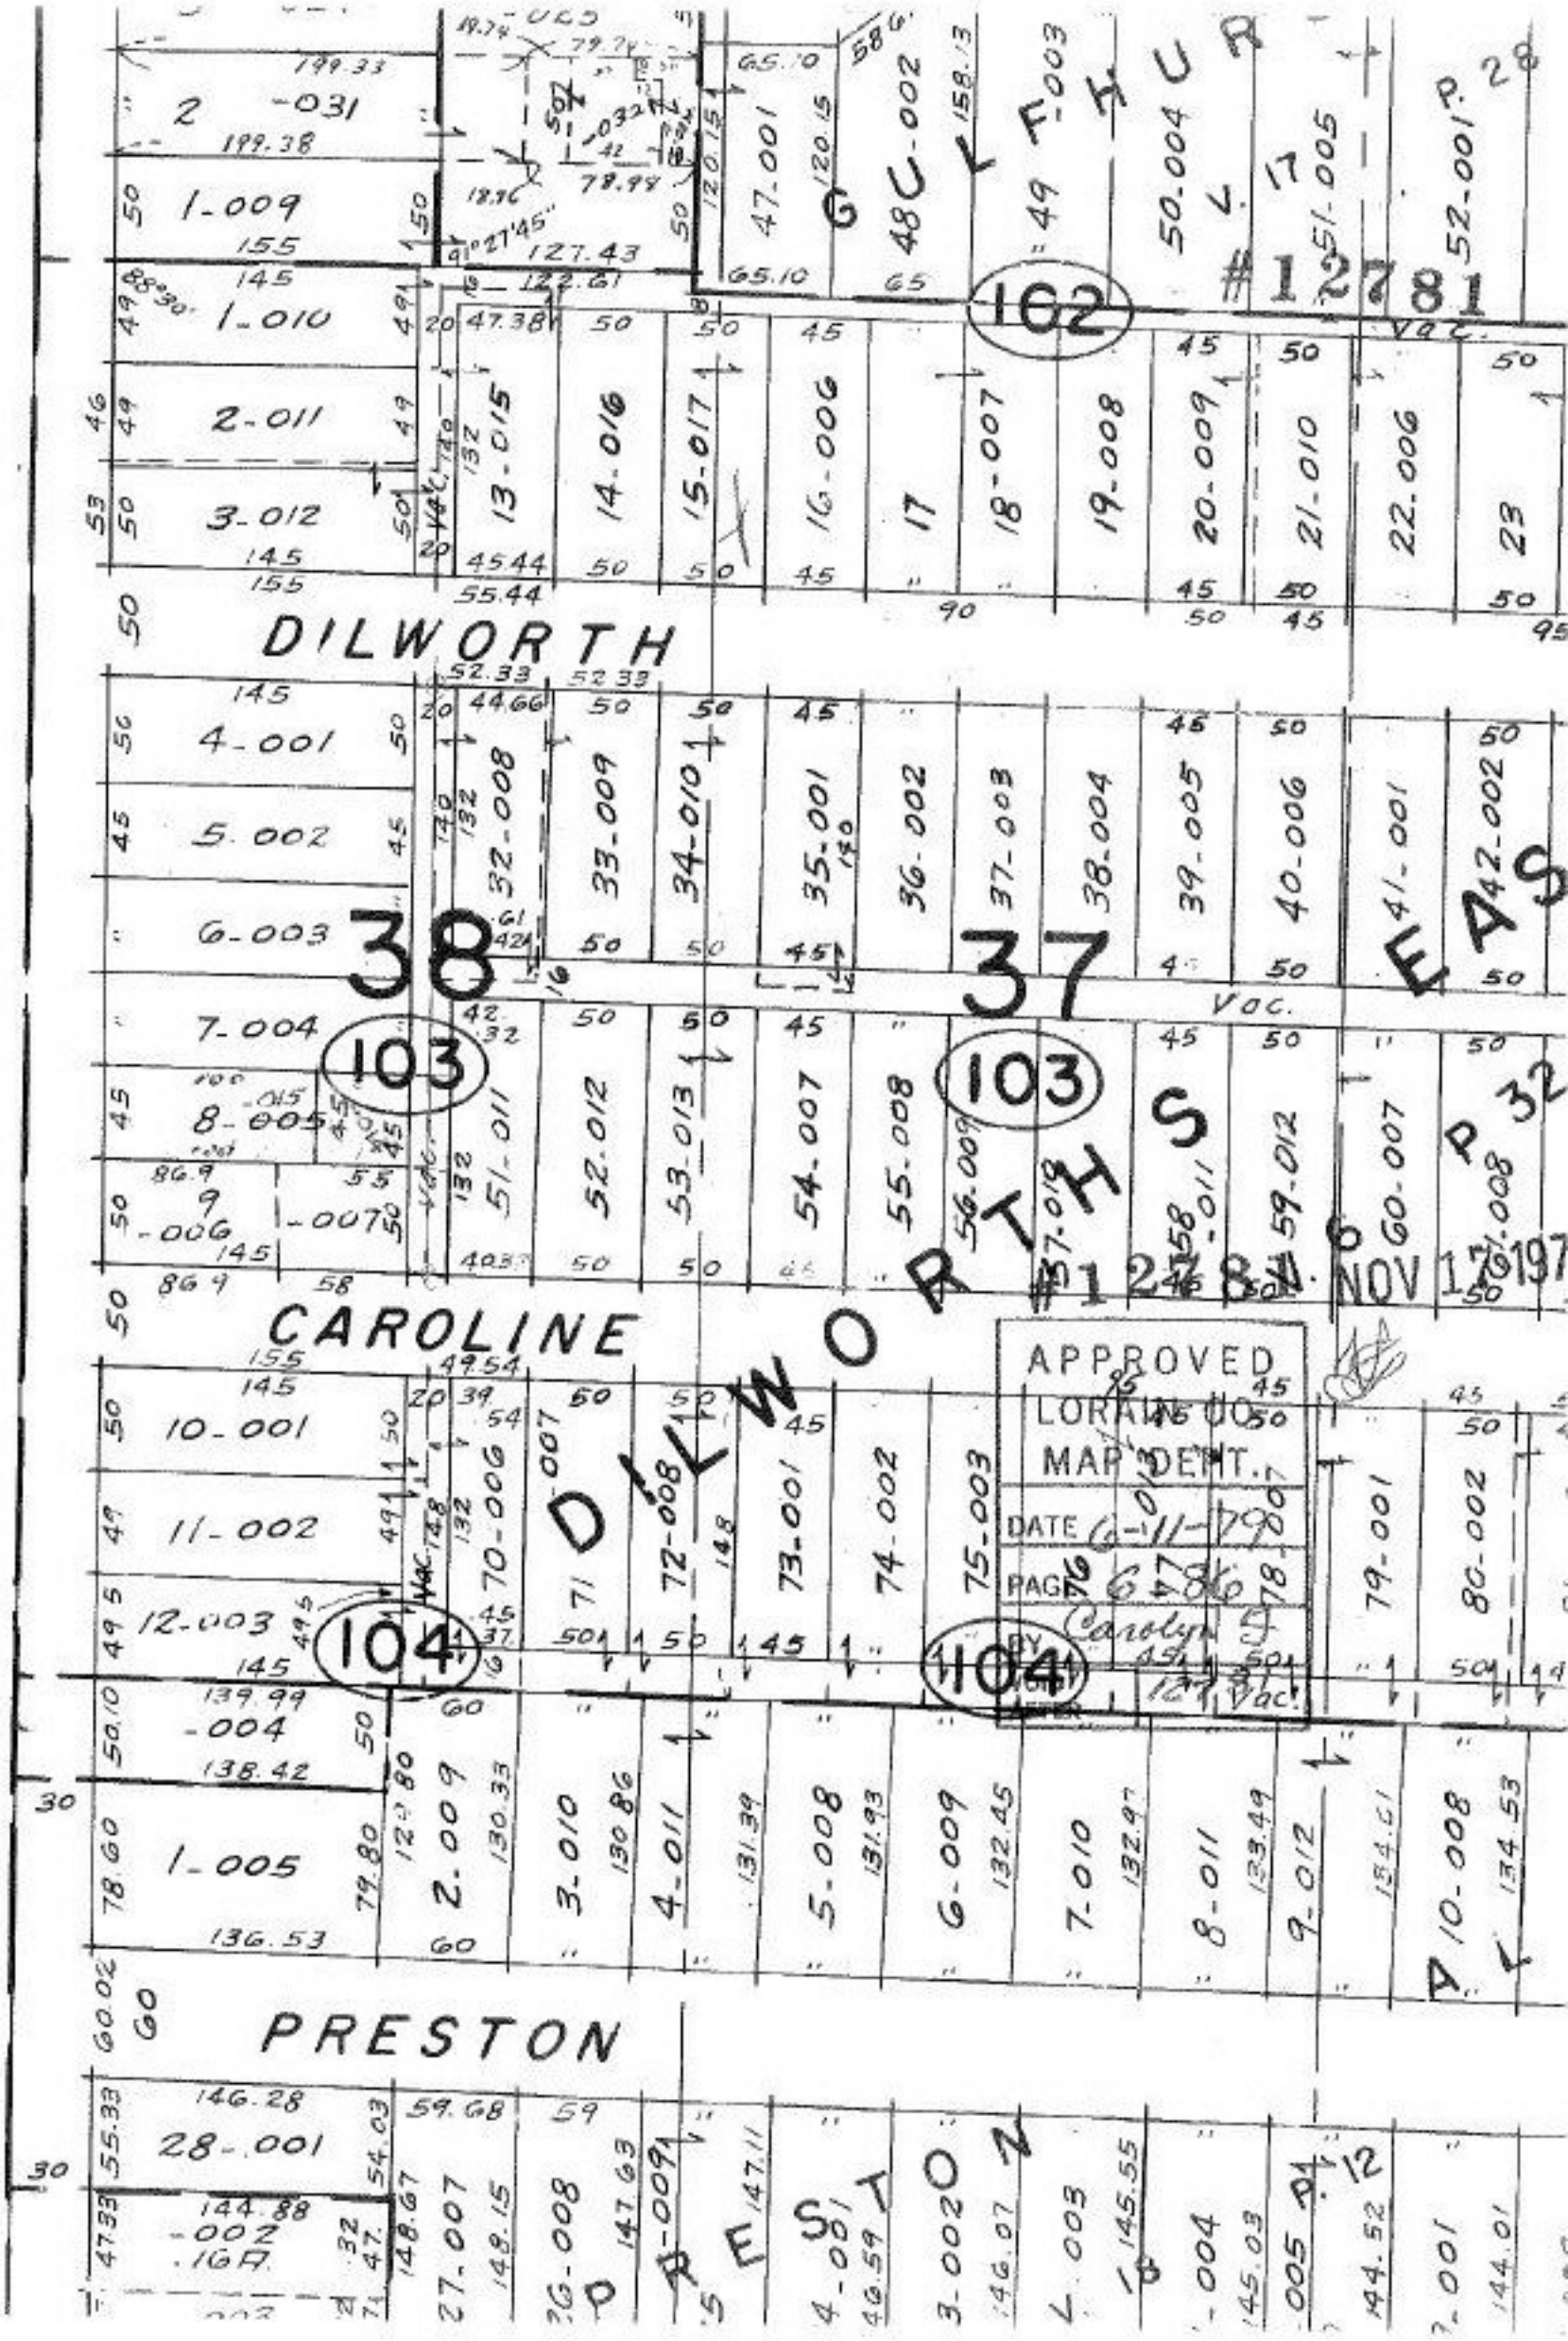

DILWORTH
CAROLINE
PRESTON
GULF HUR
#12781
#12781 NOV 17 197
102
103
104
38
37
EAS
DILWORTH
PRESTON
APPROVED
LORAIN CO.
MAP DEPT.
DATE 6-11-79
PAGE 6-86
BY Carolyn