

#12807

APPROVED
LORAIN CO.
MAP DEPT.
DATE 6-20-79
PAGE 1A-A
BY T. McVain
VOID AFTER

OCT 19 1979

117.50A

SEE ALSO 12517

1126.12

3.39 AC

(120' Variable)

3272.28

448.79

471.25

75175/125

1636.8

5.16A

1.84A

7.77A

0.02

0.03

1.21A

0.04

1.17A






























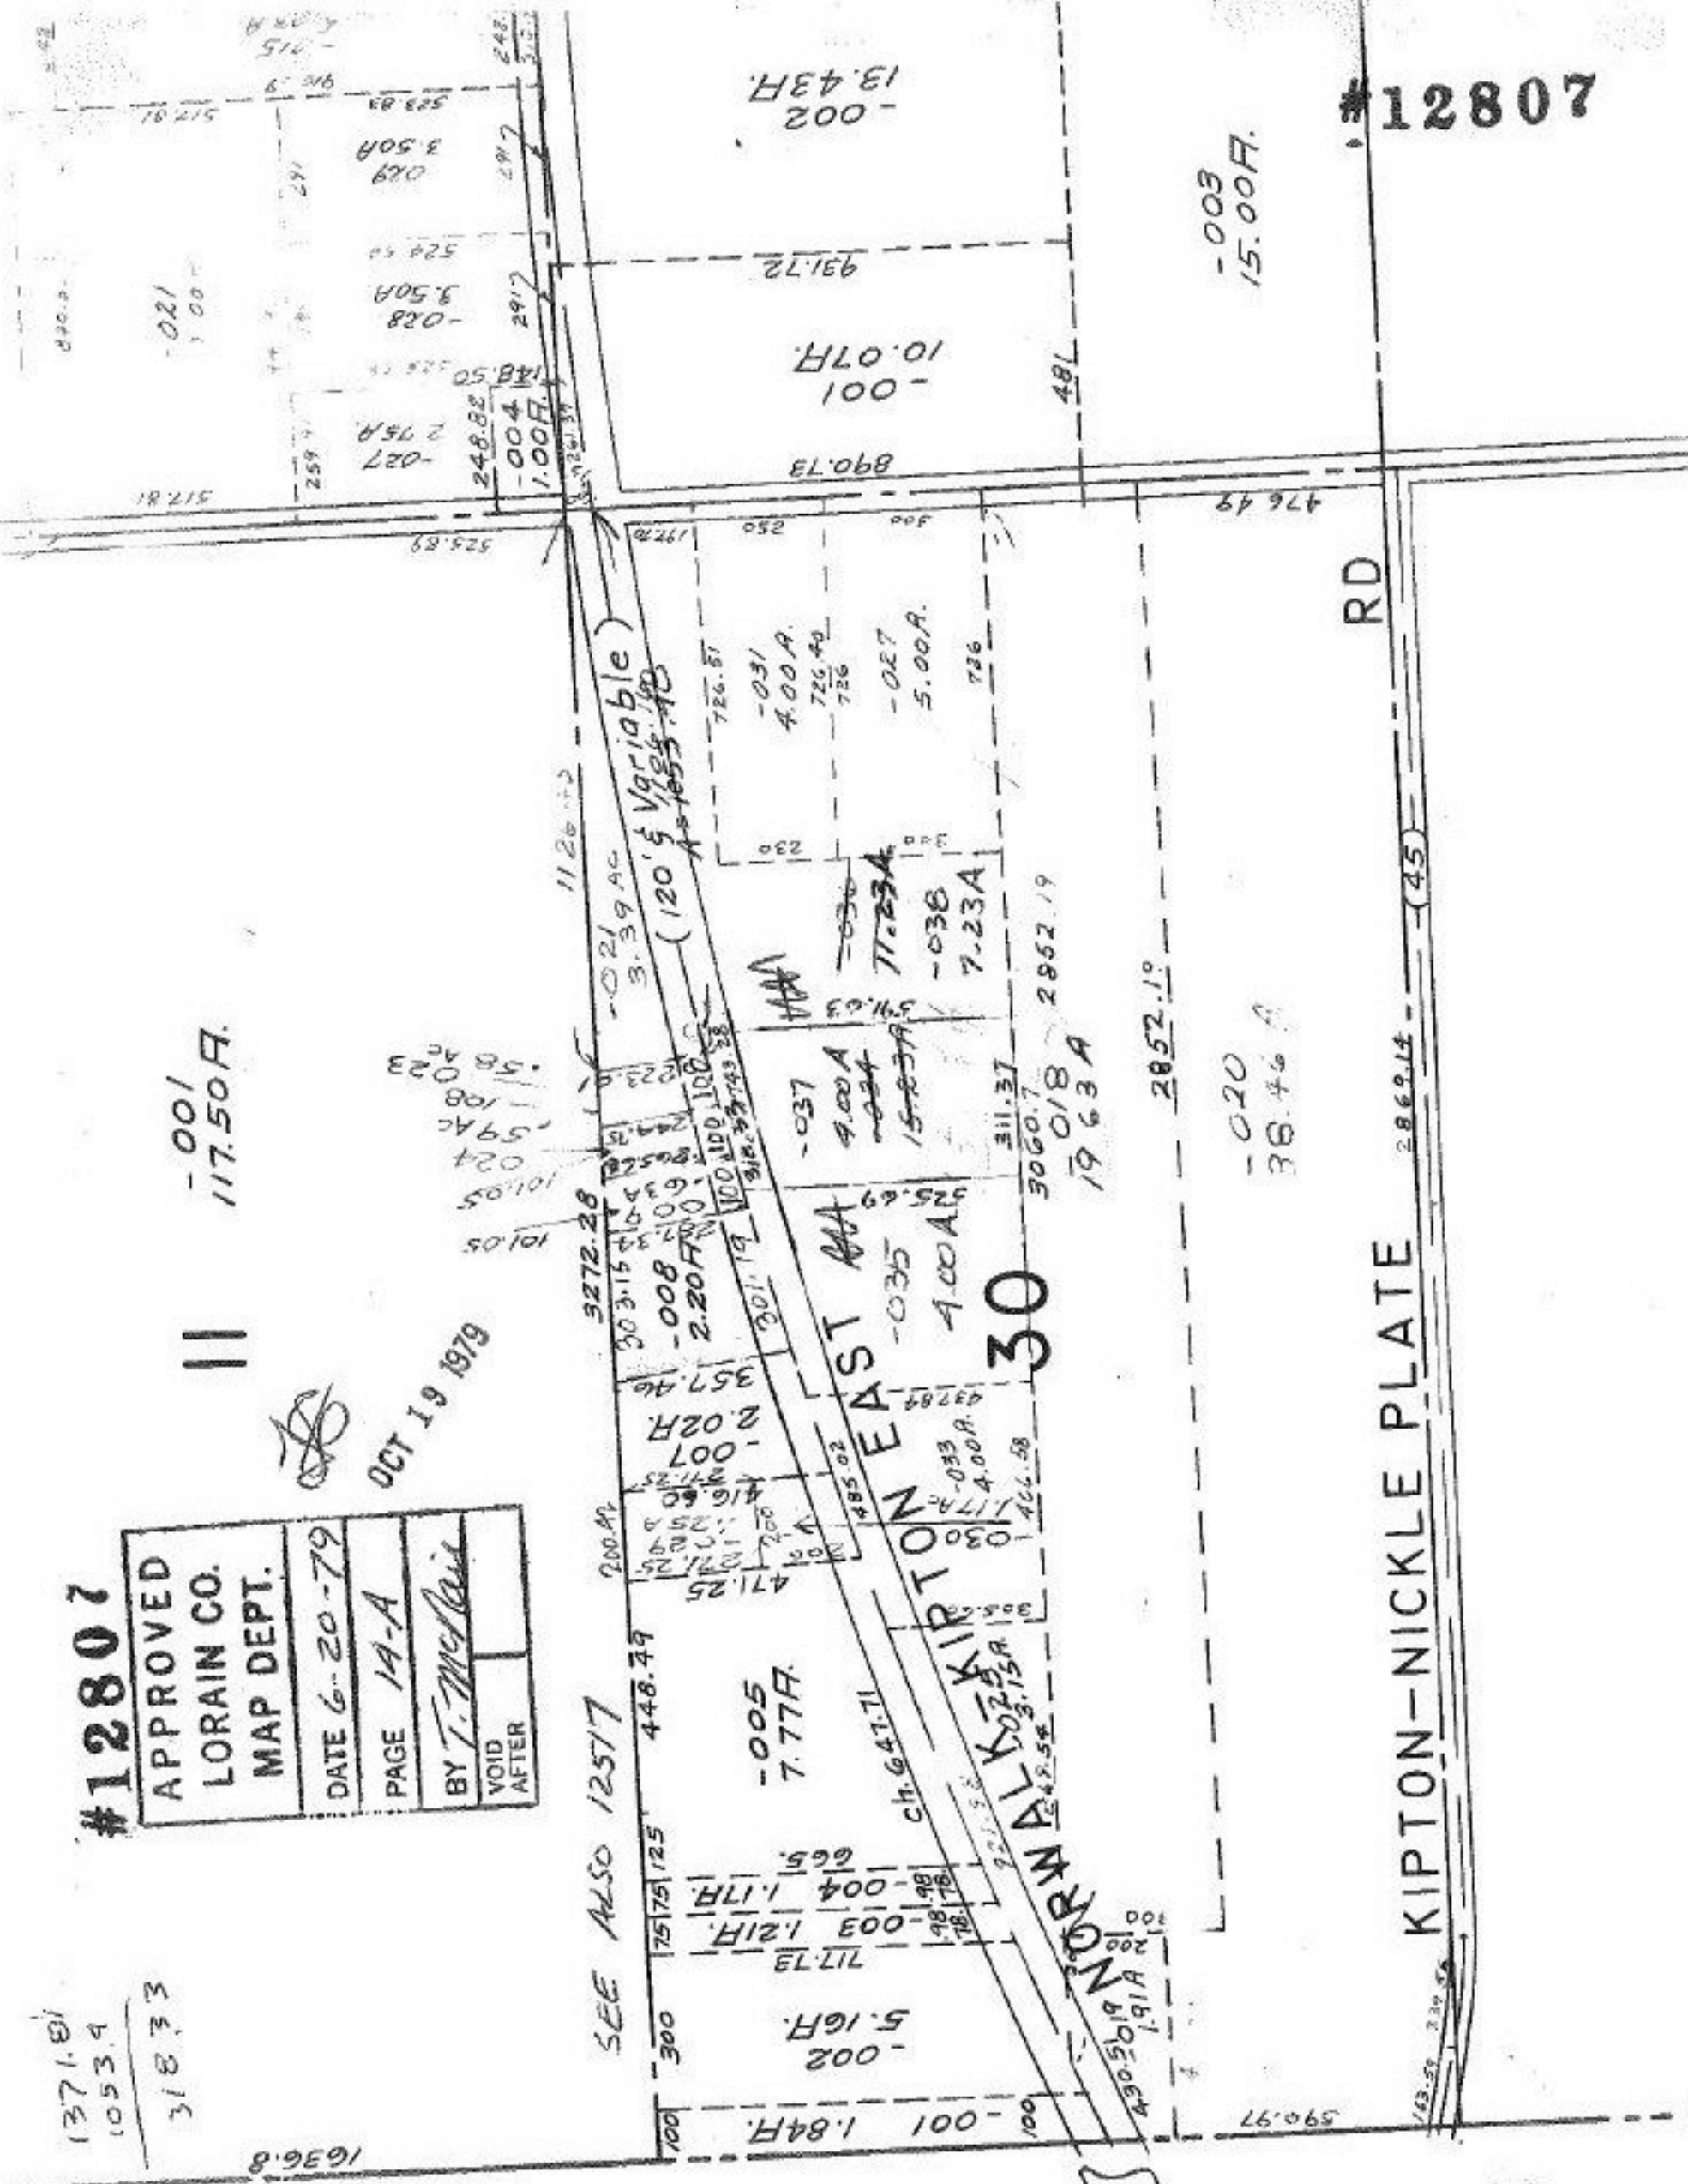

#12807

RD

KIPTON-NICKLE PLATE

(45)

2869.14

15.00A

38.46 A

2852.19

2852.19

1963A

30

4.00A

4.00A

4.00A

4.00A



10.07A

890.73

4.00A

5.00A

7.23A

7.23A











13.43A

931.72

197.70

250

300



























































































































































































































