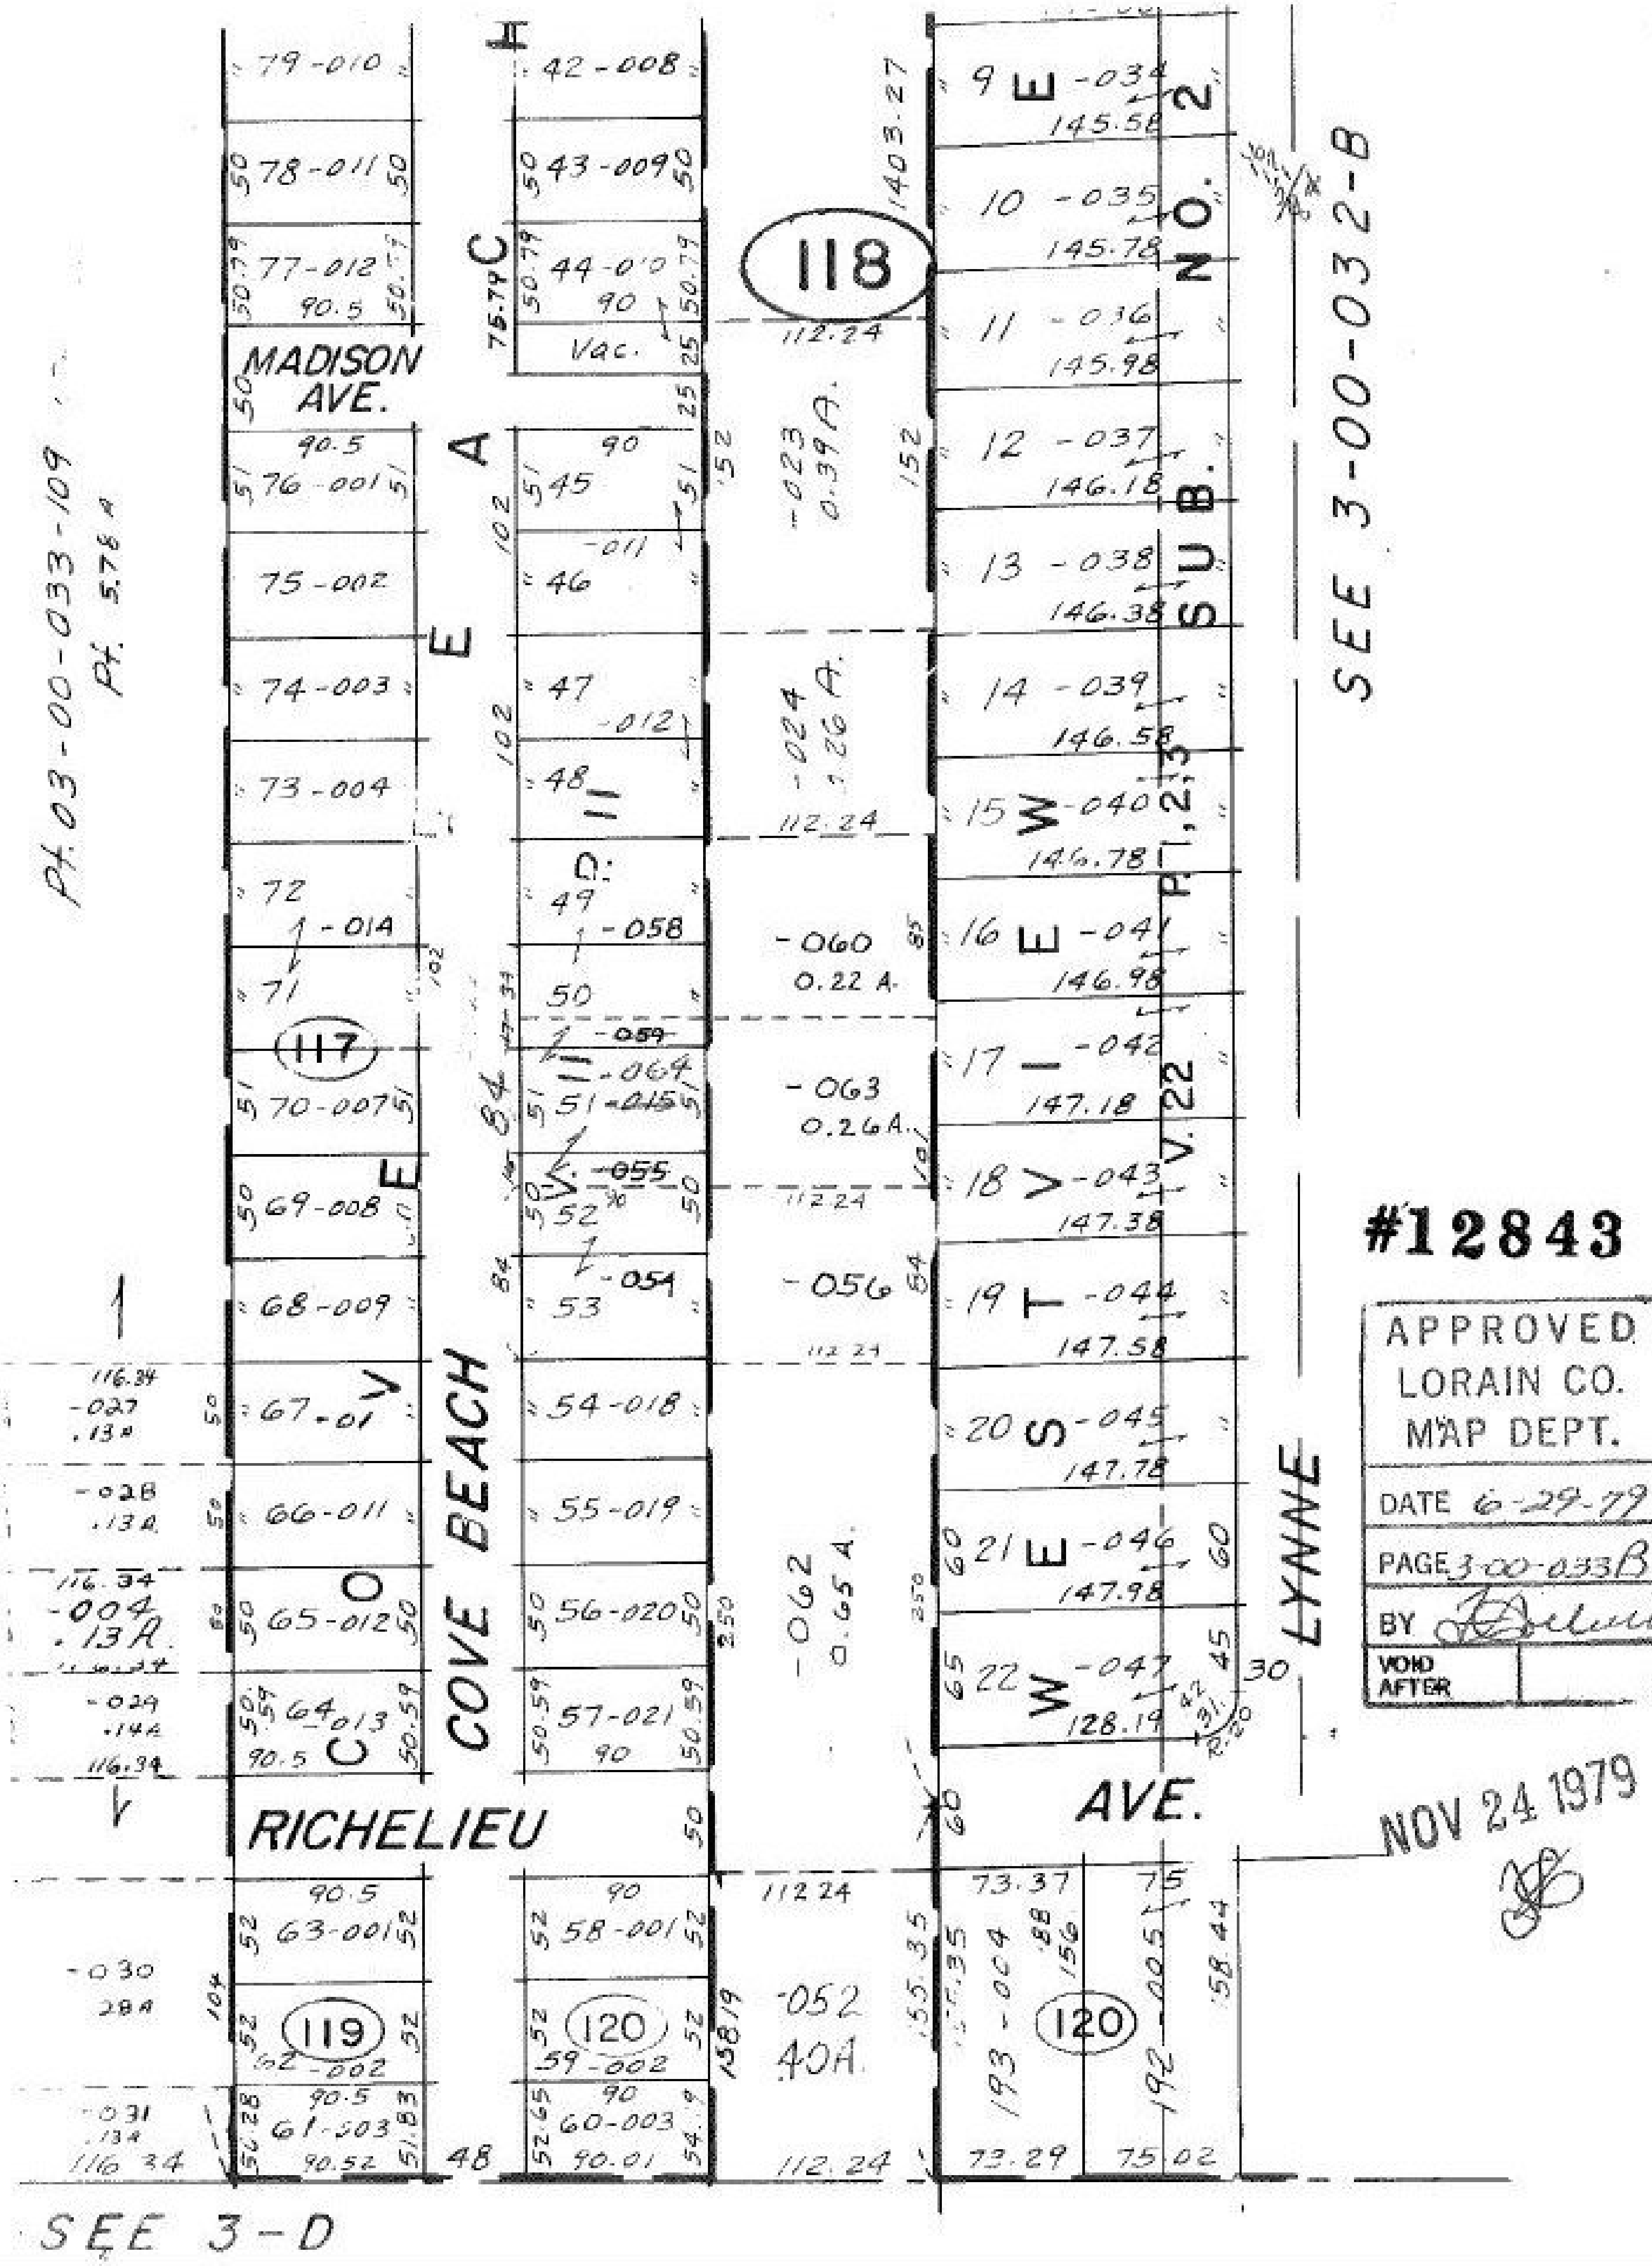

#12843

APPROVED
LORAIN CO.
MAP DEPT.

DATE 6-29-79

PAGE 3-00-033B

BY [signature]

VOID AFTER

NOV 24 1979