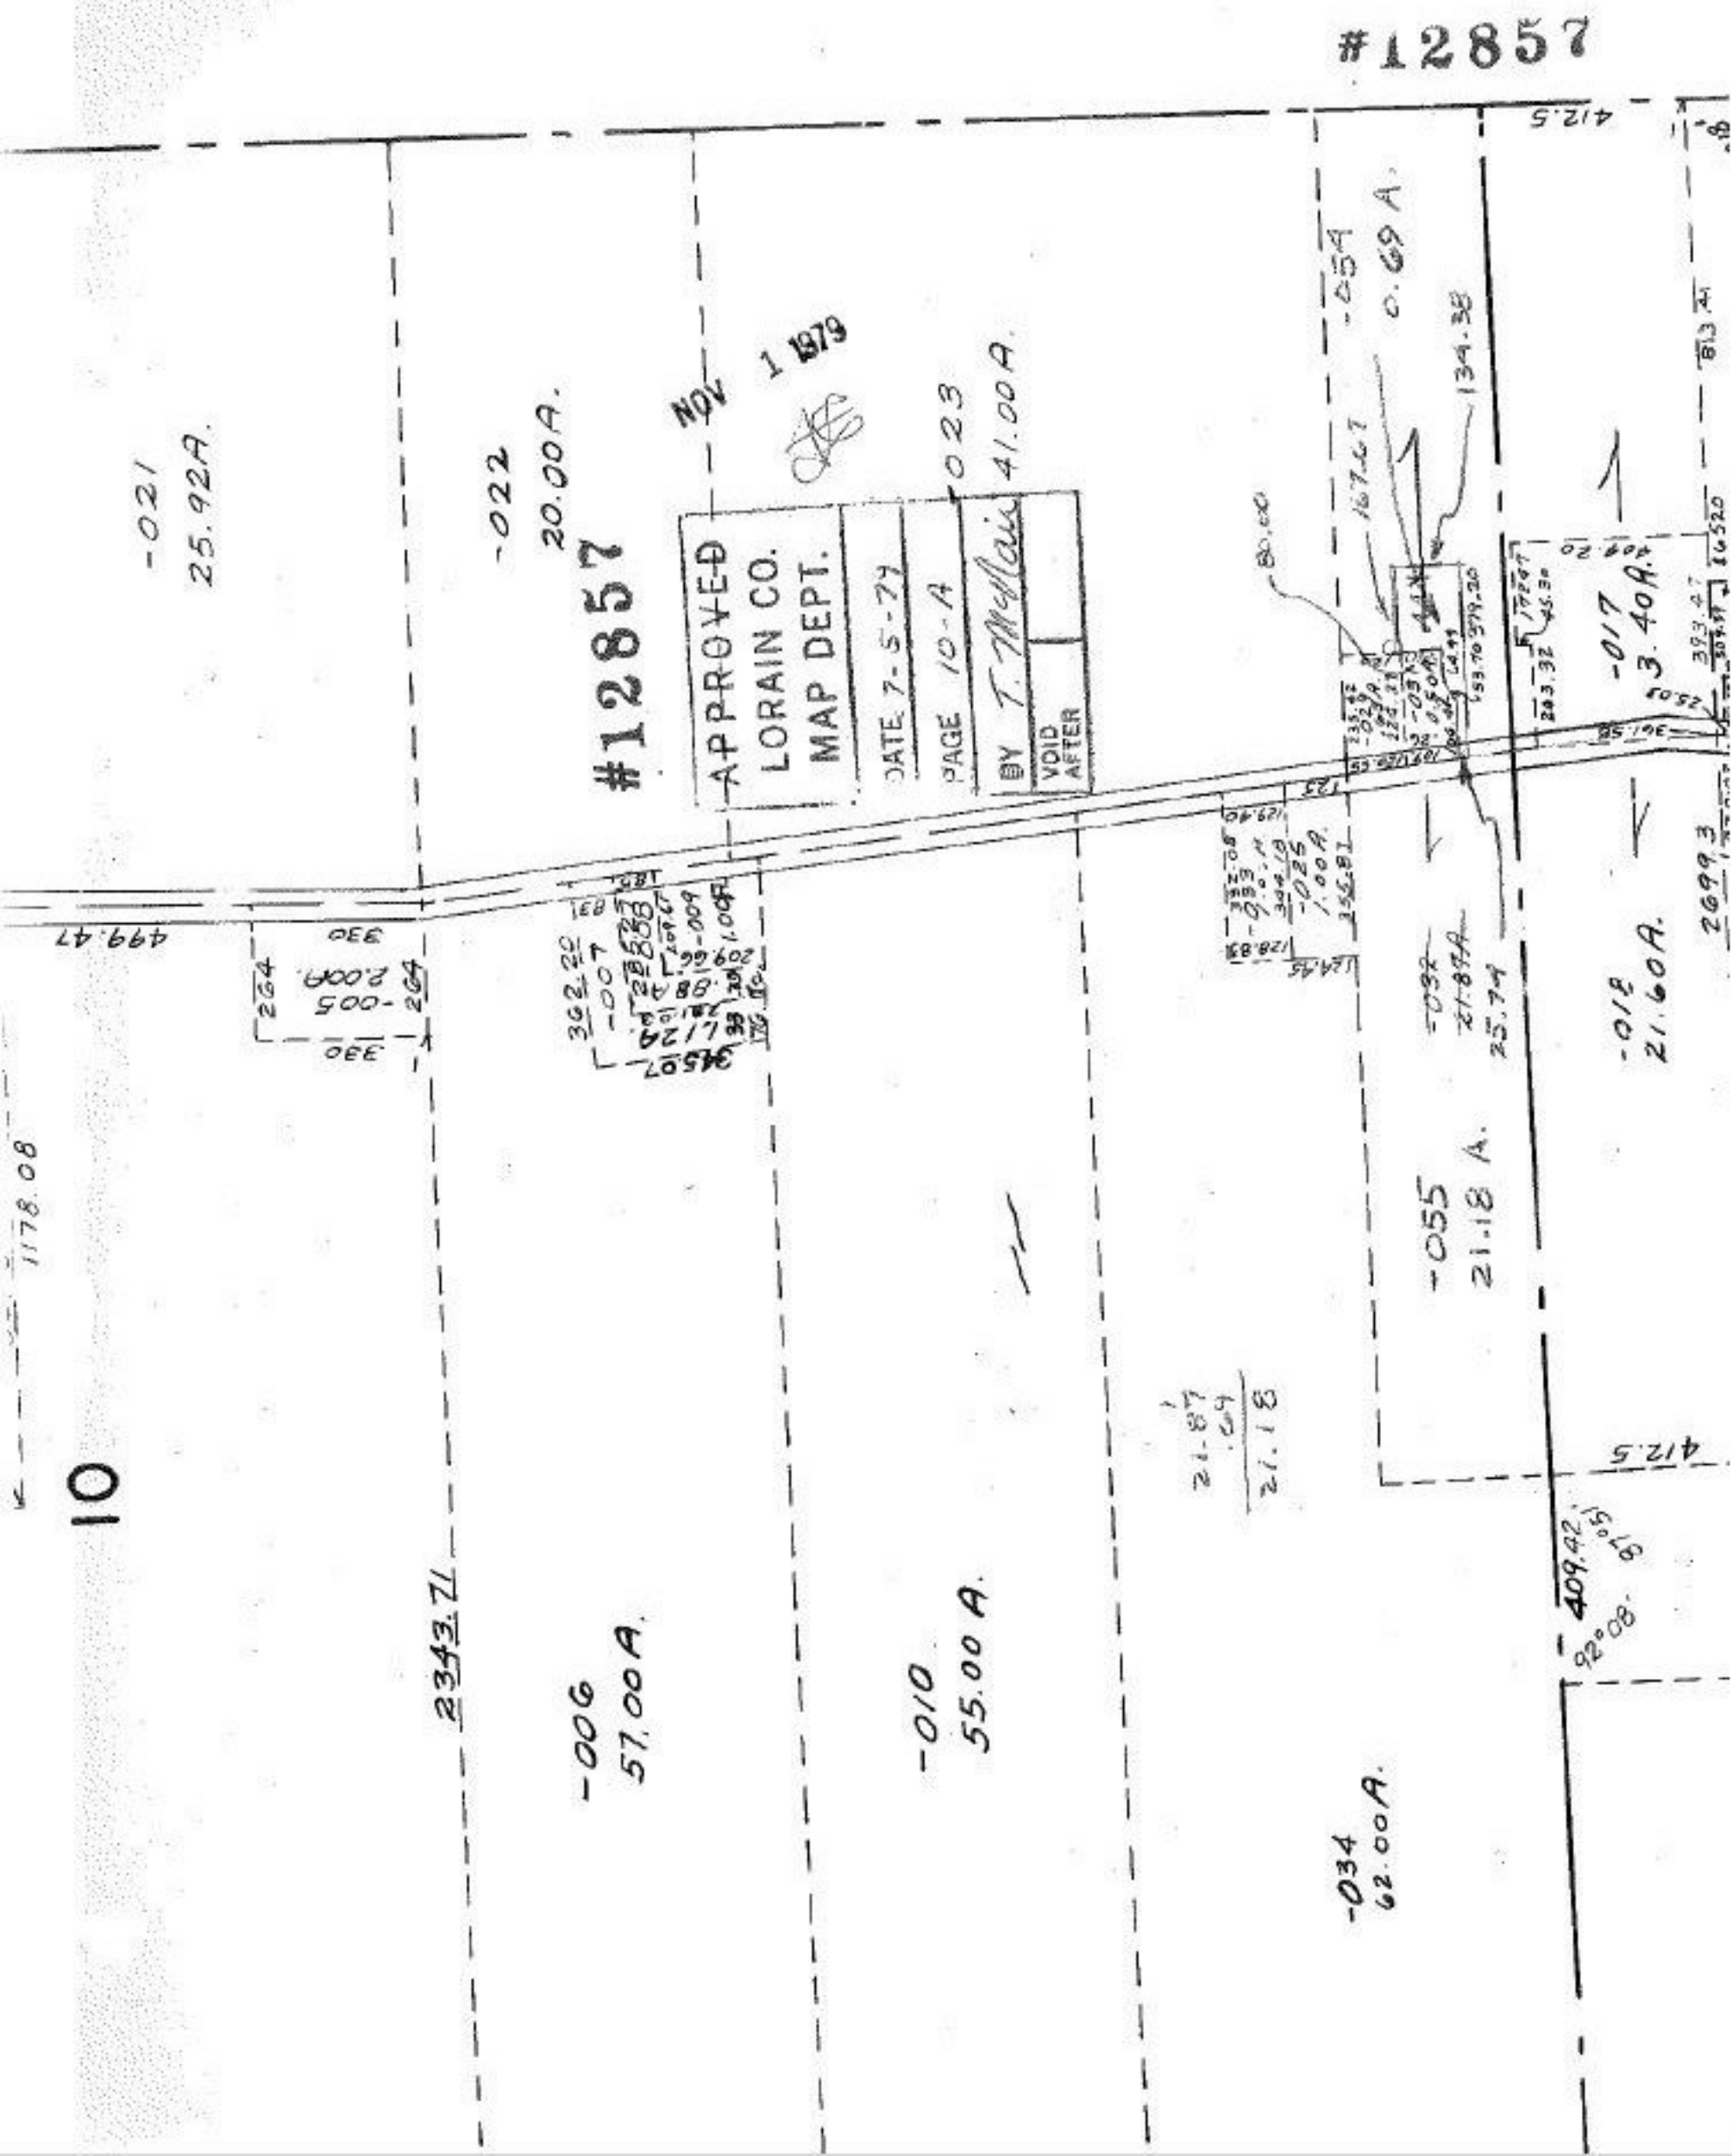
#12857
NOV 1 1979
#12857
APPROVED
LORAIN CO.
MAP DEPT.
DATE 7-5-79
PAGE 10-A
BY T. McMain
VOID AFTER
-021
25.92A.
-022
20.00A.
-023
41.00A.
-054
0.69 A.
-017
3.40A.
-018
21.60A.
-055
21.18 A.
-034
62.00A.
-010
55.00 A.
-006
57.00A.
2343.71
1178.08
499.47
412.5
409.42
92°08'
87°51'
21.87
.69
21.18
-032
21.87A
25.74
-025
1.00A.
-005
2.00A.
264
330
362.20
-007
345.07
-009
1.00A.
80.00
167.67
134.38
2699.3
10