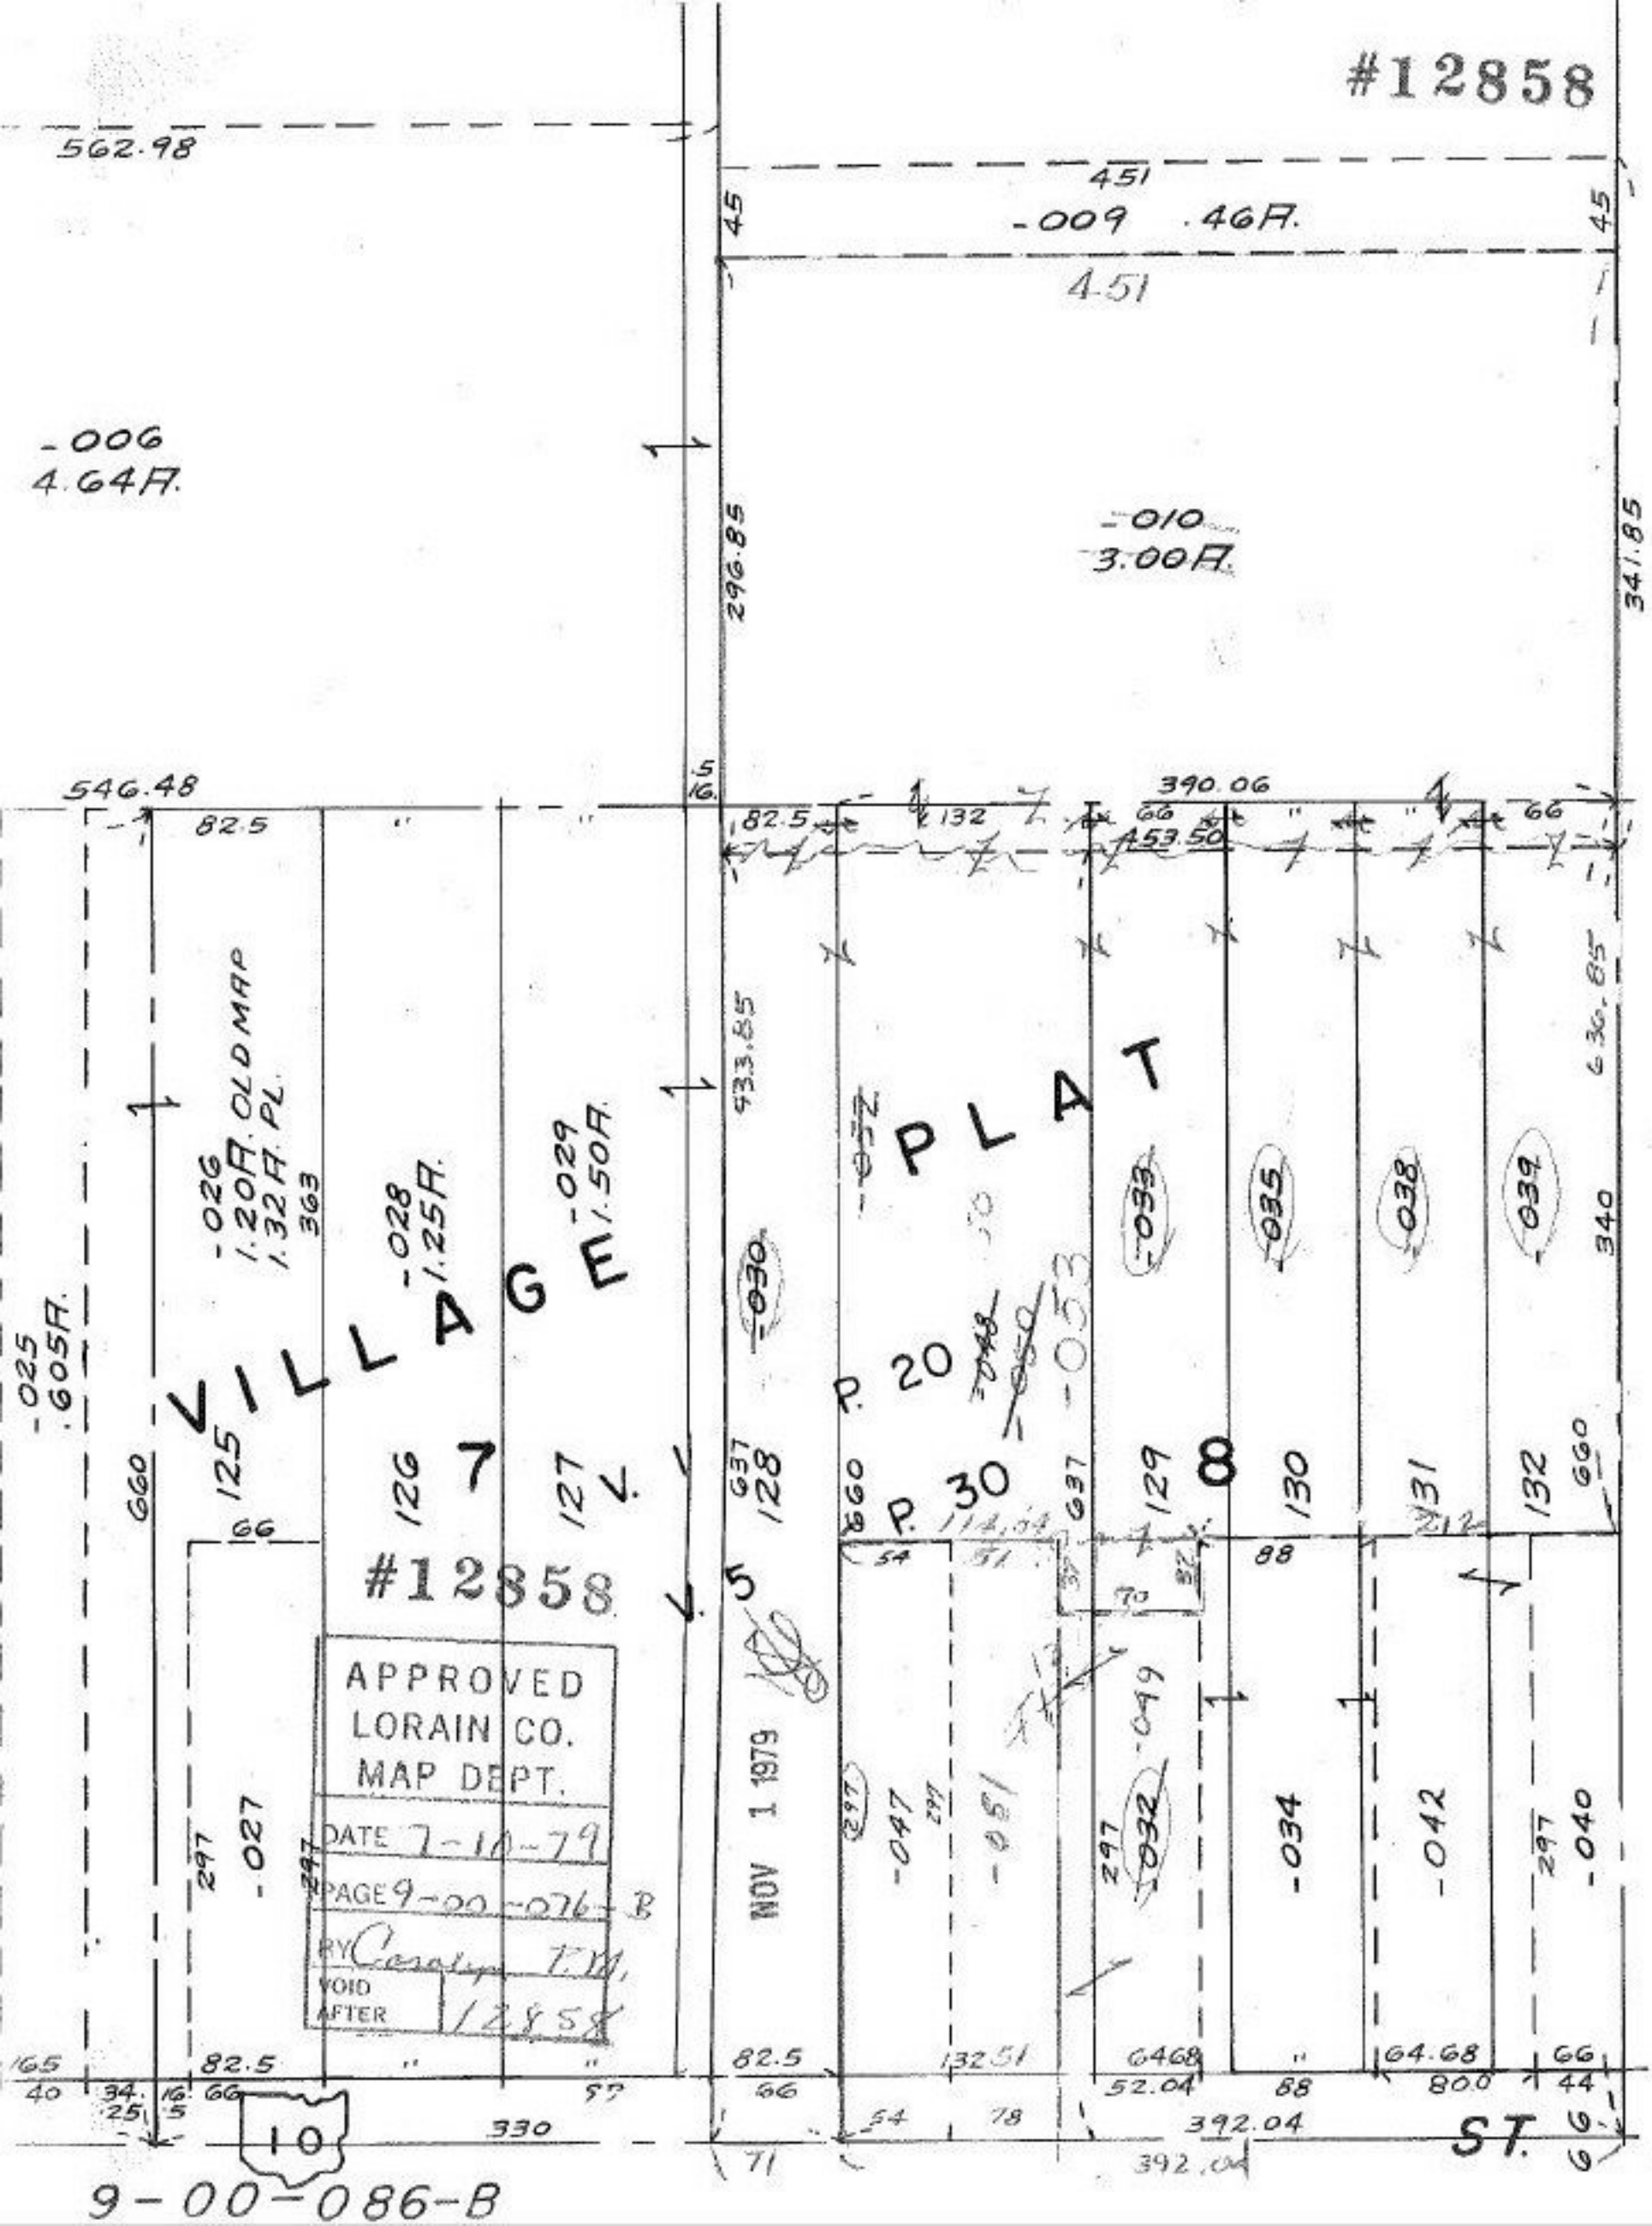
#12858
562.98
451
-009 .46A.
451
-006
4.64A.
-010
3.00A.
296.85
341.85
546.48
390.06
453.50
82.5
132
66
VILLAGE PLAT
-026
1.20A. OLD MAP
1.32A. PL.
-028
1.25A.
-029
1.50A.
-025
.605A.
433.85
636.85
P. 20
P. 30
V. 5
V. 7
V. 8
125
126
127
128
129
130
131
132
-030
-033
-035
-038
-039
-027
-047
-051
-032
-034
-042
-040
-049
-053
#12858
APPROVED
LORAIN CO.
MAP DEPT.
DATE 7-10-79
PAGE 9-00-076-B
BY Carolyn T.M.
VOID AFTER 12858
NOV 1 1979
10
330
392.04
ST.
9-00-086-B