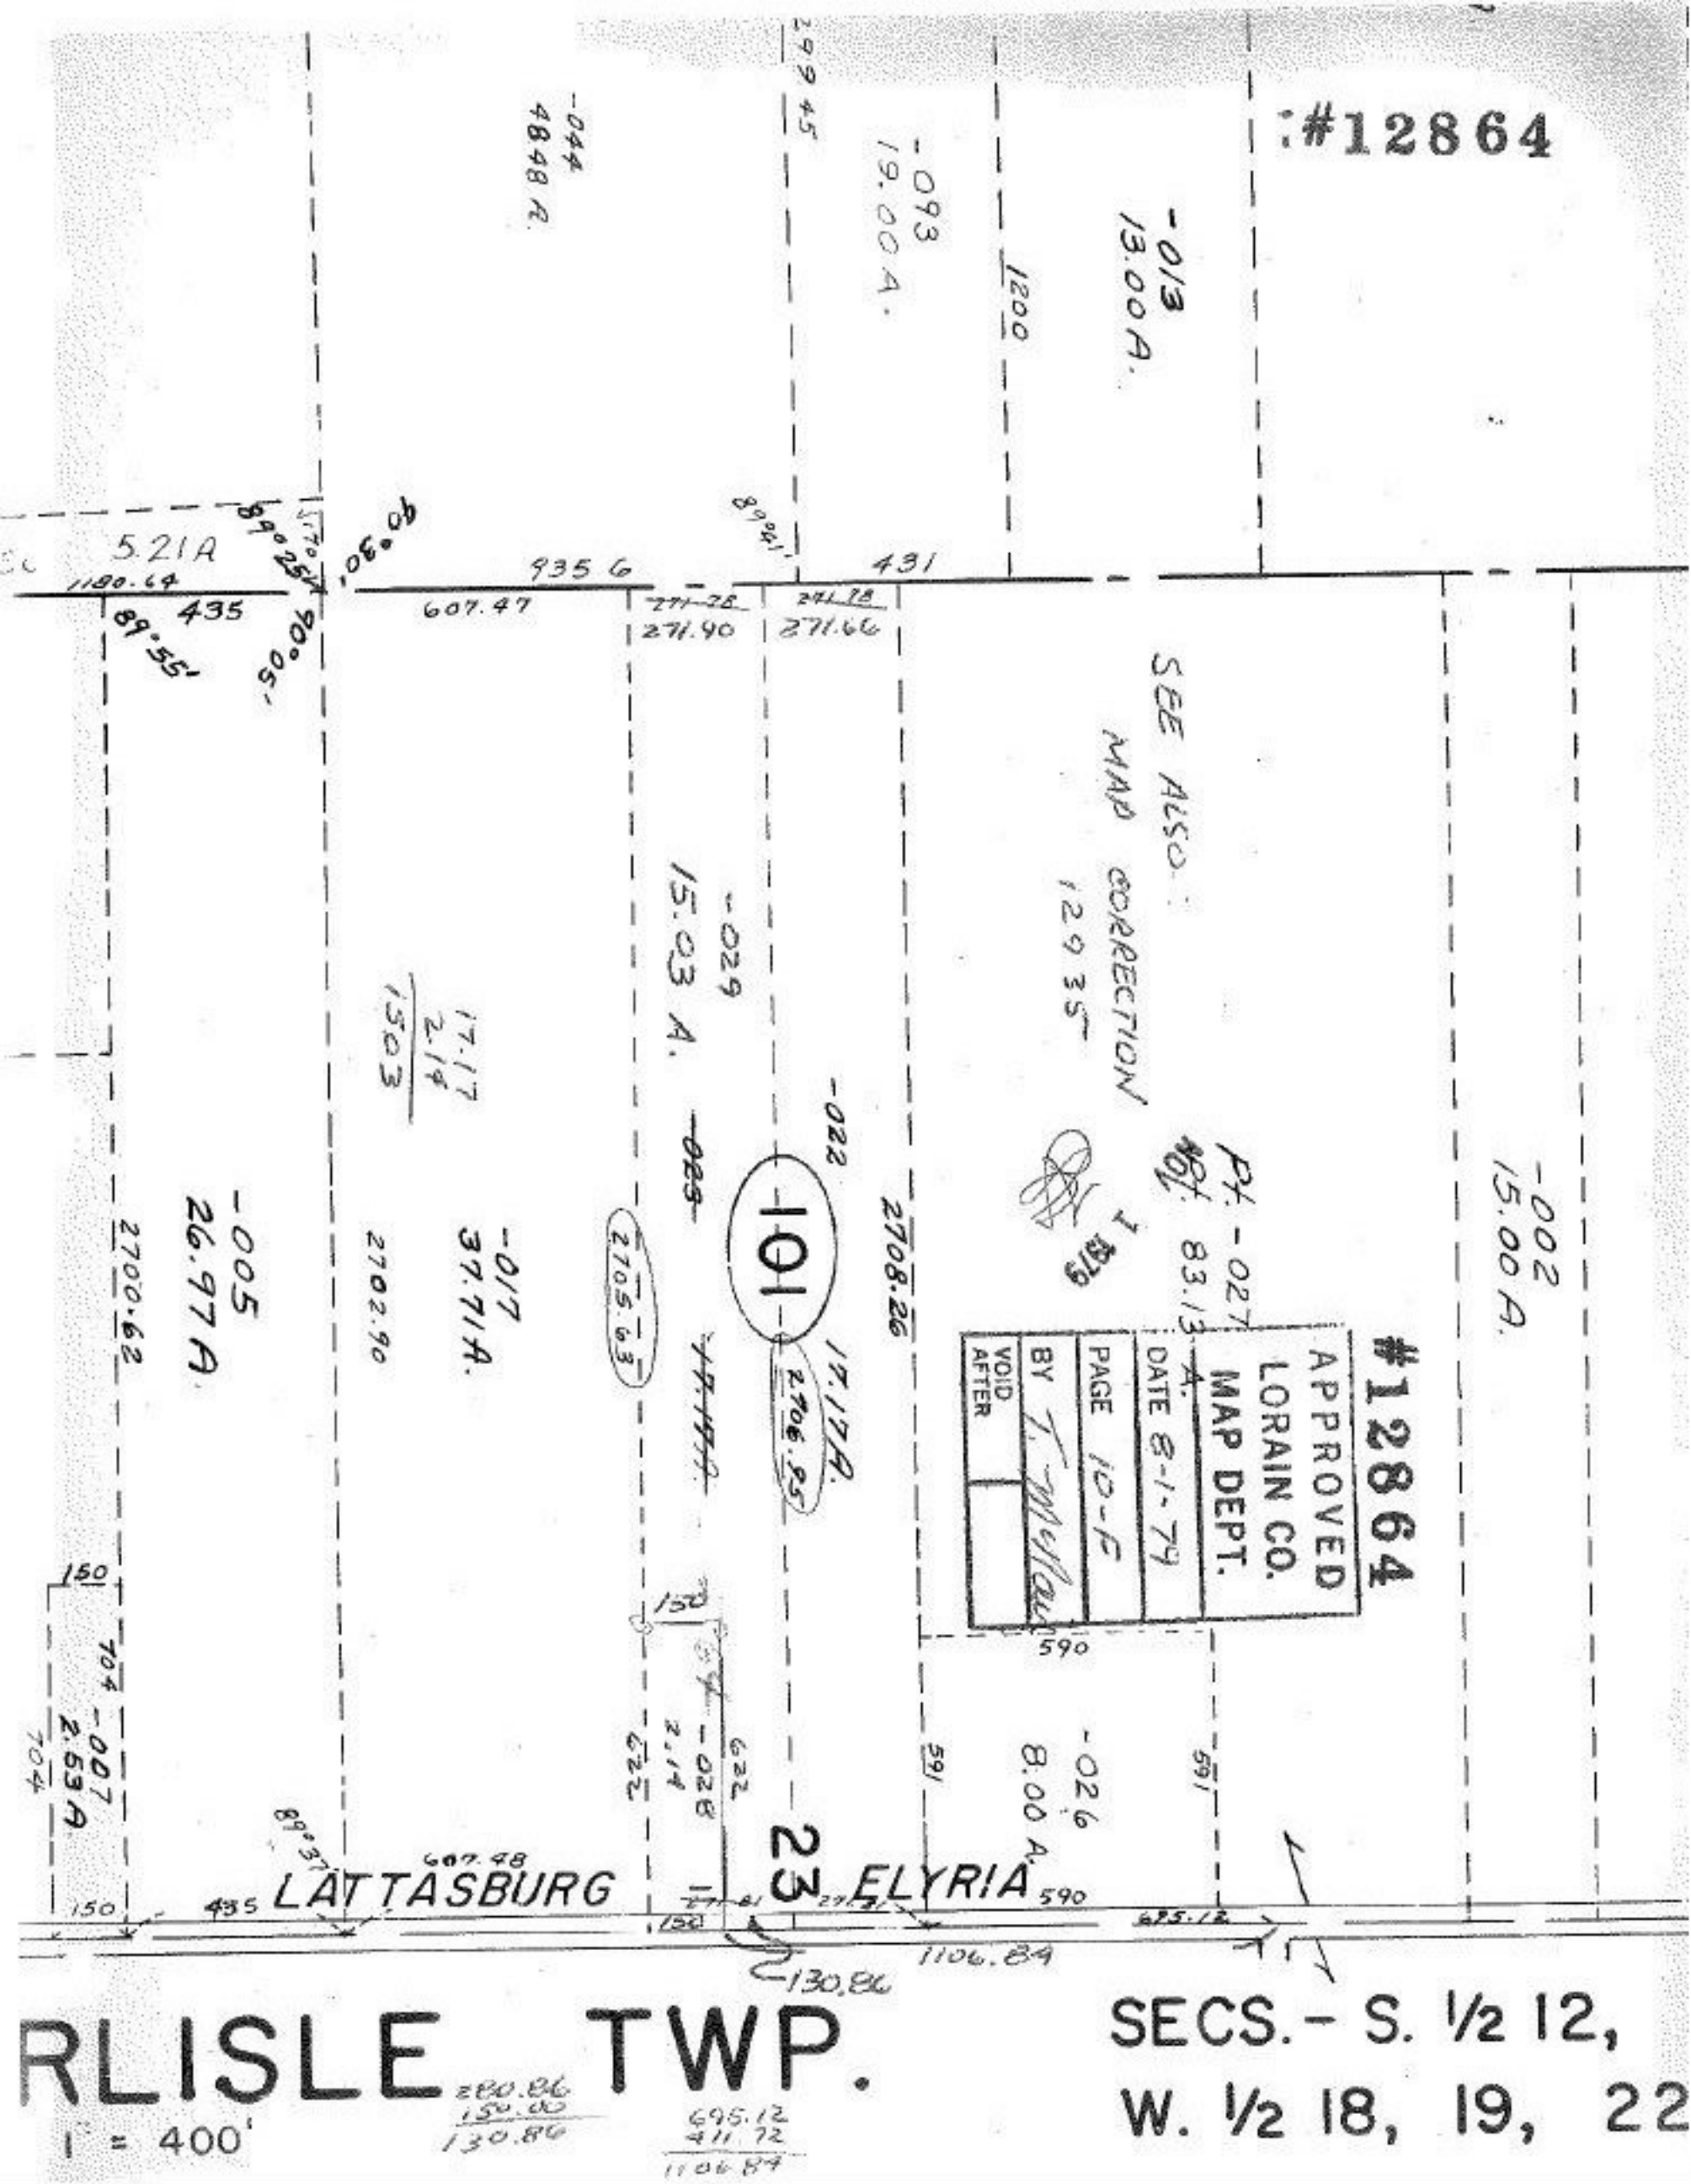
#12864
-044
4848 A.
-093
19.00 A.
-013
13.00 A.
1200
5.21 A
1180.64
435
935.6
431
607.47
271.90
271.66
SEE ALSO
MAP CORRECTION
12935
-029
15.03 A.
17.17
2.14
1503
-022
101
-005
26.97 A.
2700.62
-017
37.71 A.
2702.90
2705.63
17.17 A.
2706.95
2708.26
-002
15.00 A.
-026
8.00 A.
590
591
-007
2.53 A.
704
150
622
-028
2.14
23
LATTASBURG
ELYRIA
607.48
435
590
695.12
1106.84
130.86
RLISLE TWP.
1" = 400'
280.86
150.00
130.86
695.12
411.72
1106.84
SECS. - S. 1/2 12,
W. 1/2 18, 19, 22
APPROVED
LORAIN CO.
MAP DEPT.
DATE 8-1-79
PAGE 10-F
BY
VOID AFTER
#12864