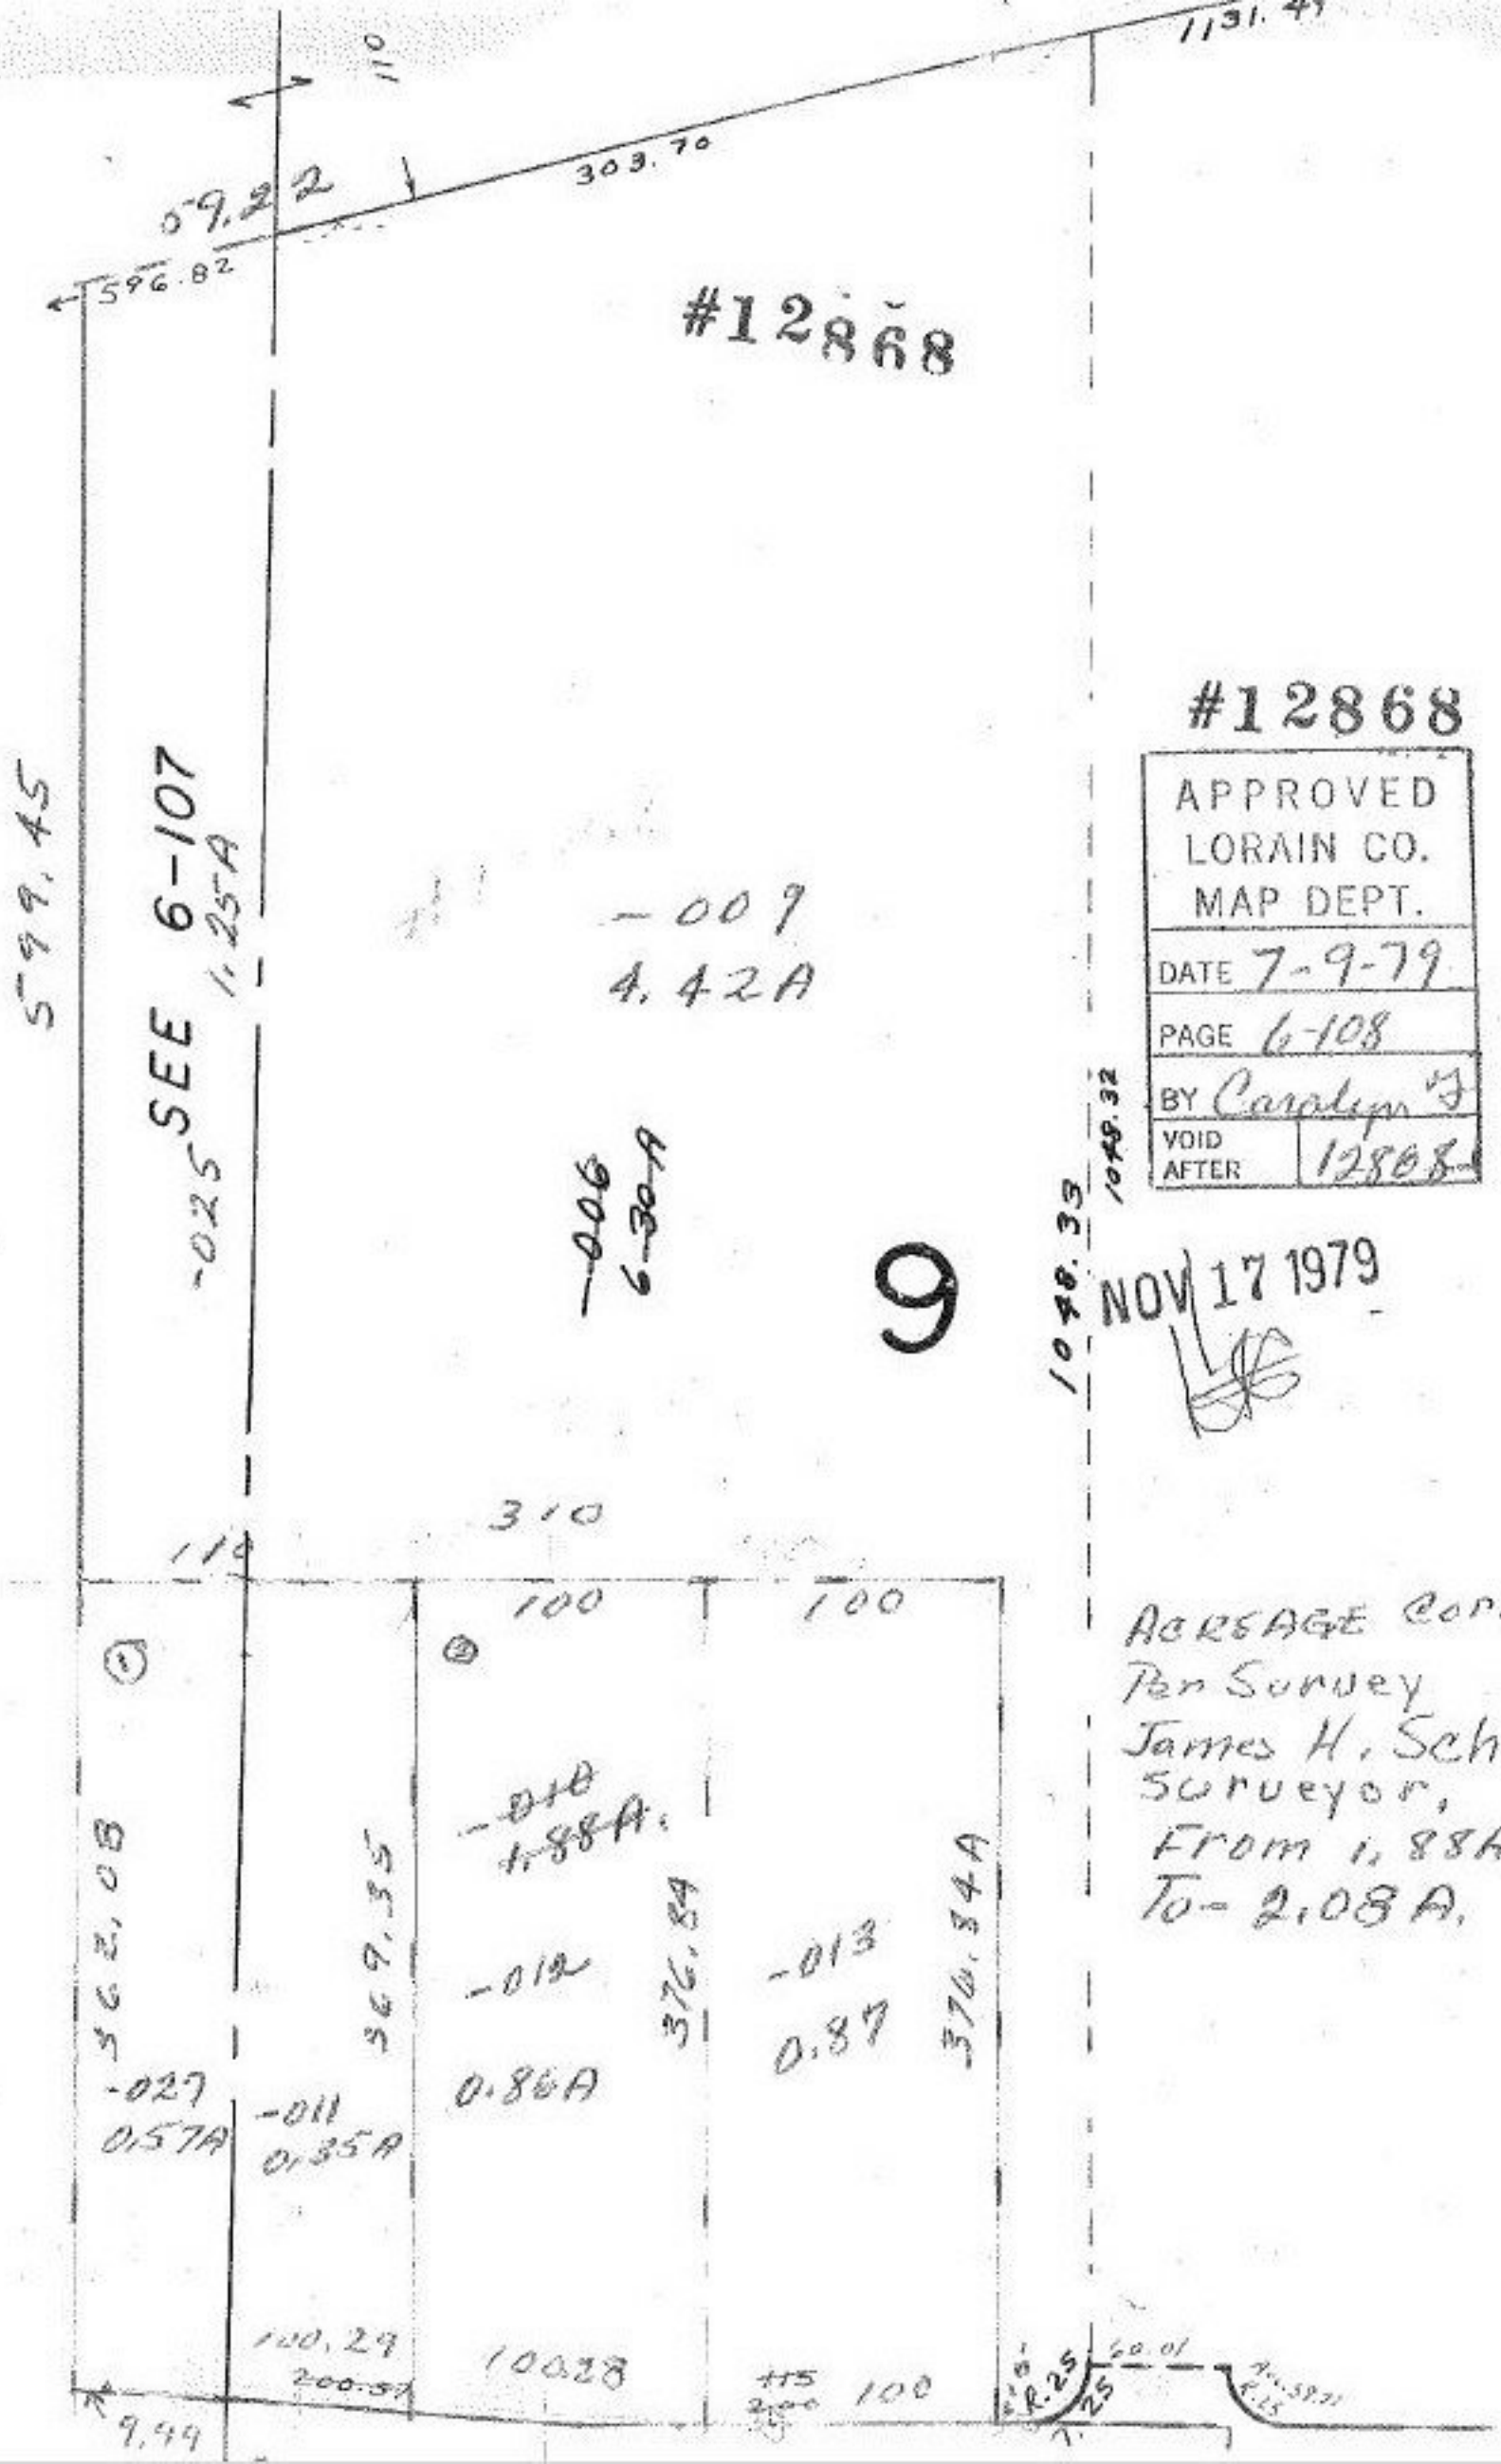

#12868

APPROVED
LORAIN CO.
MAP DEPT.

DATE 7-9-79

PAGE 6-108

BY Carolyn J

VOID AFTER 12868

NOV 17 1979

ACREAGE CORRECTION
Per Survey
James H. Schmidt
Surveyor,
From 1.88 Acreage
To - 2.08 A.