#12873

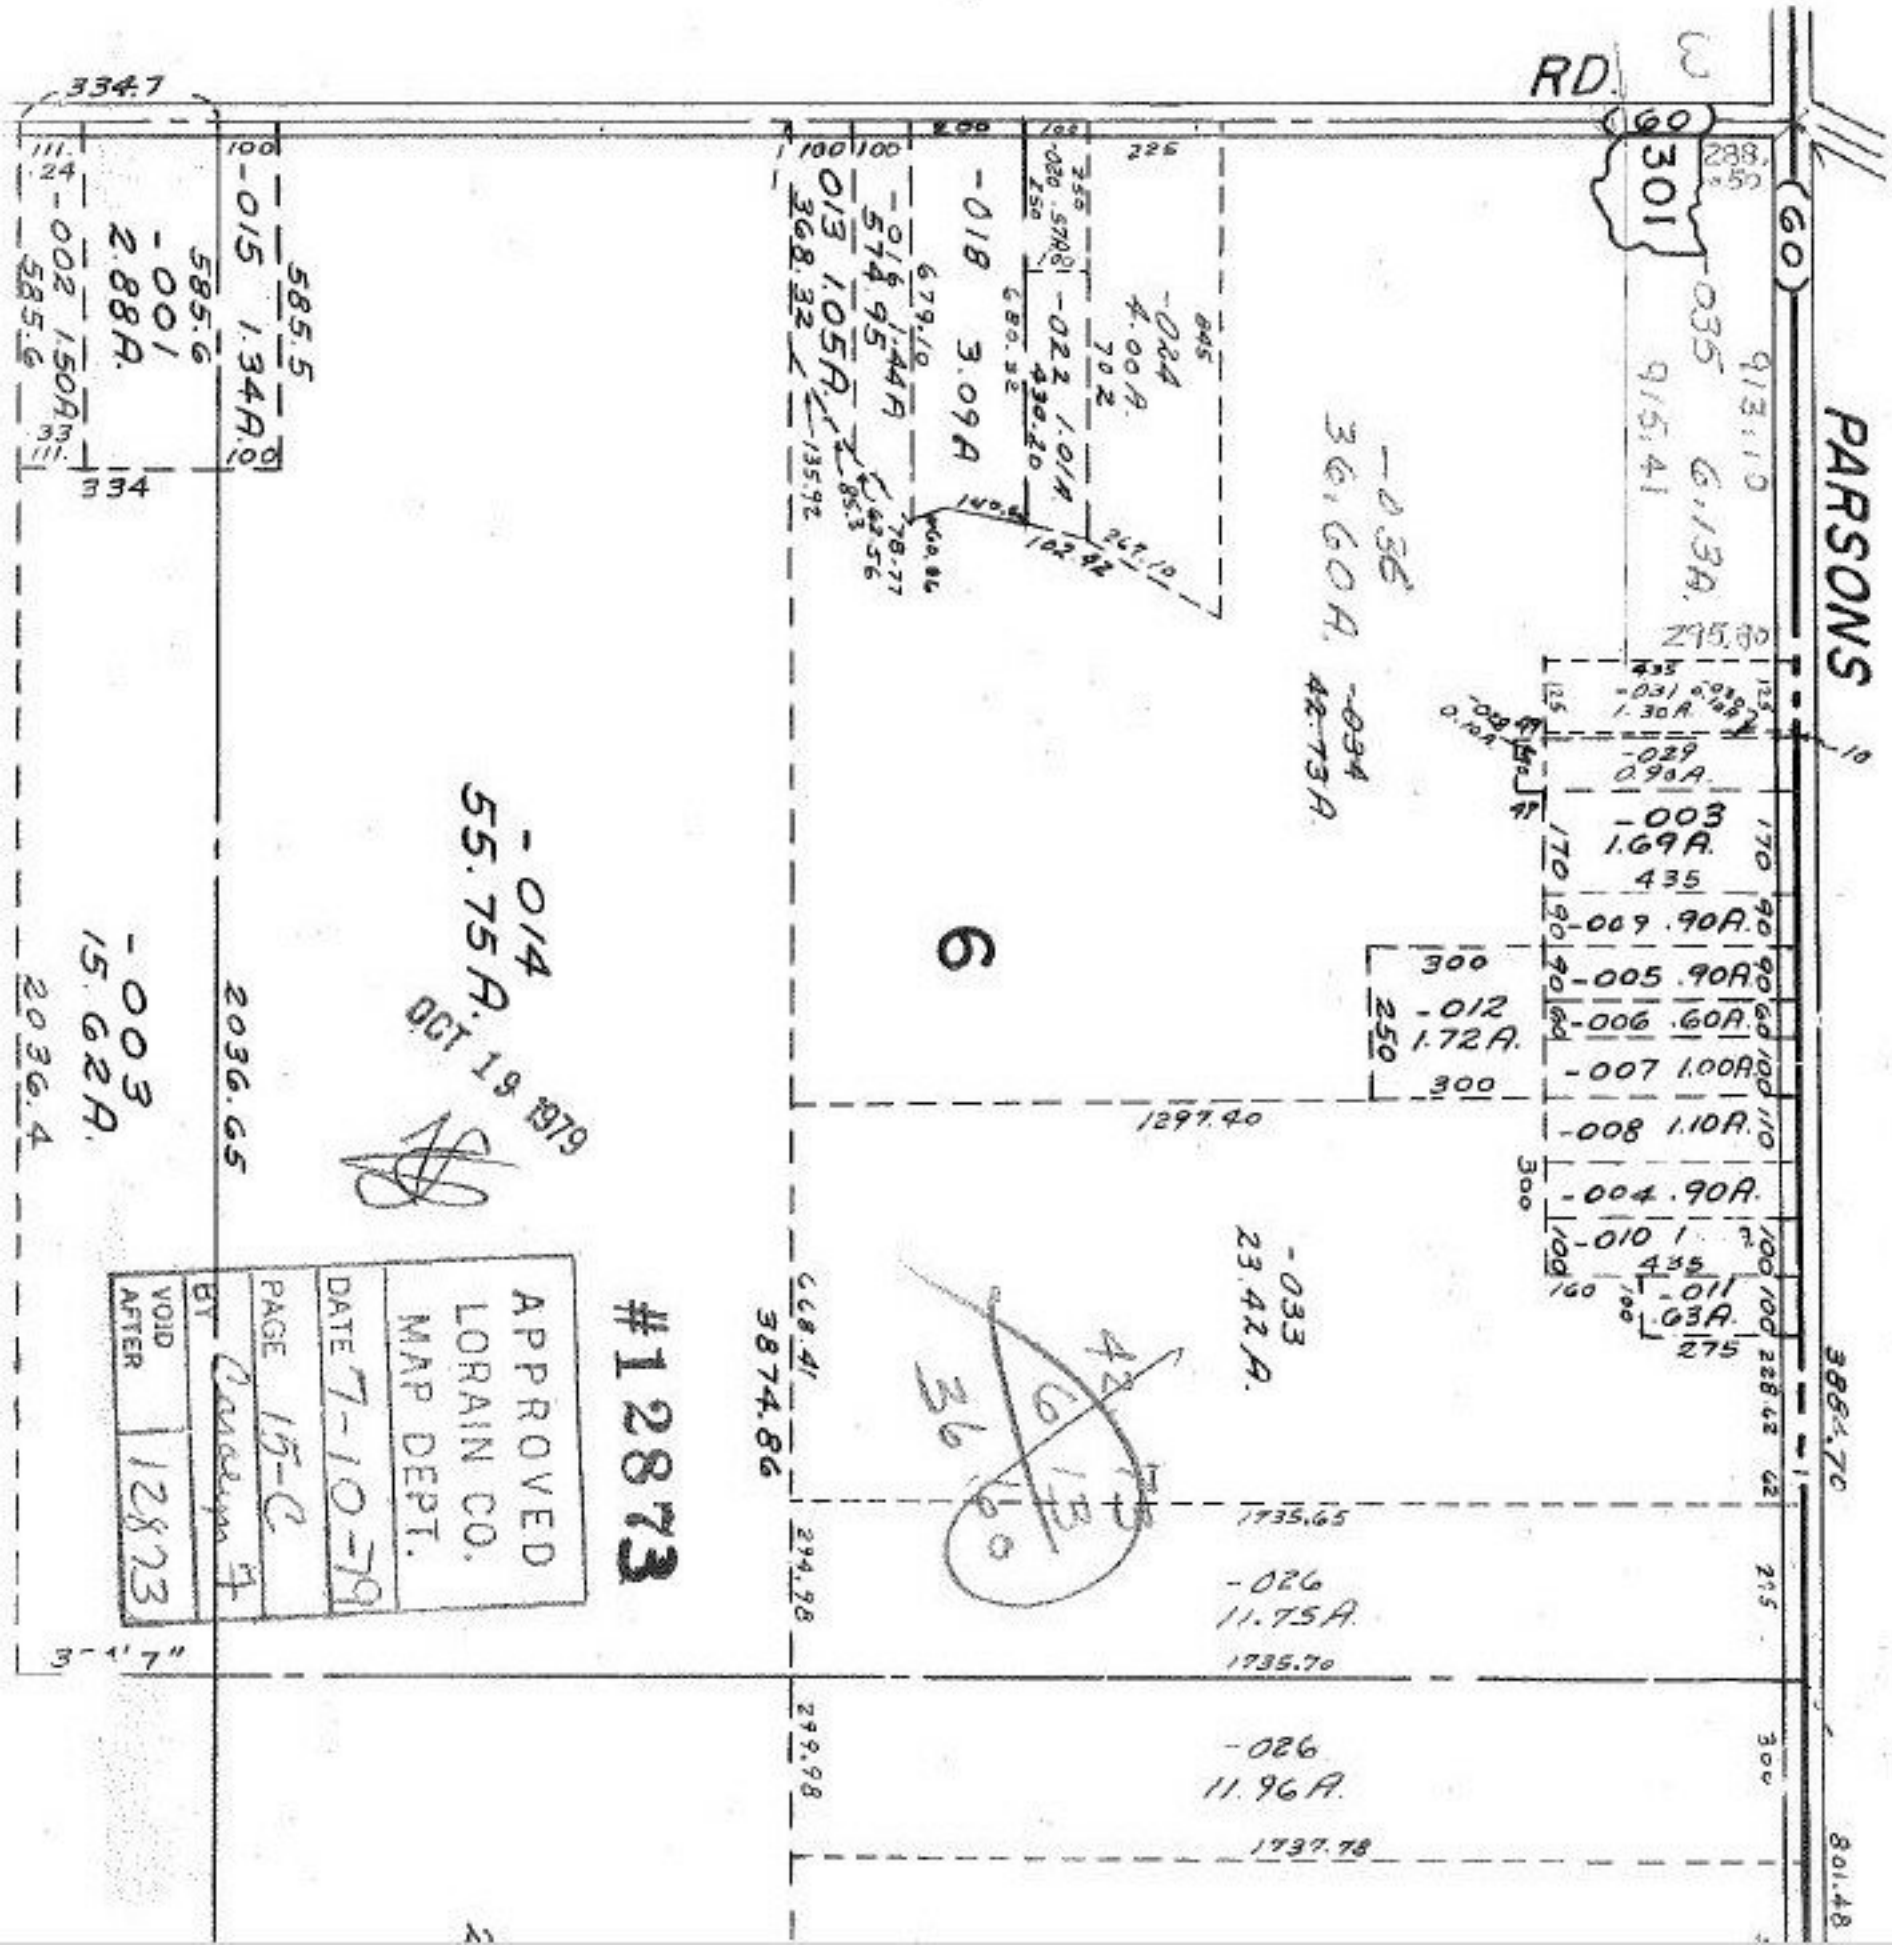

APPROVED
LORAIN CO.
MAP DEPT.
DATE 7-10-79
PAGE 15-C
BY Carolyn F
VOID AFTER 12873

OCT 19 1979

#12873