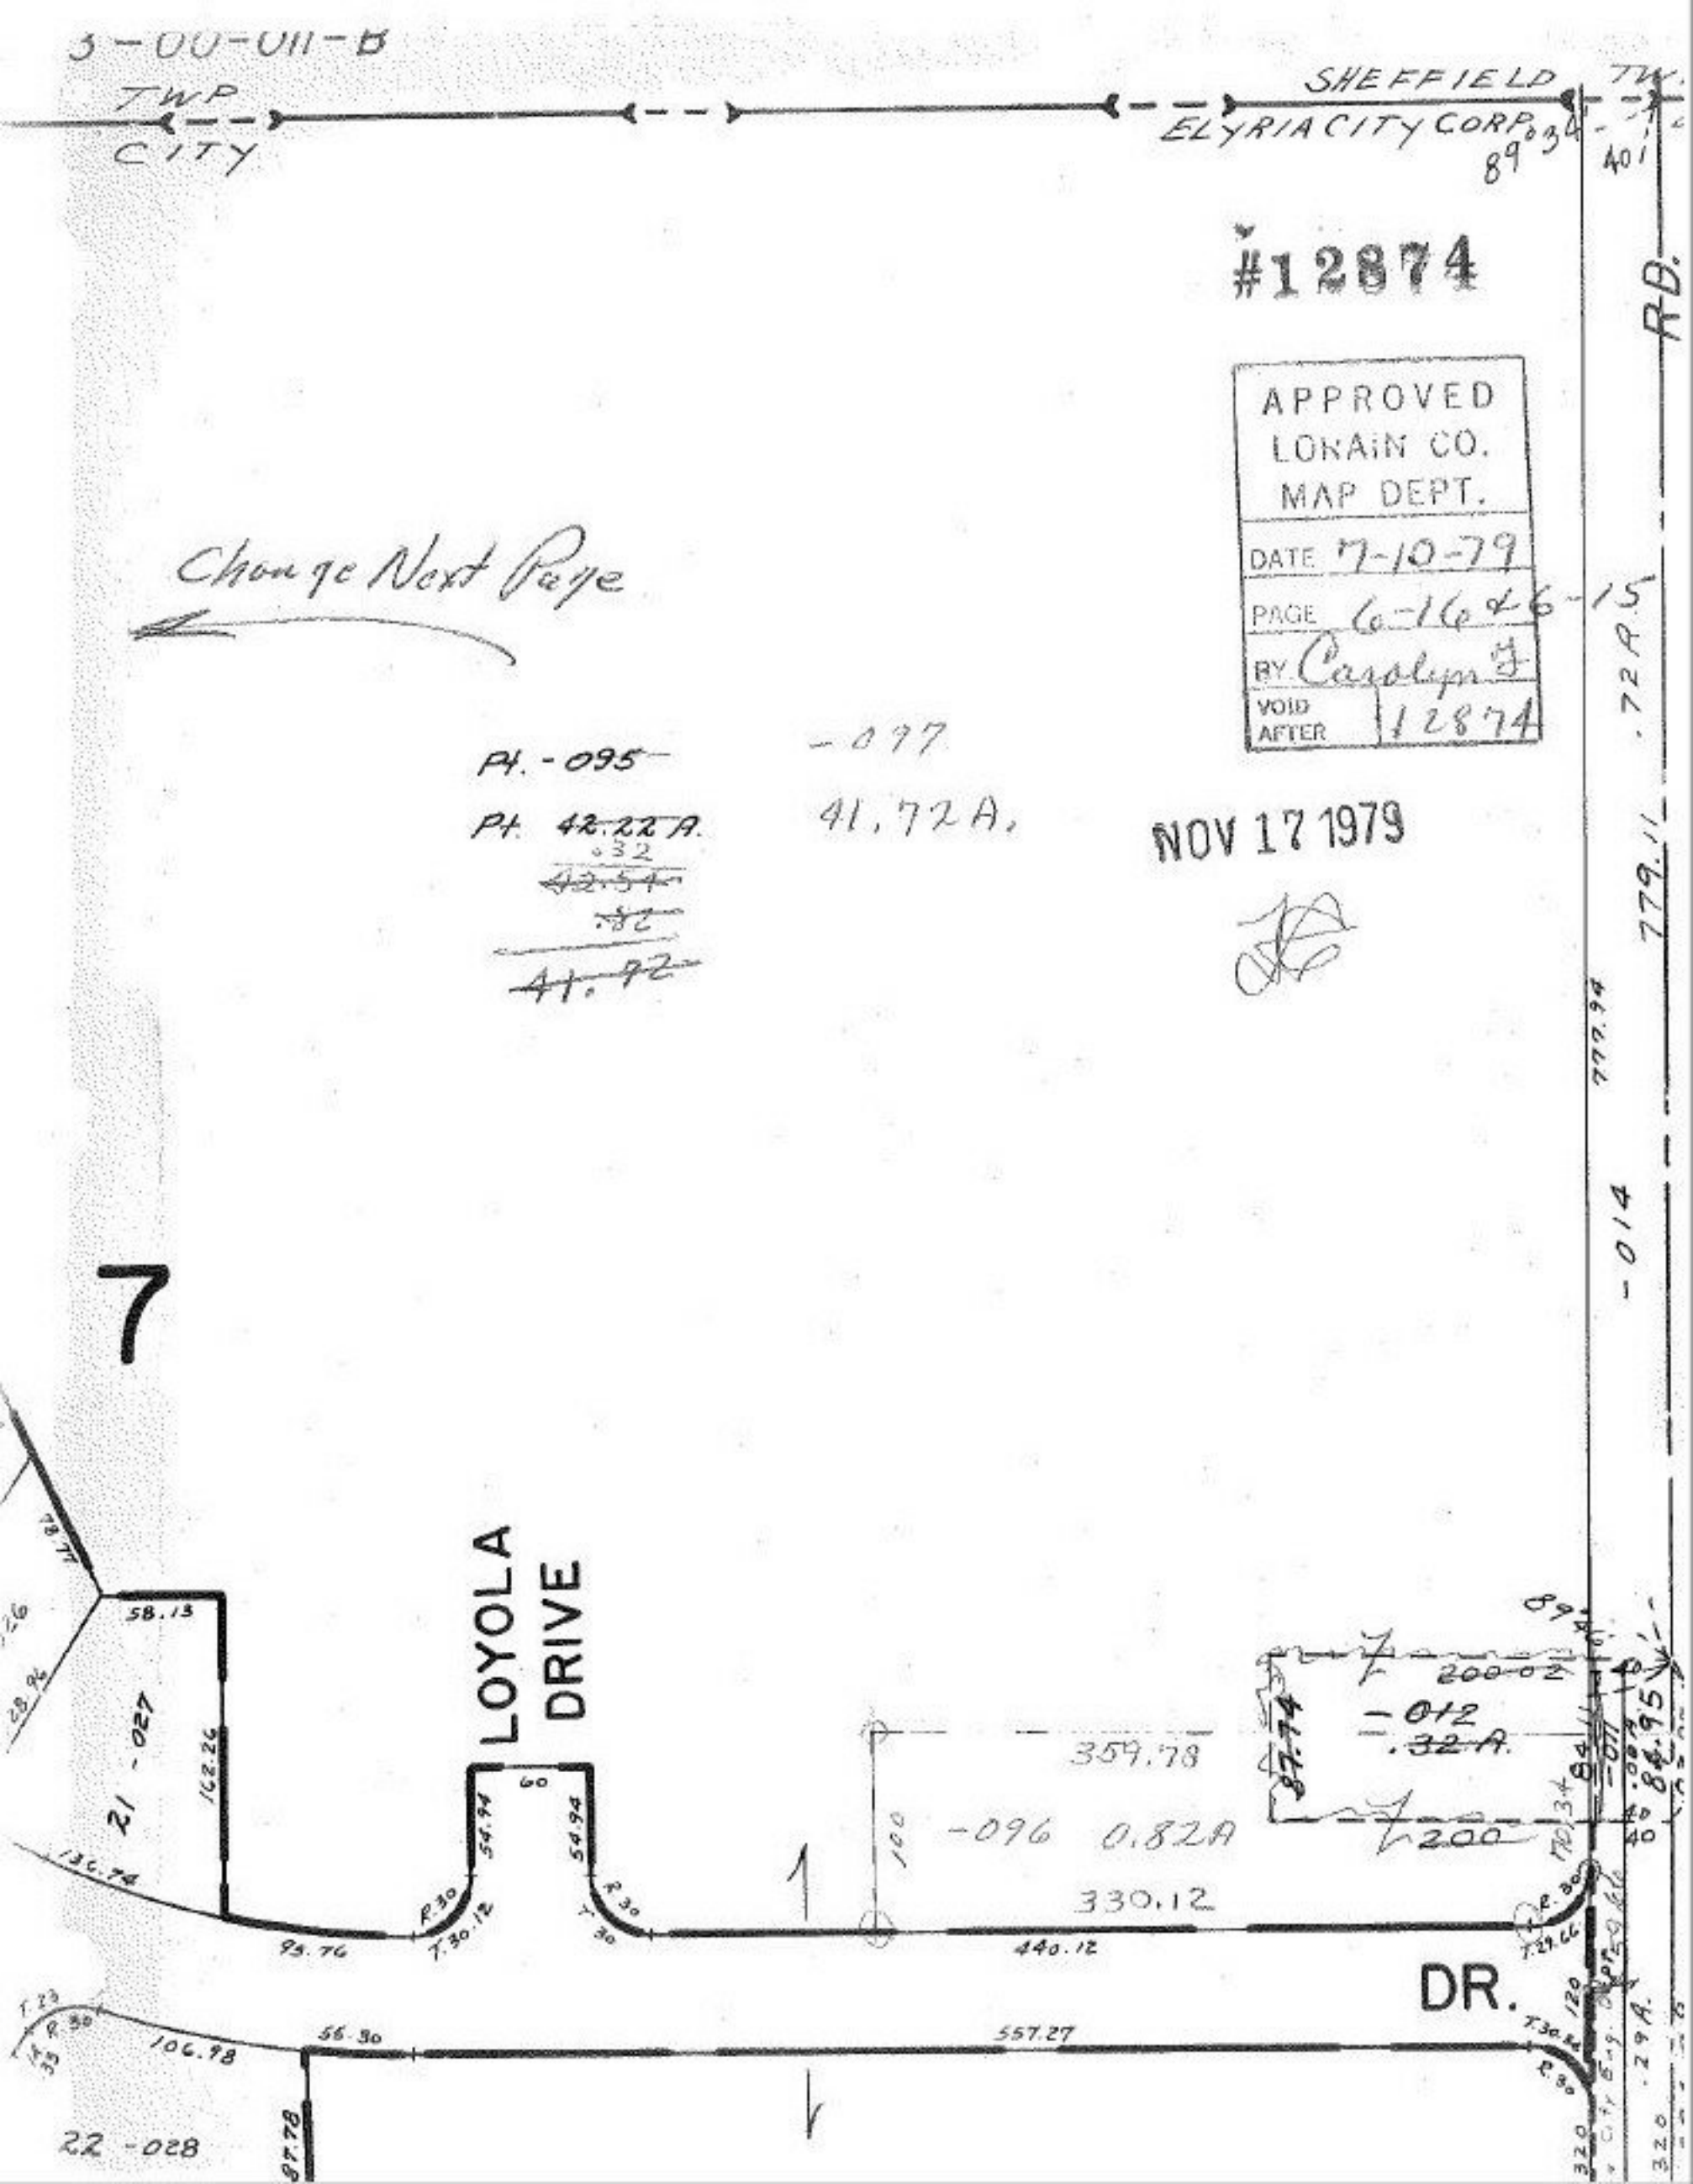
3-00-011-B
TWP
CITY
SHEFFIELD TW.
ELYRIA CITY CORP.
89°34'
40'
#12874
APPROVED
LORAIN CO.
MAP DEPT.
DATE 7-10-79
PAGE 6-16 & 6-15
BY Carolyn G
VOID AFTER 12874
Change Next Page
Pt. -095
Pt. ~~42.22 A.~~
.32
~~42.54~~
~~.82~~
~~41.72~~
-097
41.72 A.
NOV 17 1979
RD.
.72 A.
779.11
777.94
-014
7
LOYOLA
DRIVE
58.13
21 -027
162.26
136.74
93.76
R.30
T.30.12
54.94
60
54.94
R.30
T.30
359.78
100
-096 0.82A
330.12
440.12
200-02
-012
.32 A.
87.74
200
84.95
DR.
106.98
56.30
557.27
22 -028
87.78
320
.29 A.