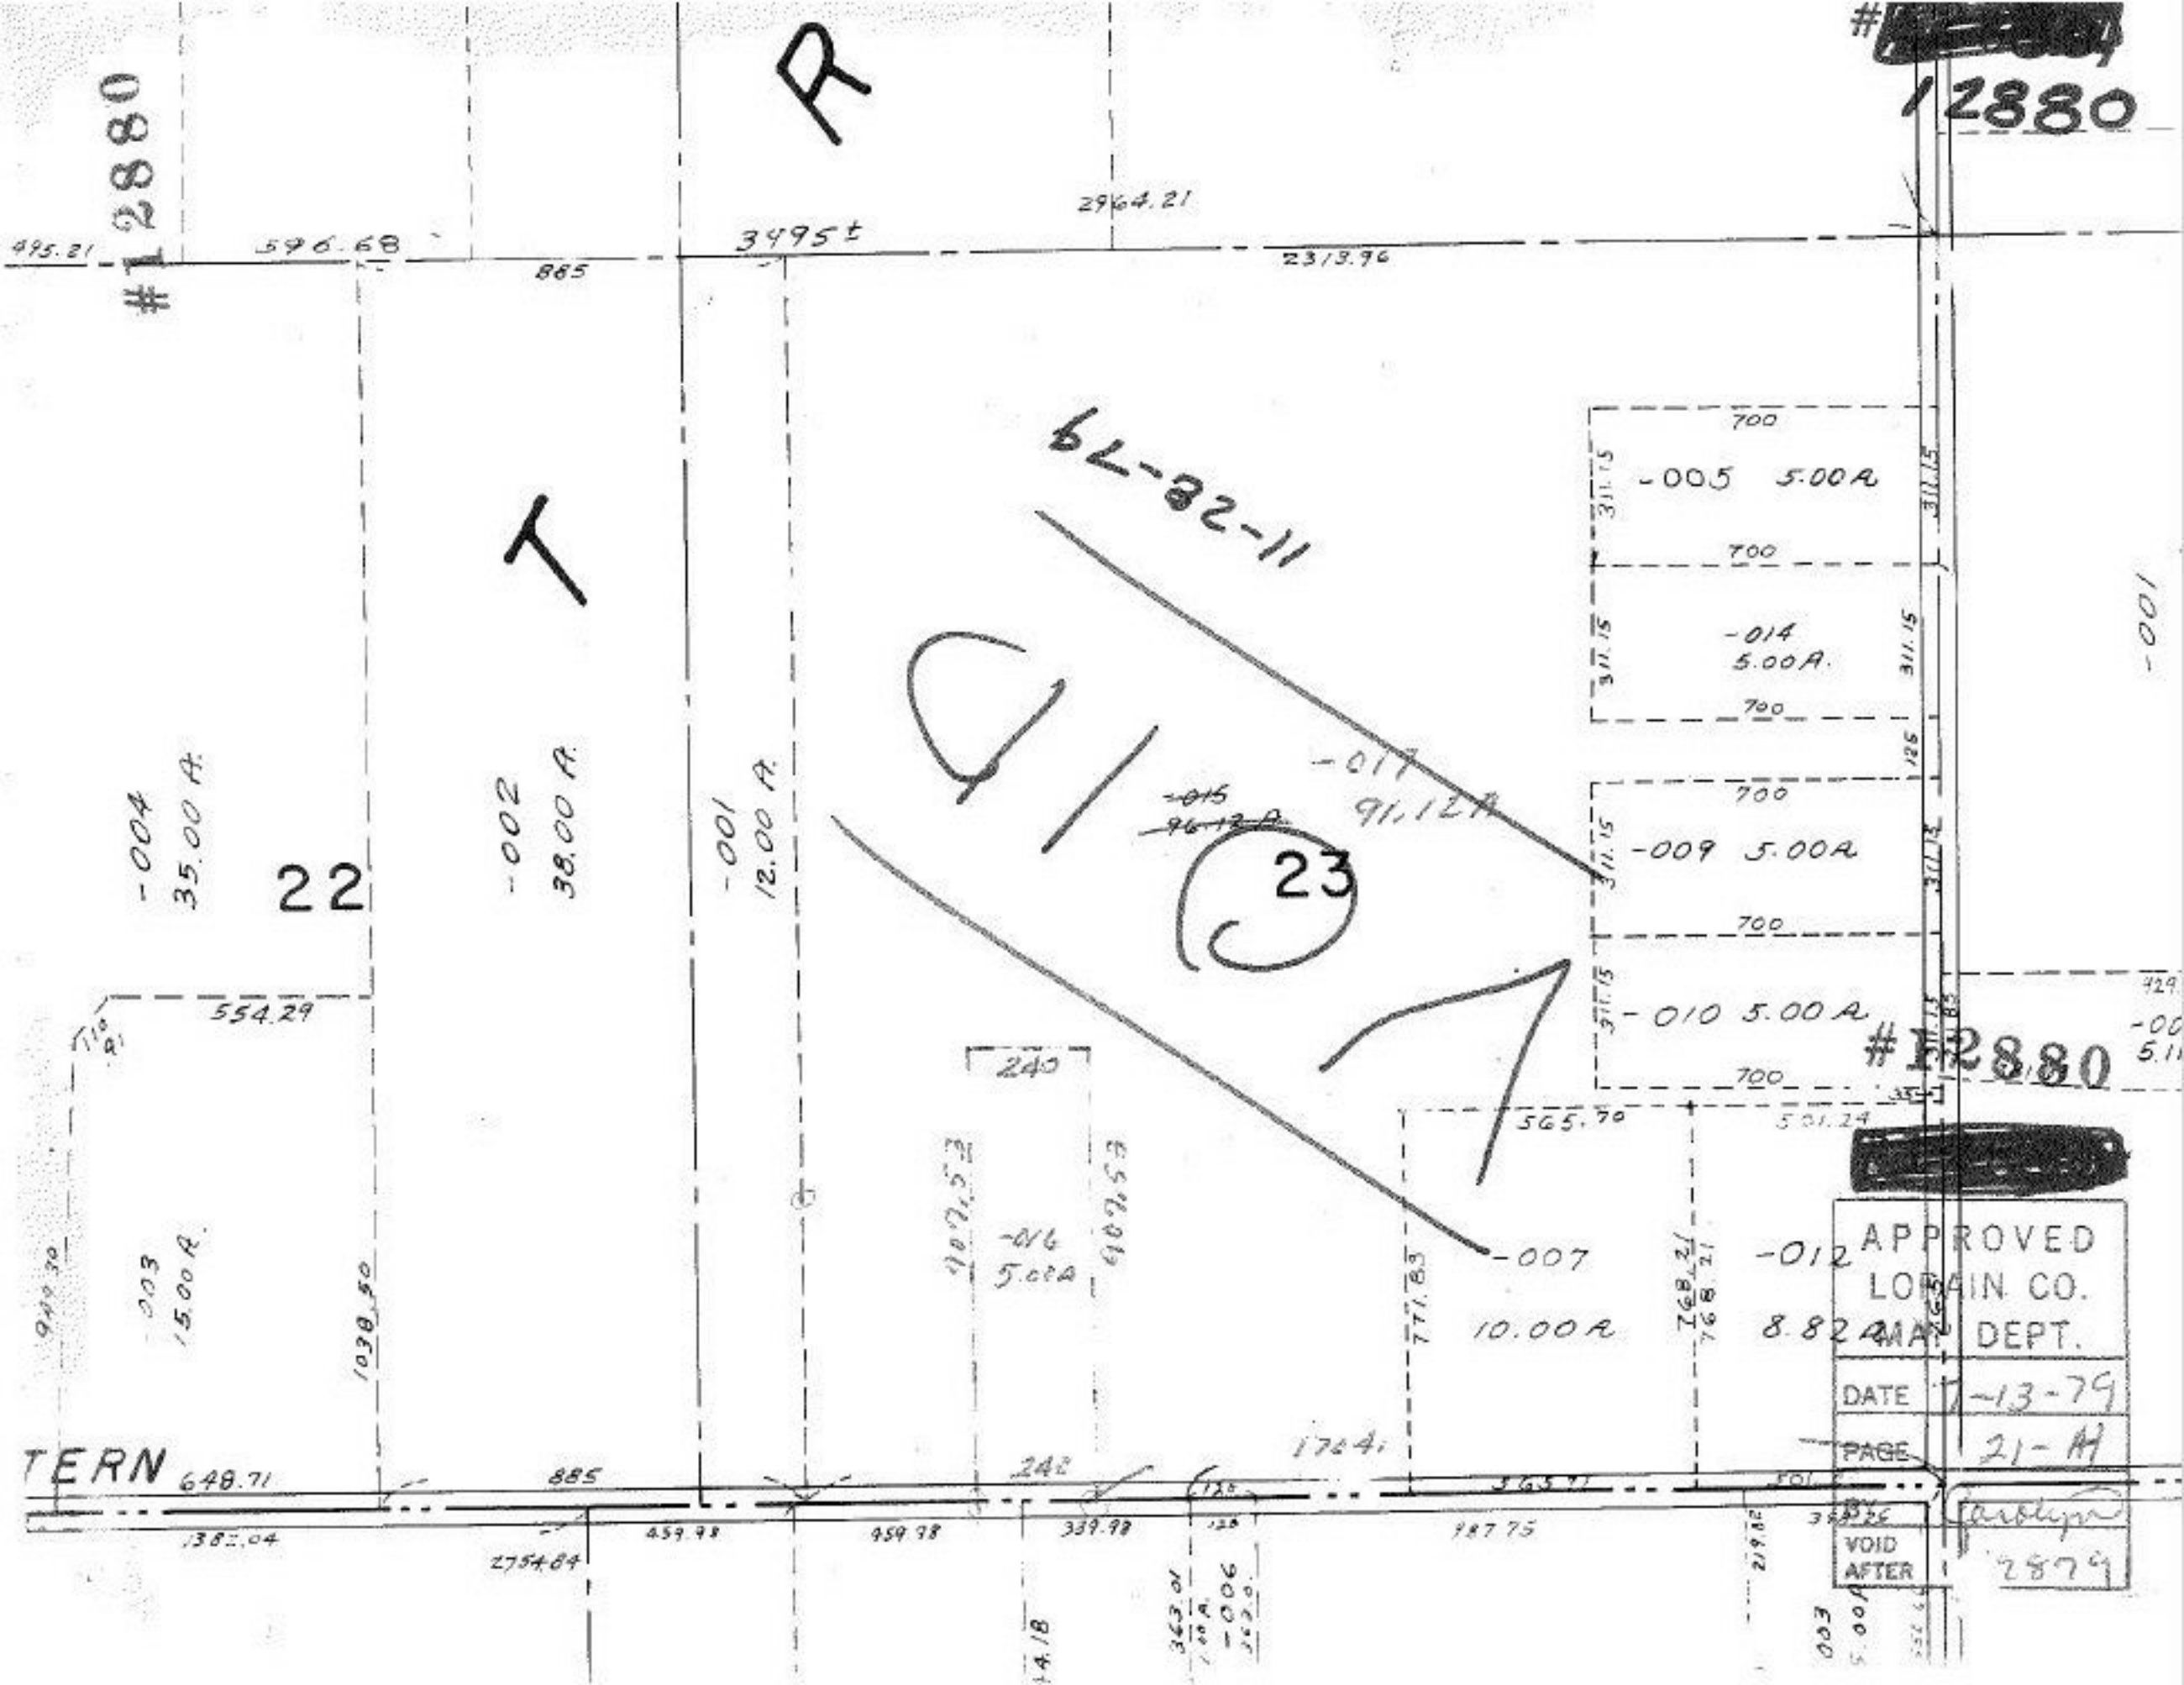

#12880
#12880
#12880
#12880
R
T
TERN
22
23
11-28-79
-004 35.00 A.
-002 38.00 A.
-001 12.00 A.
-015 96.12 A.
-017 91.12 A.
-005 5.00 A.
-014 5.00 A.
-009 5.00 A.
-010 5.00 A.
-007 10.00 A.
-012 8.82 A.
-016 5.00 A.
-003 15.00 A.
-001
495.21
596.68
885
3495±
2964.21
2313.96
554.29
240
565.70
501.24
648.71
885
242
1704.1
1382.04
2754.84
459.98
459.98
339.98
987.75
1038.50
949.30
700
311.15
125
APPROVED
LORAIN CO.
MAP DEPT.
DATE 7-13-79
PAGE 21-A
BY
VOID AFTER
2879