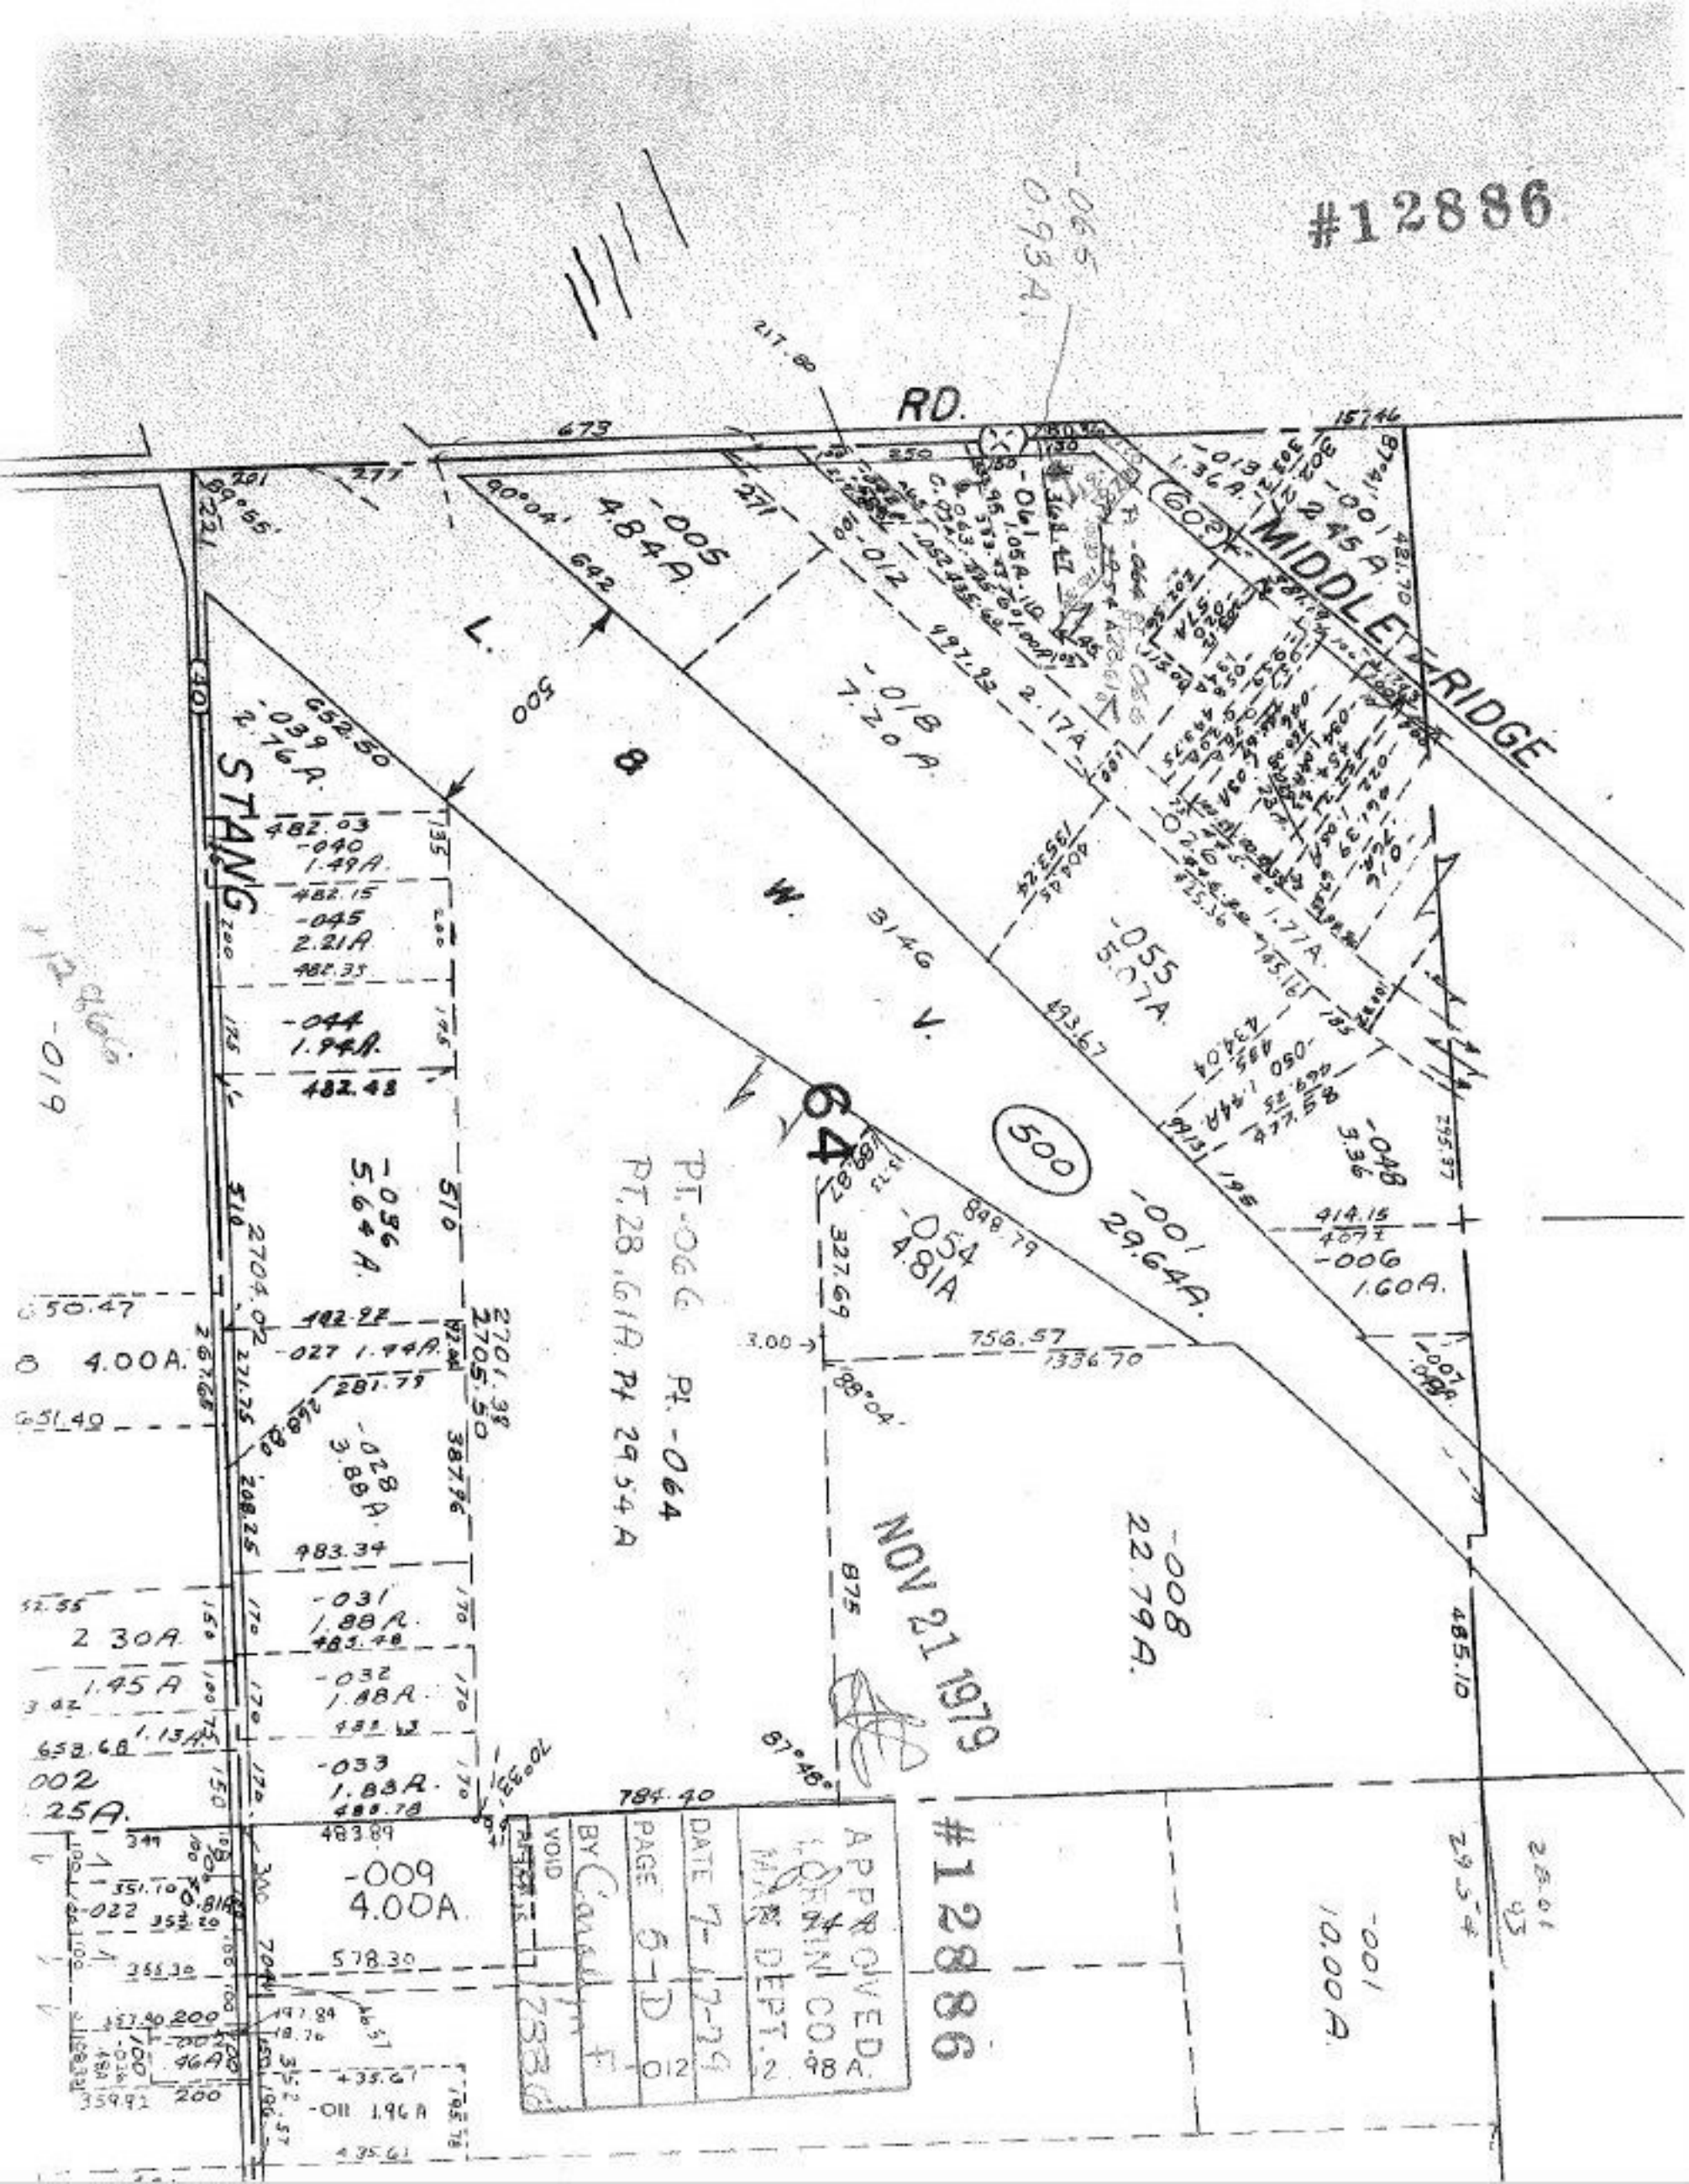
#12886
RD.
MIDDLE RIDGE
STANG
L. 8 W. V.
64
500
-005 4.84A.
-018 7.20A.
-055 5.07A.
-001 29.64A.
-054 4.81A.
-008 22.79A.
-009 4.00A.
-001 10.00A.
-036 5.64A.
-028 3.88A.
-031 1.88A.
-032 1.88A.
-033 1.88A.
-039 2.76A.
-040 1.49A.
-045 2.21A.
-044 1.94A.
-027 1.94A.
-011 1.96A.
-006 1.60A.
-048 3.36
-012
-013 1.36A.
-001 2.45A.
-061
-064
PT. -066 Pt. -064
PT. 28.61A. Pt 29.54A
NOV 21 1979
APPROVED
LORAIN CO.
MAR. DEPT.
DATE 7-17-79
PAGE 5-D
BY
VOID
#12886