#12889

#12889

APPROVED
LORAIN CO.
MAP DEPT.
DATE 7-17-79
PAGE 10 CD 2203-B
BY T. McNair
VOID AFTER
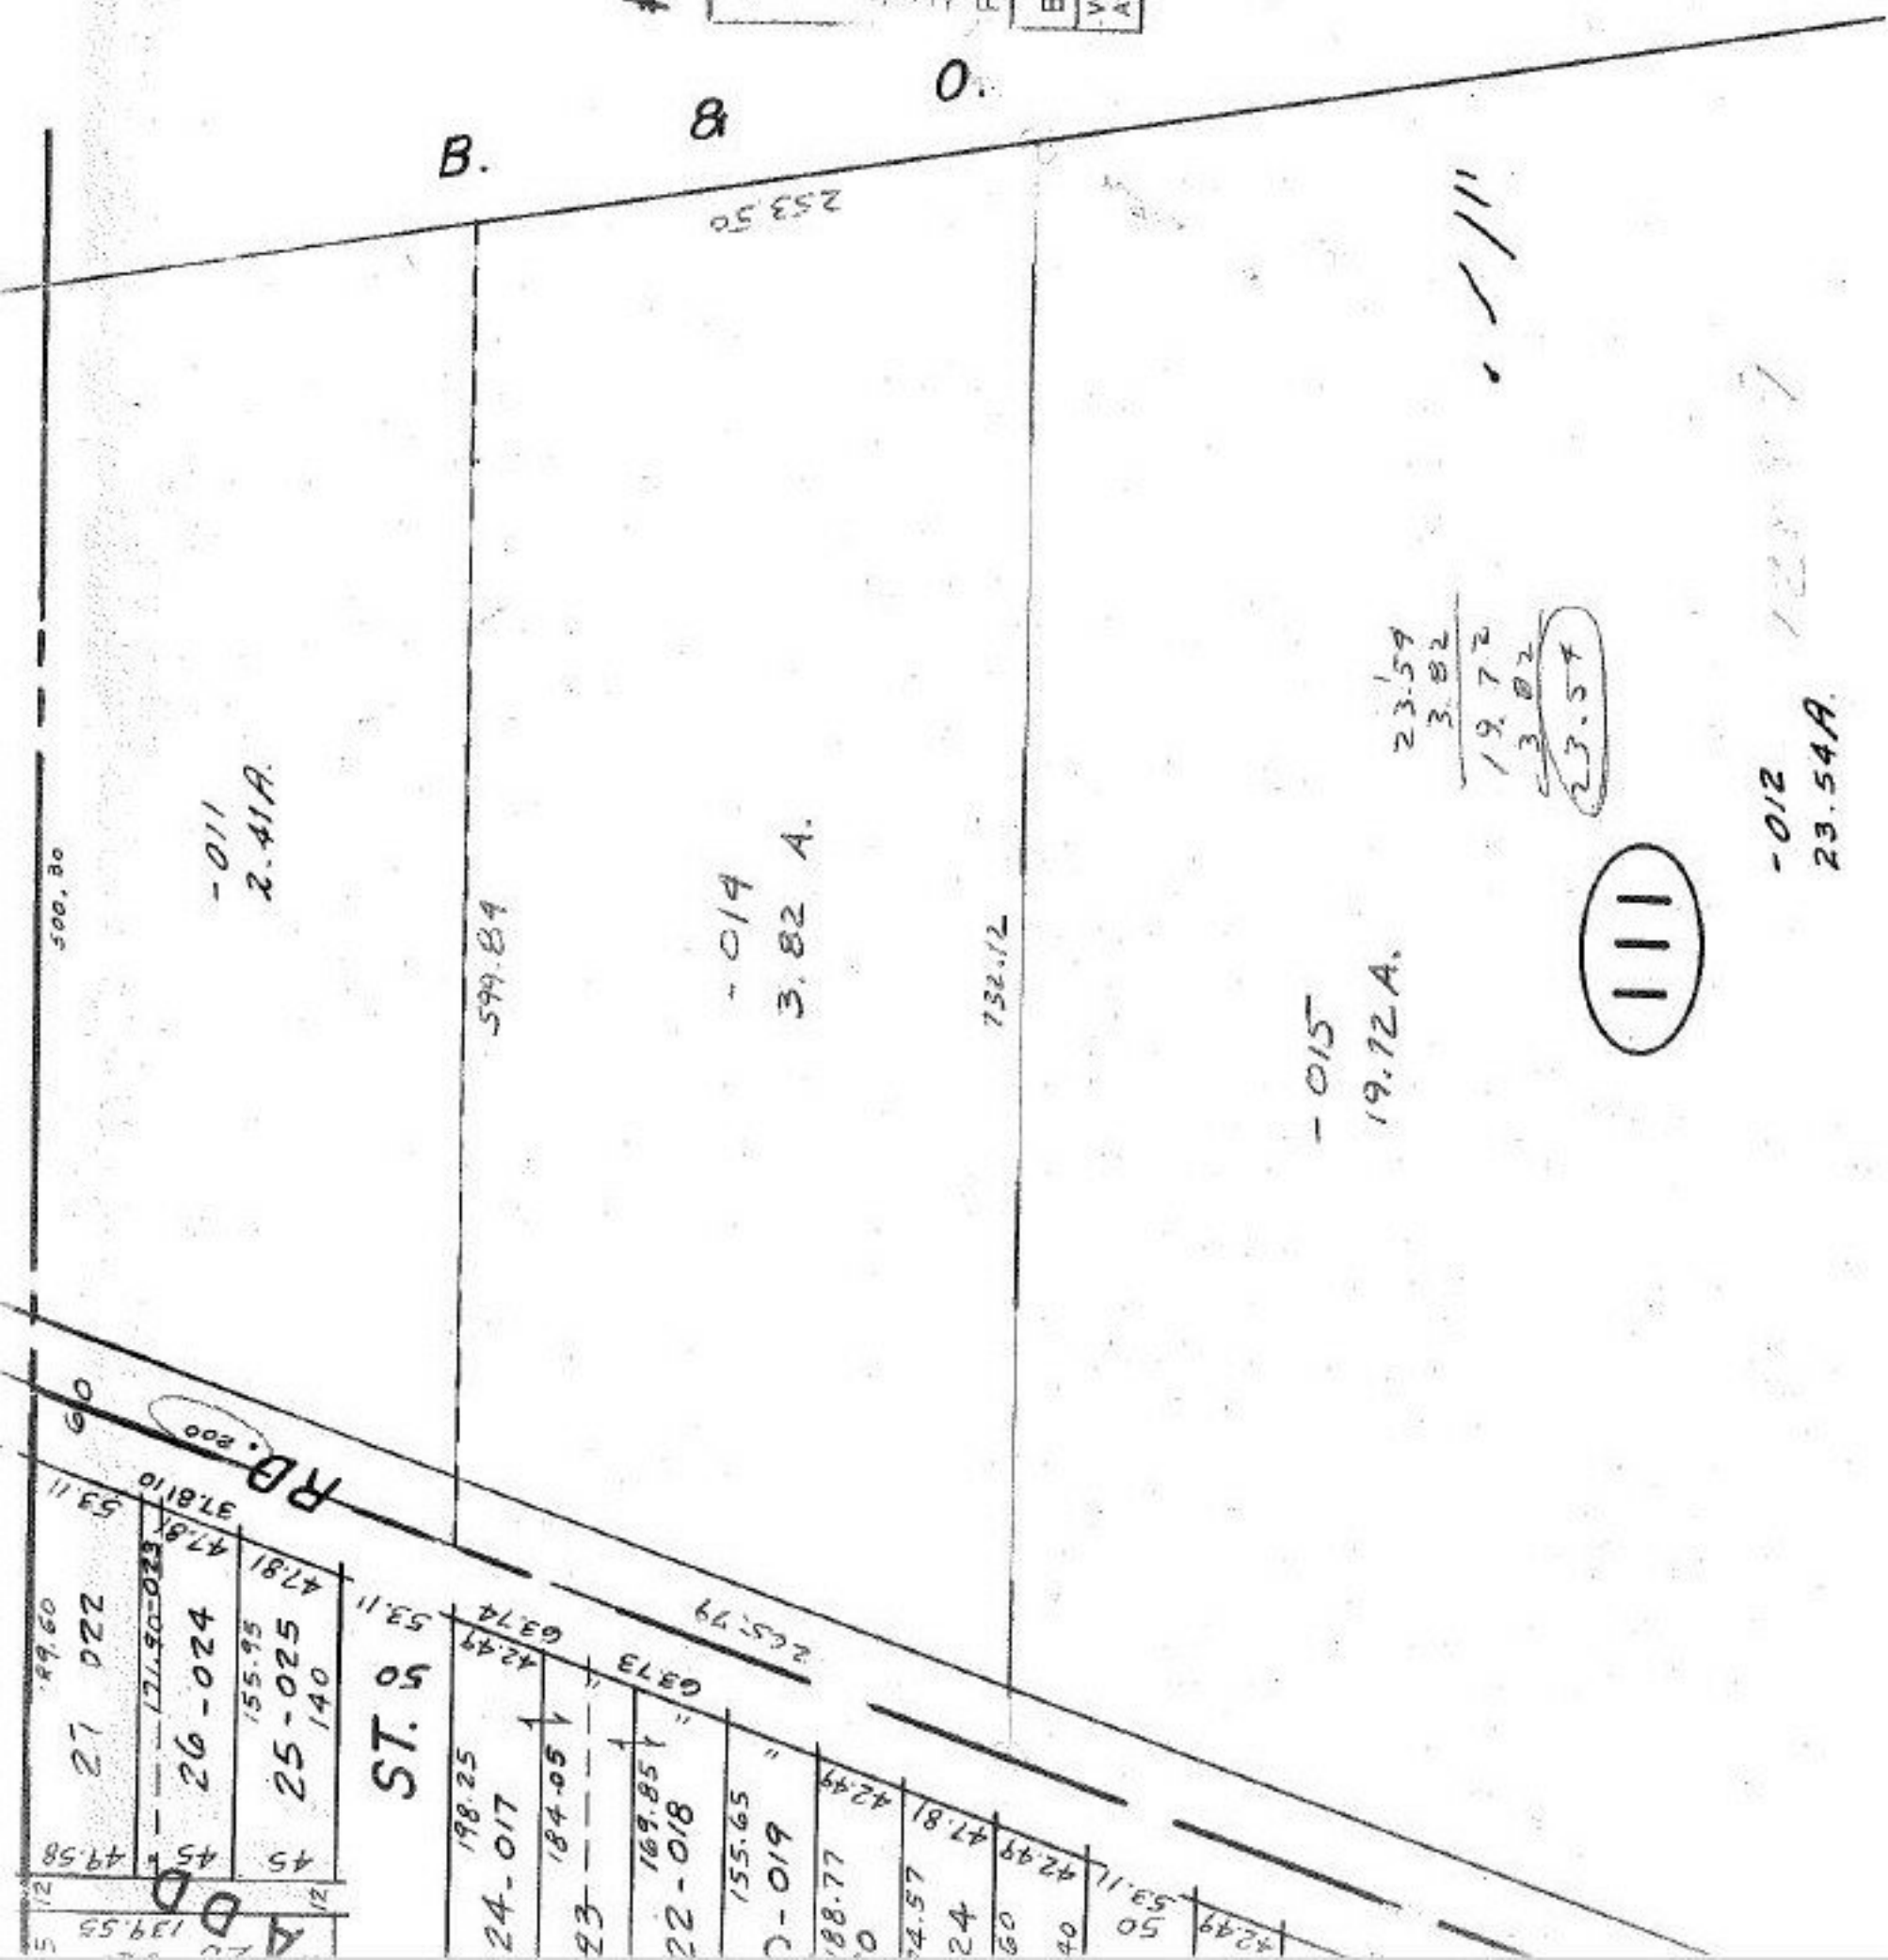
NOV 1 1979