#12907

NOTE: ALL DIMENSIONS ON CURVES ARE ARCS.

#12907

APPROVED
LORAIN CO.
MAP DEPT.

DATE 7-20-79

PAGE 3-00-063

BY T. McMann

VOID AFTER
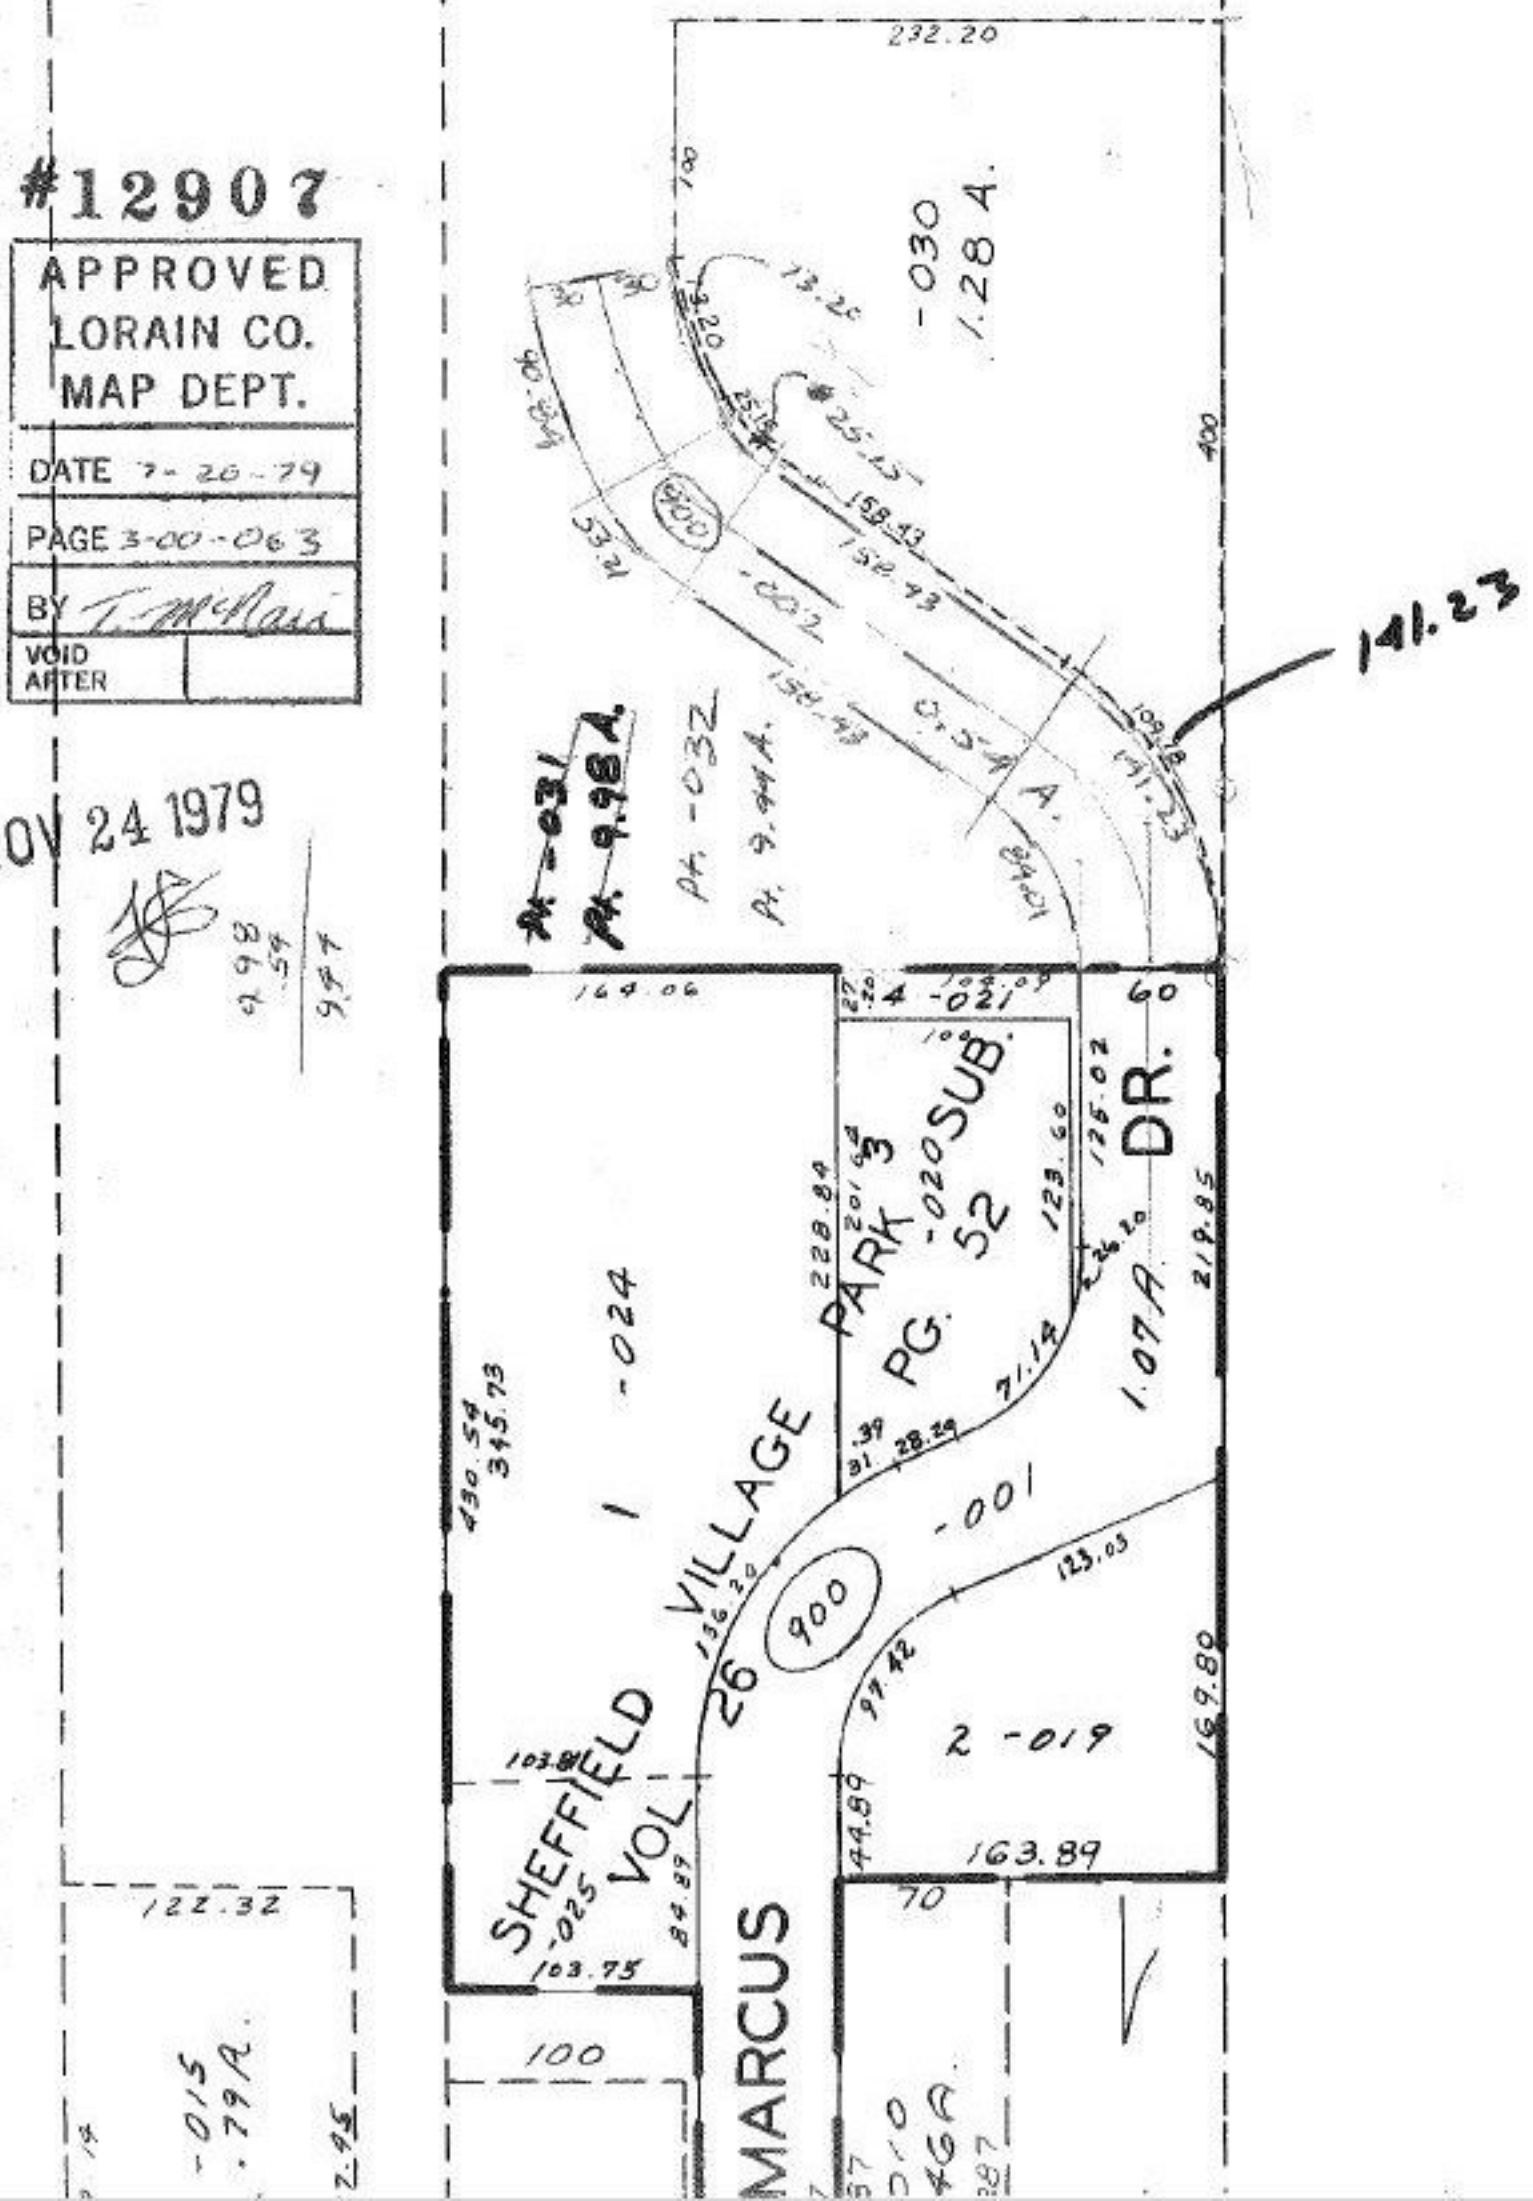
NOV 24 1979