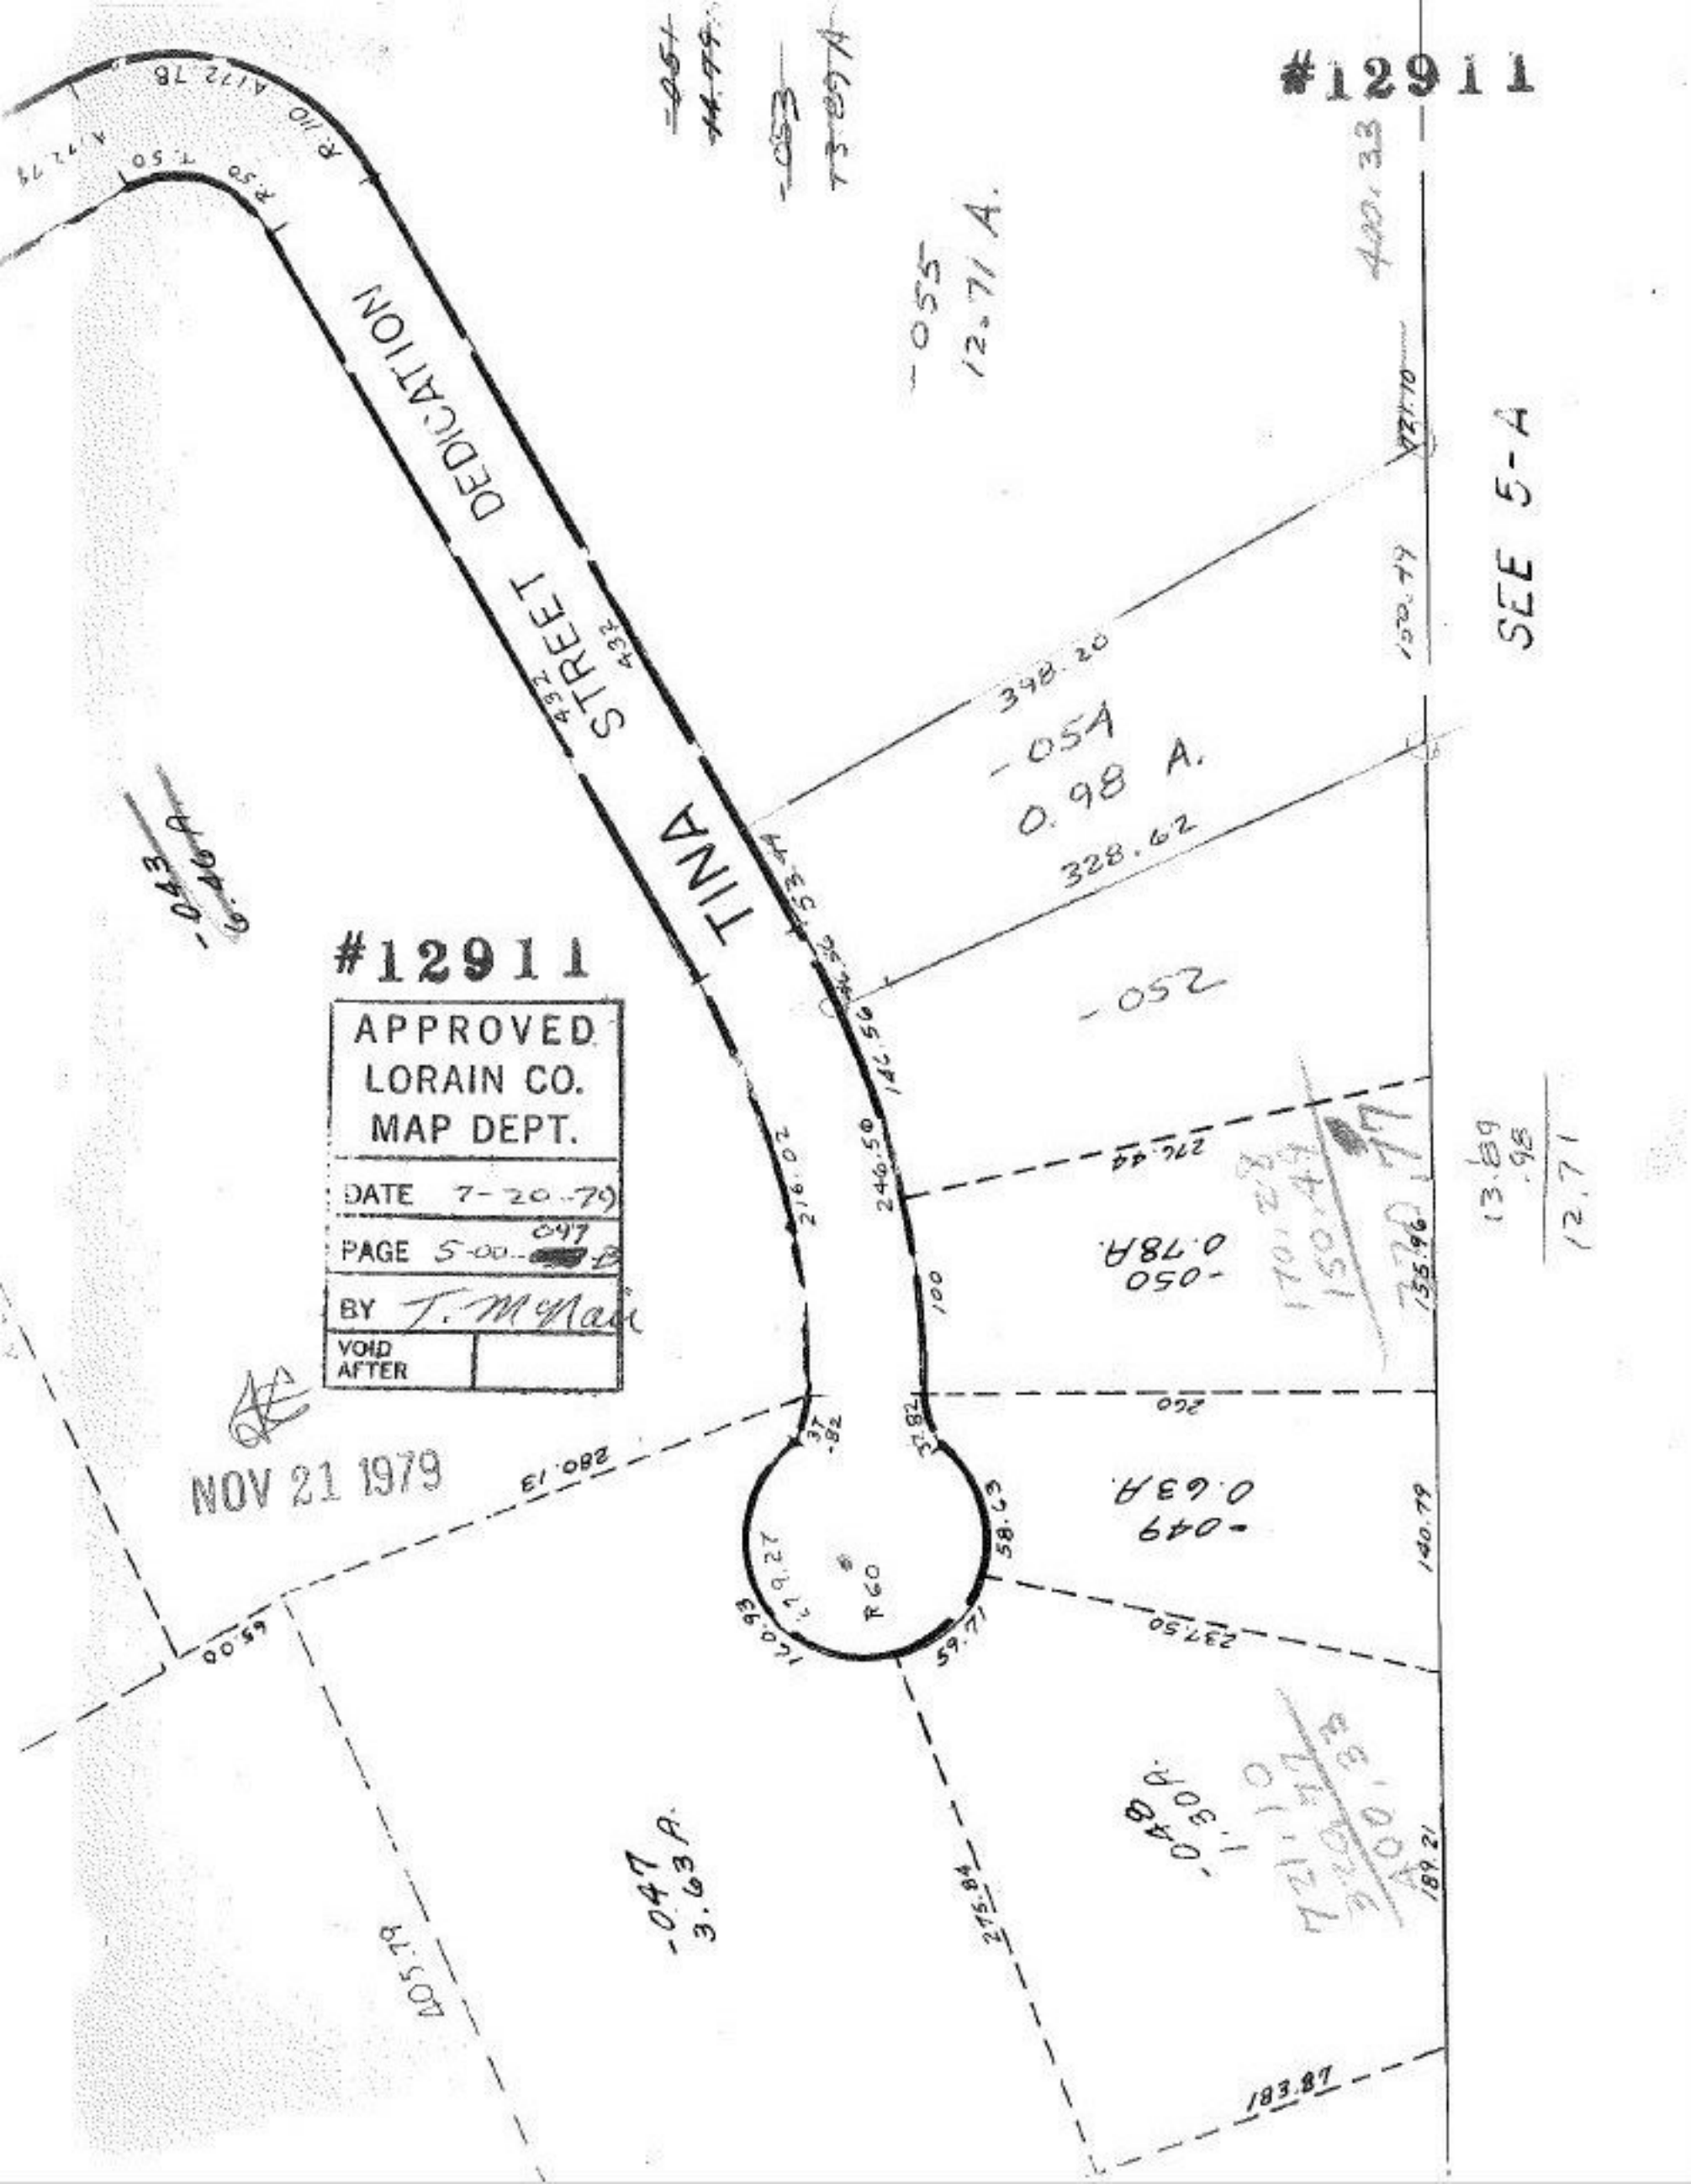
#12911
TINA STREET DEDICATION
-055
12.71 A.
-054
0.98 A.
-052
-050
0.78A.
-049
0.63A.
-048
1.30A.
-047
3.63A.
SEE 5-A
348.20
328.62
216.02
246.50
100
276.44
260
280.13
237.50
275.84
183.87
405.79
140.79
189.21
155.96
13.89
.98
12.71
R60
#12911
APPROVED
LORAIN CO.
MAP DEPT.
DATE 7-20-79
PAGE 5-00-047
BY T. McNair
VOID AFTER
NOV 21 1979