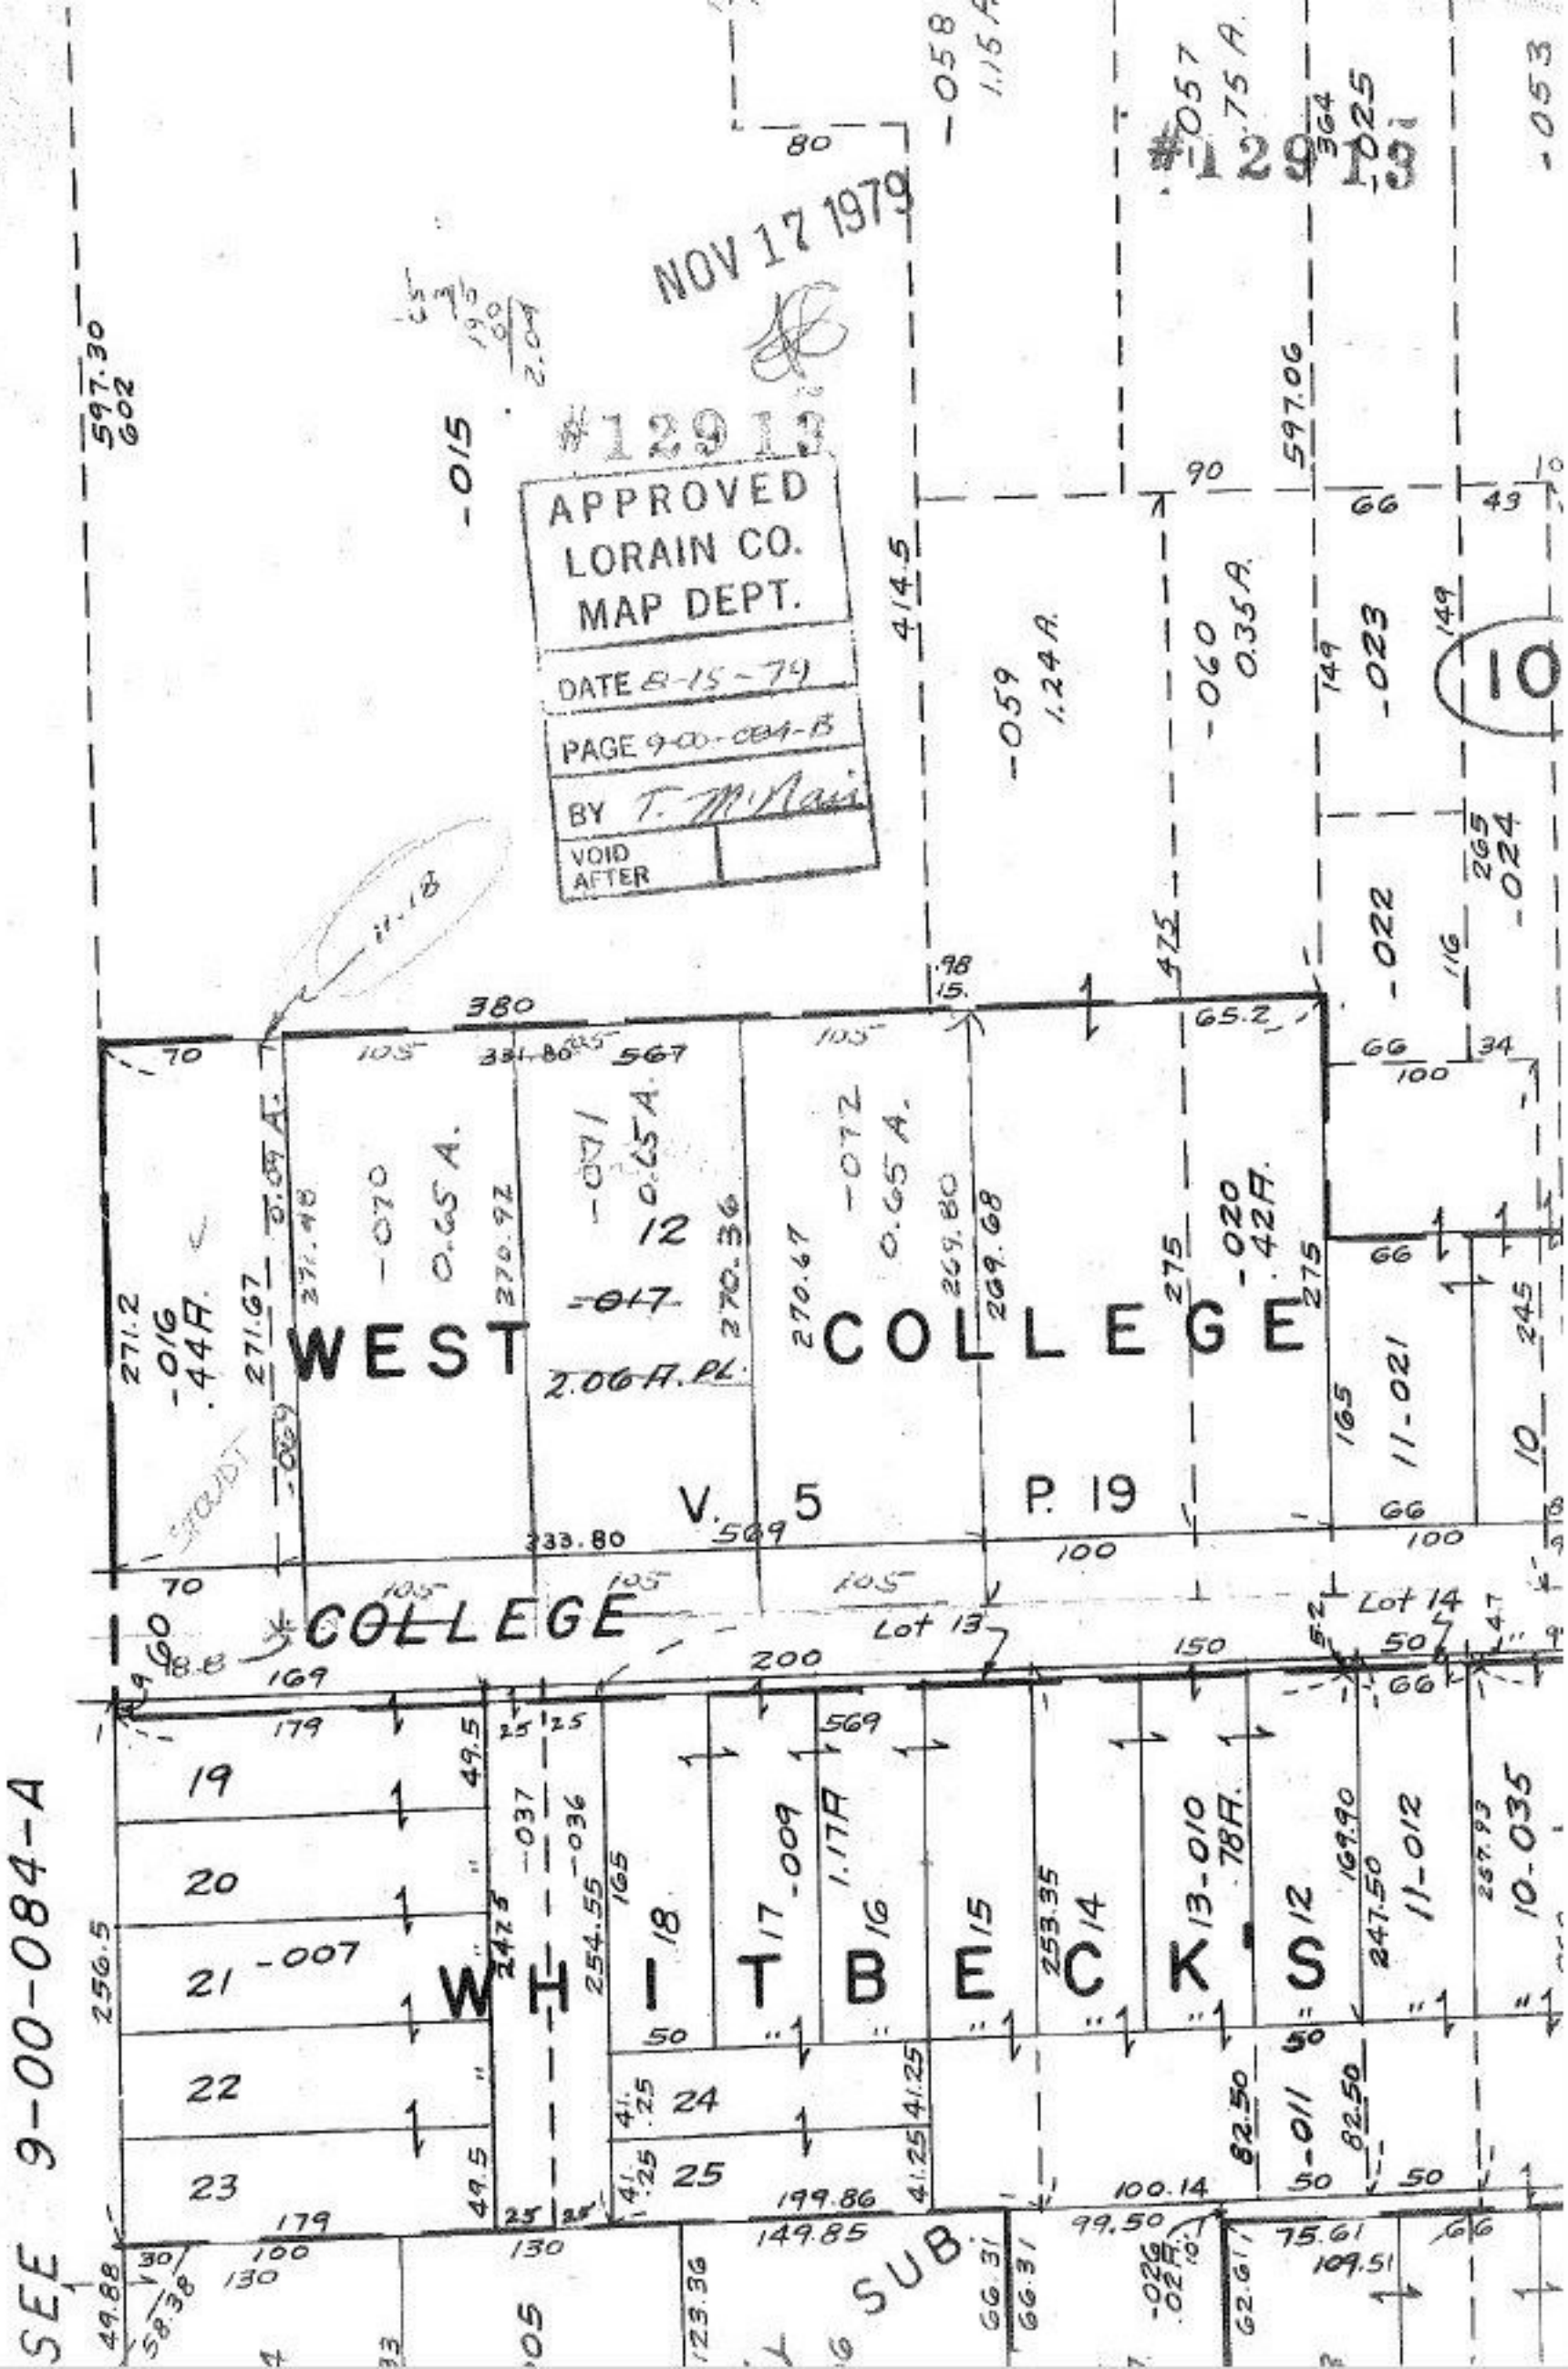

NOV 17 1979
#12913
APPROVED
LORAIN CO.
MAP DEPT.
DATE 8-15-79
PAGE 9-00-084-B
BY T. McNair
VOID AFTER
WEST COLLEGE
V. 5 P. 19
COLLEGE
Lot 13
Lot 14
WHITBECK'S
SUB.
SEE 9-00-084-A