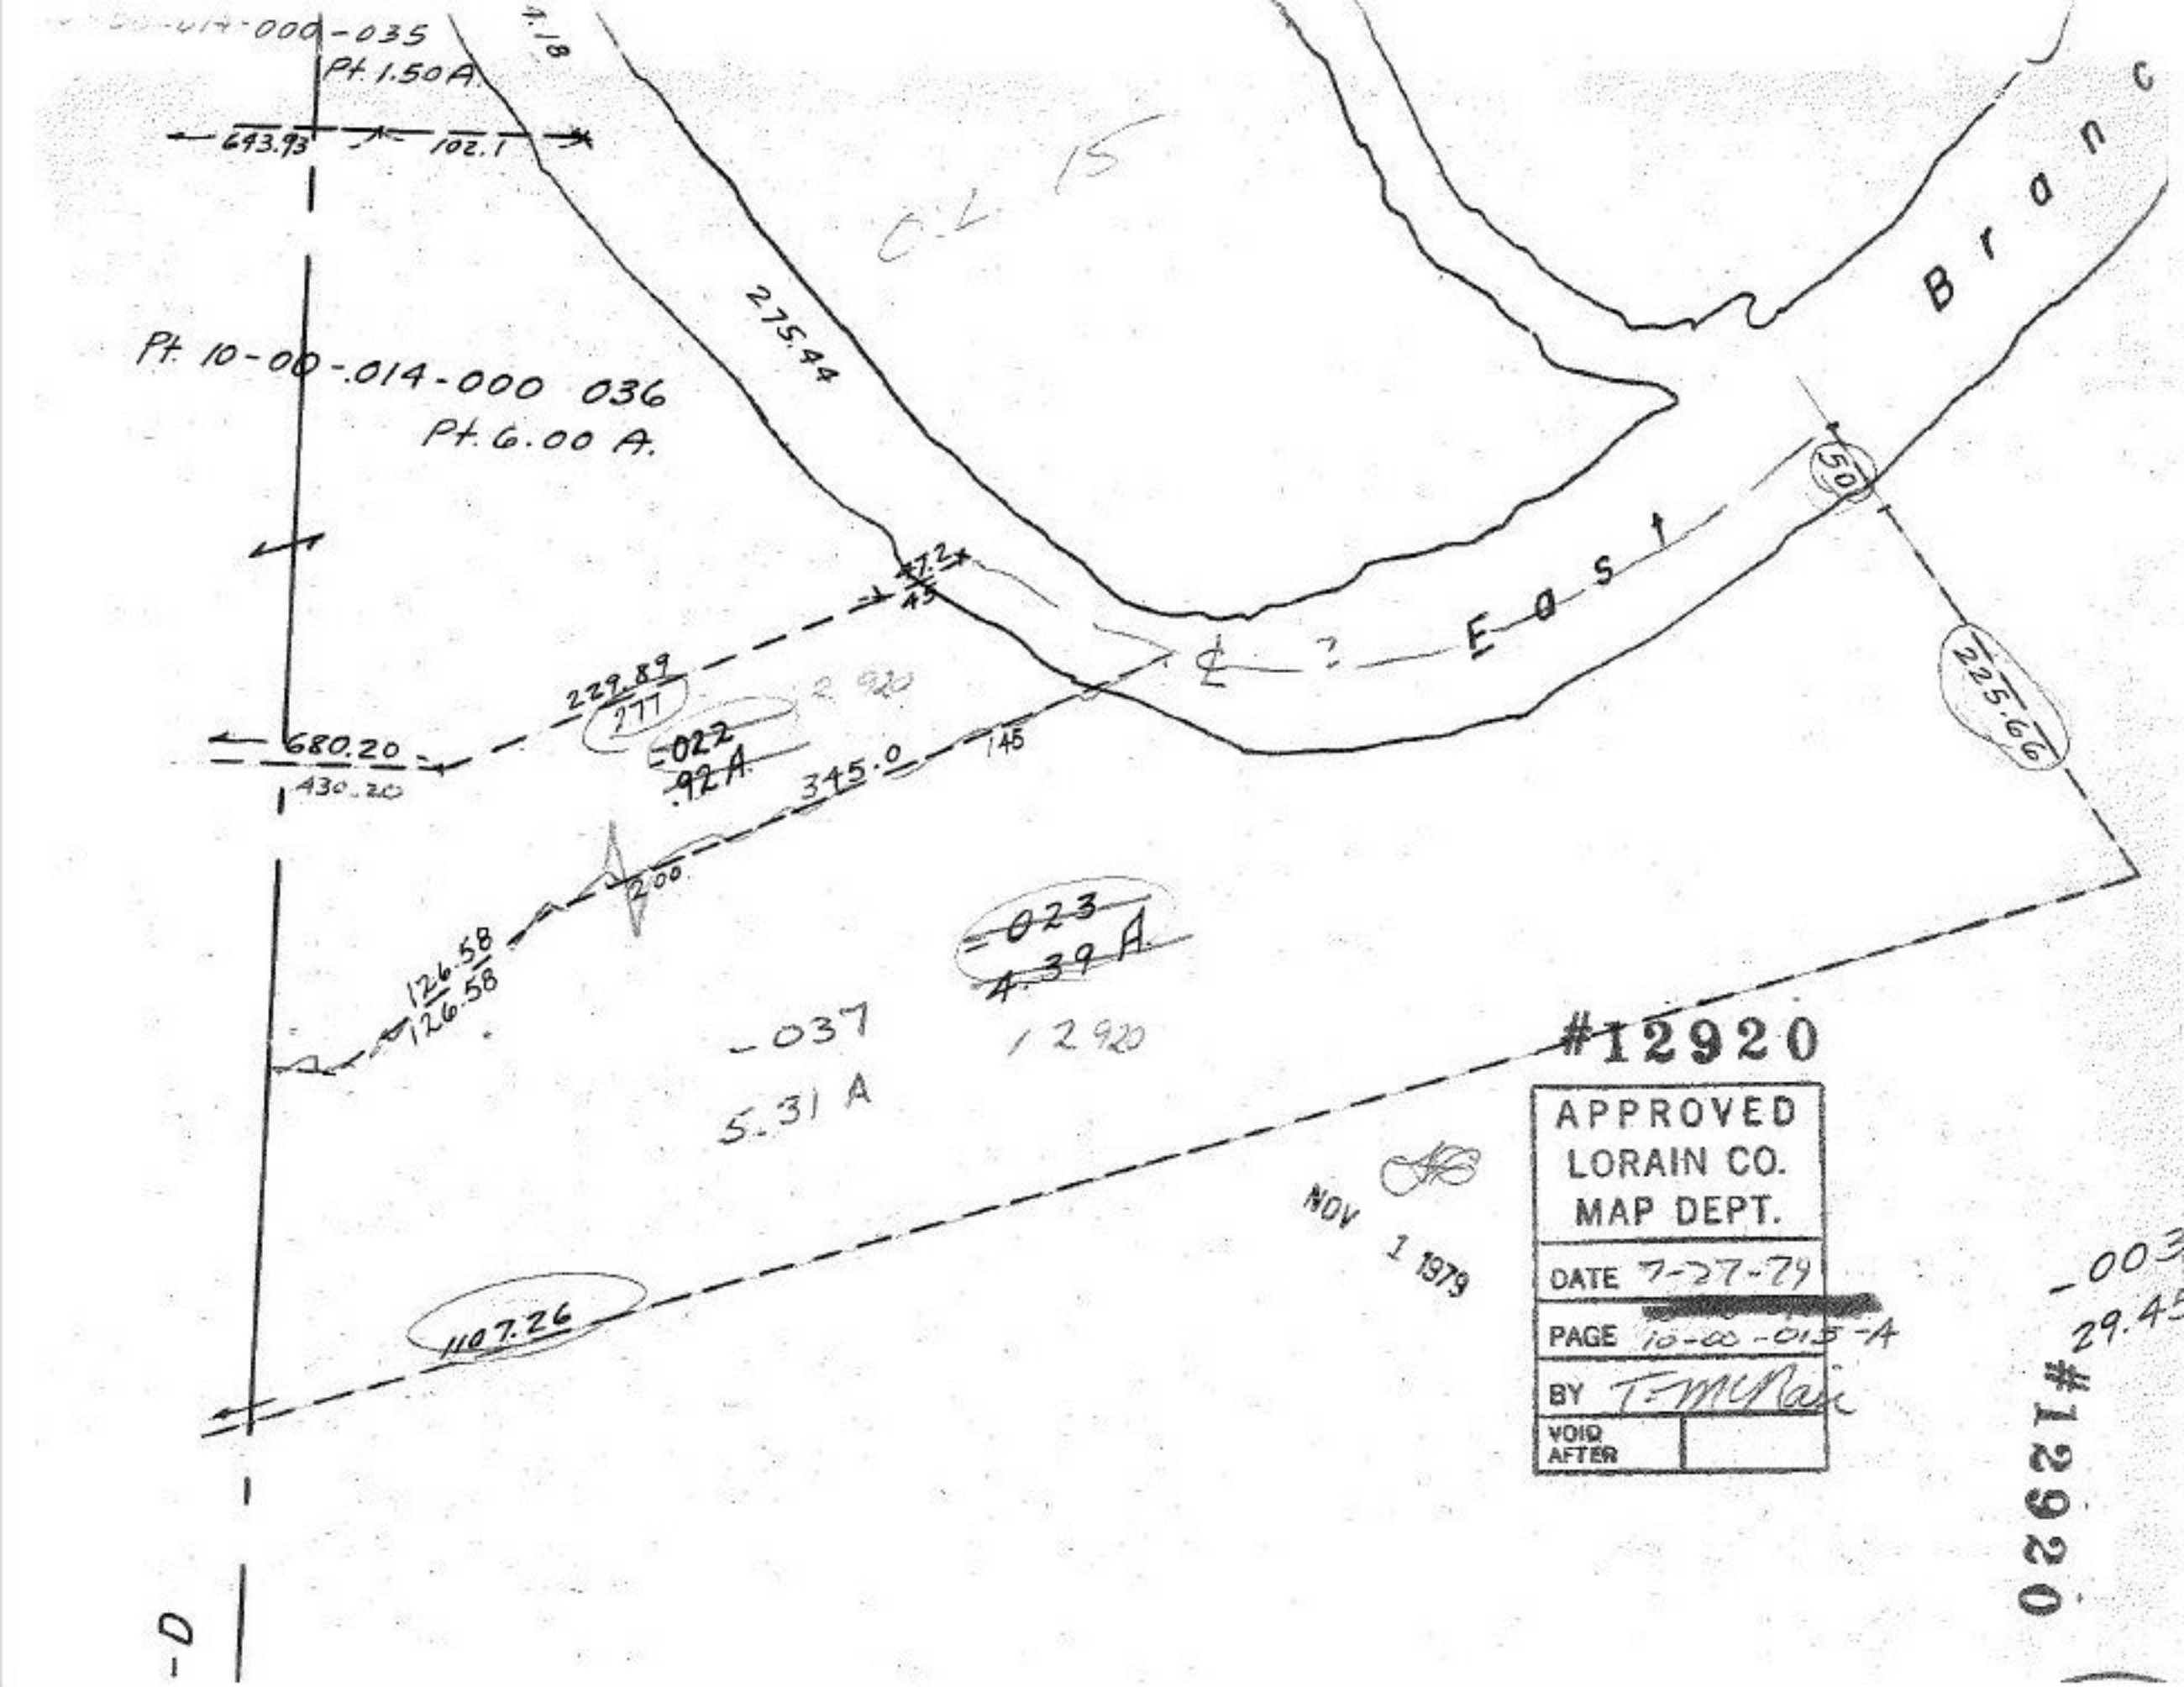

-014-000-035
Pt. 1.50 A.
643.93
102.1
Pt. 10-00-.014-000 036
Pt. 6.00 A.
275.44
O.L. 15
Branc
East
50
225.66
47.2
45
229.89
277
680.20
430.20
-022
.92 A.
345.0
145
200
126.58
126.58
-023
4.39 A.
12920
-037
5.31 A
1107.26
-003
29.45
#12920
APPROVED
LORAIN CO.
MAP DEPT.
DATE 7-27-79
PAGE 10-00-015-A
BY T. McNair
VOID AFTER
NOV 1 1979
#12920