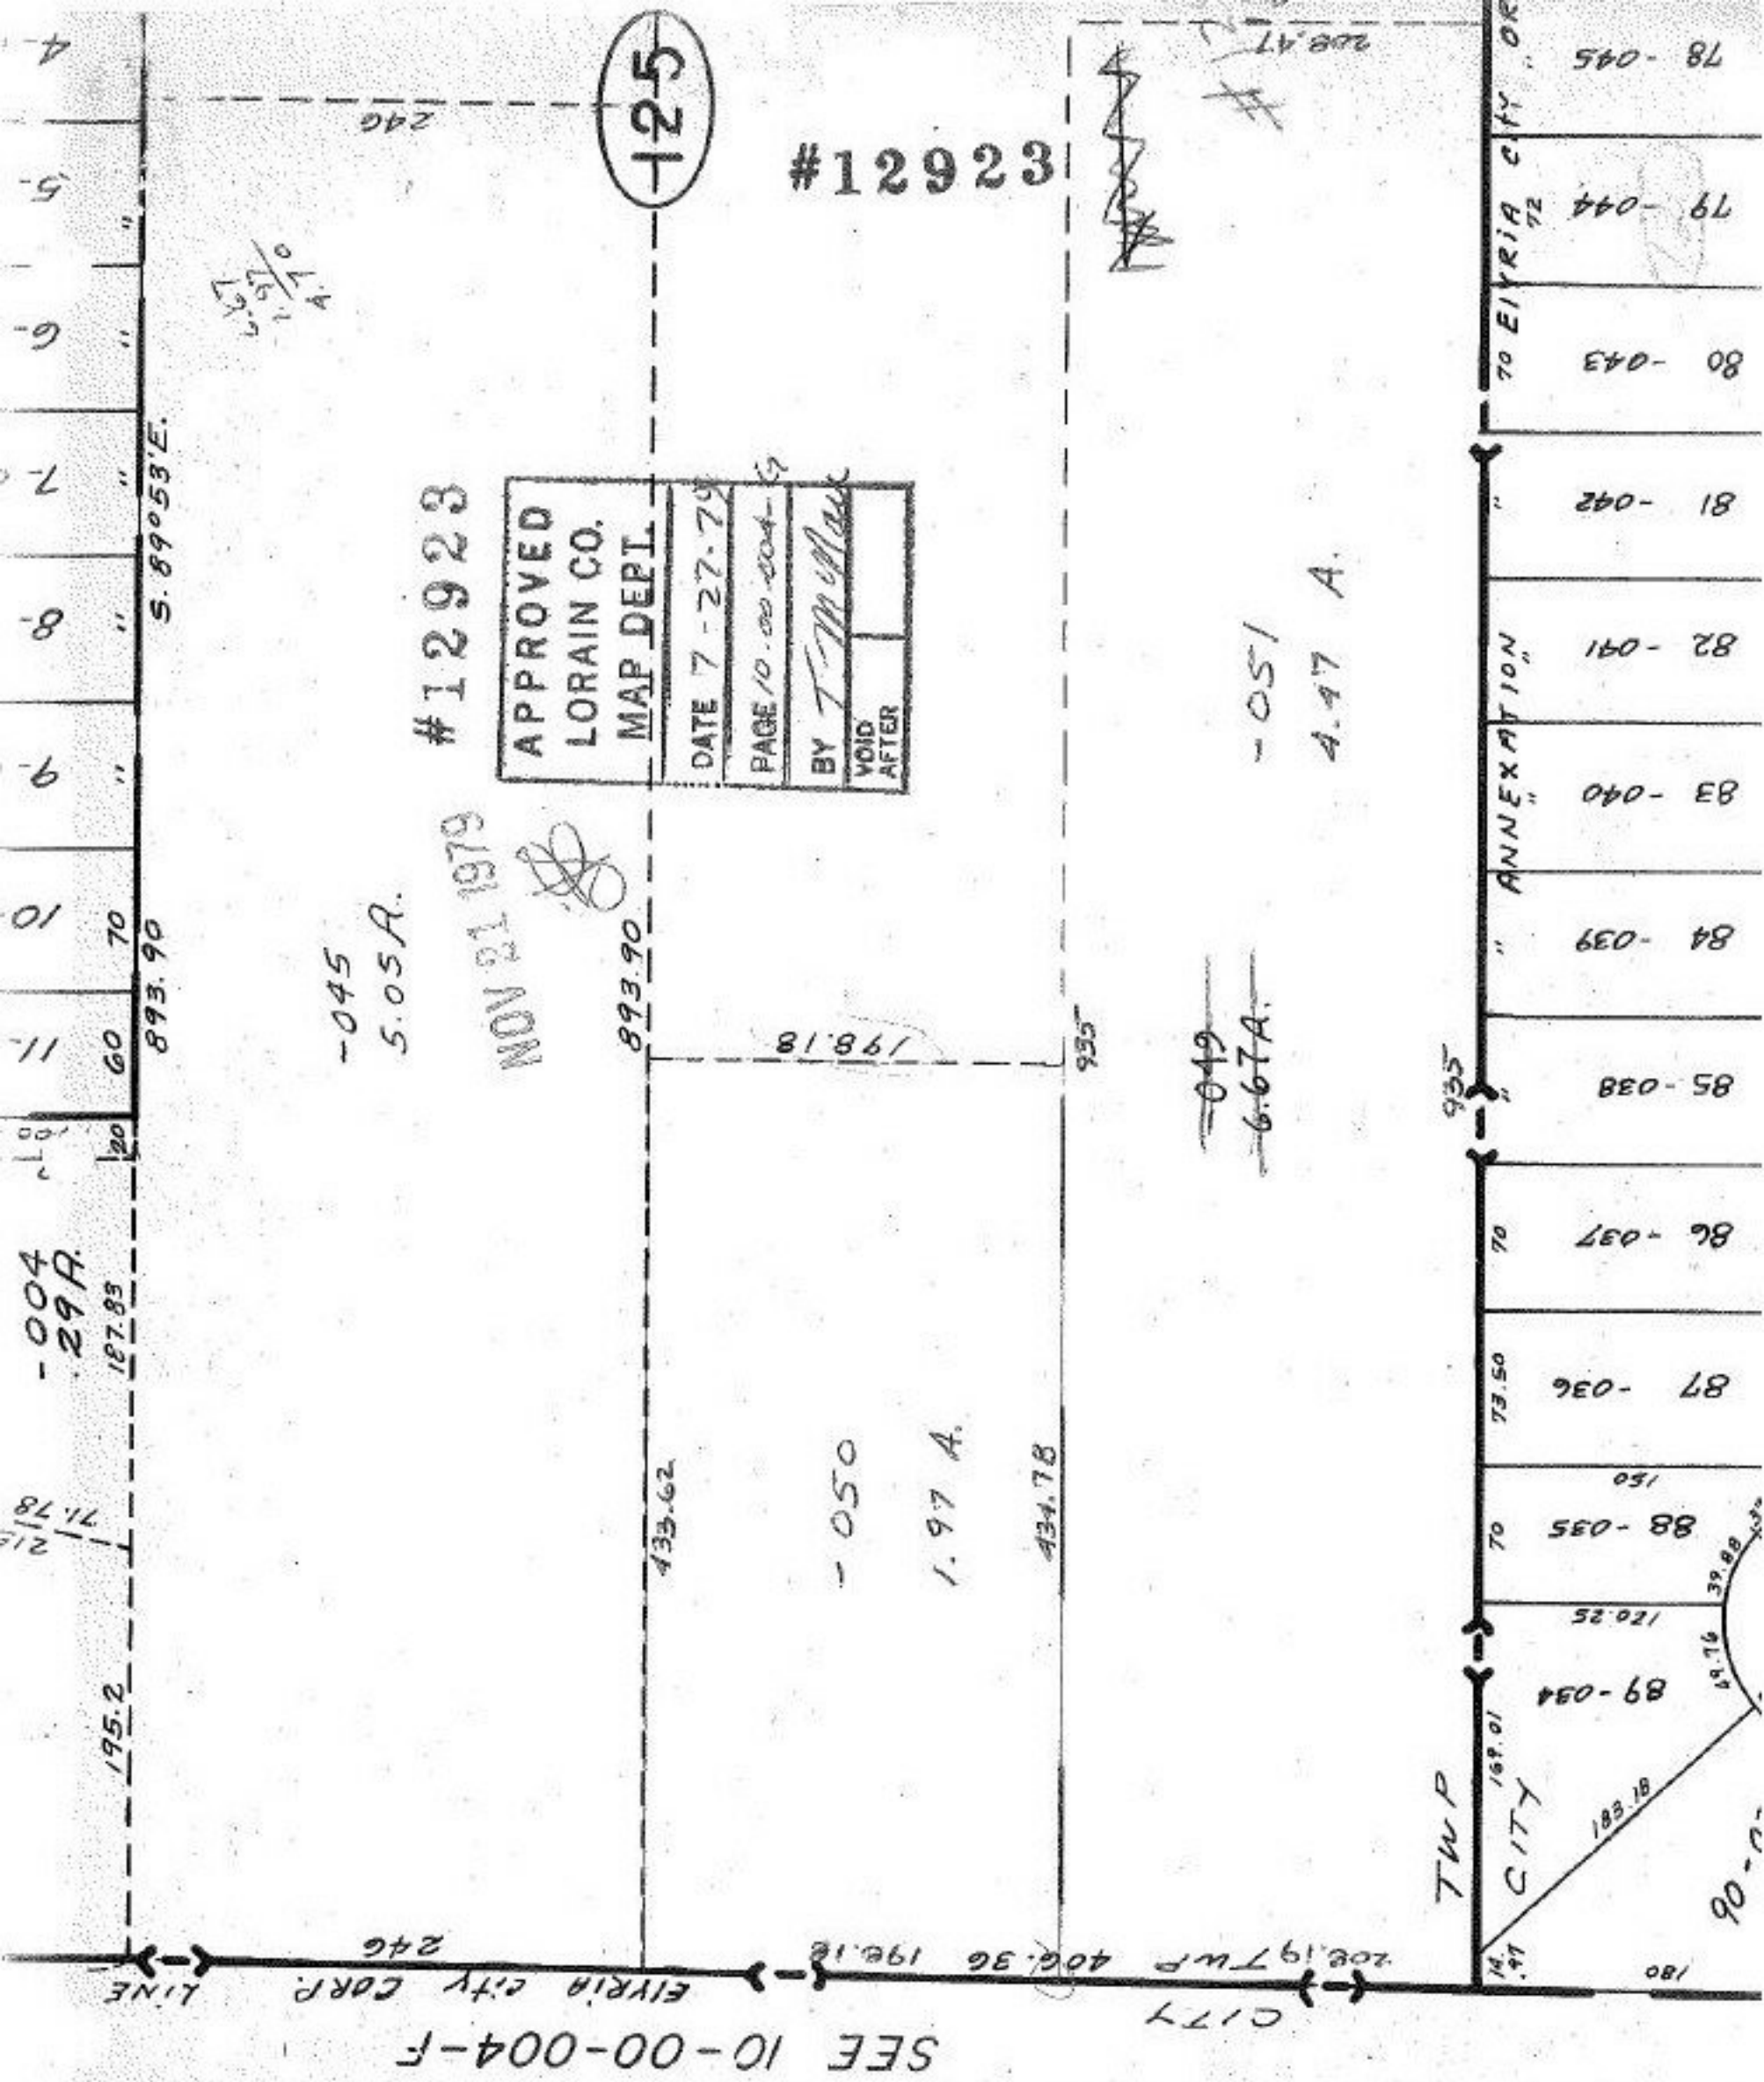

#12923
125
APPROVED
LORAIN CO.
MAP DEPT.
DATE 7-27-79
PAGE 10-00-004-G
BY
VOID AFTER
#12923
NOV 21 1979
-045
5.05 A.
-051
4.47 A.
-049
6.67 A.
-050
1.97 A.
-004
29 A.
S. 89°53' E.
893.90
198.18
433.62
434.78
195.2
187.83
208.47
246
ANNEXATION
ELYRIA CITY
TWP
CITY
LINE
ELYRIA CITY CORP.
SEE 10-00-004-F