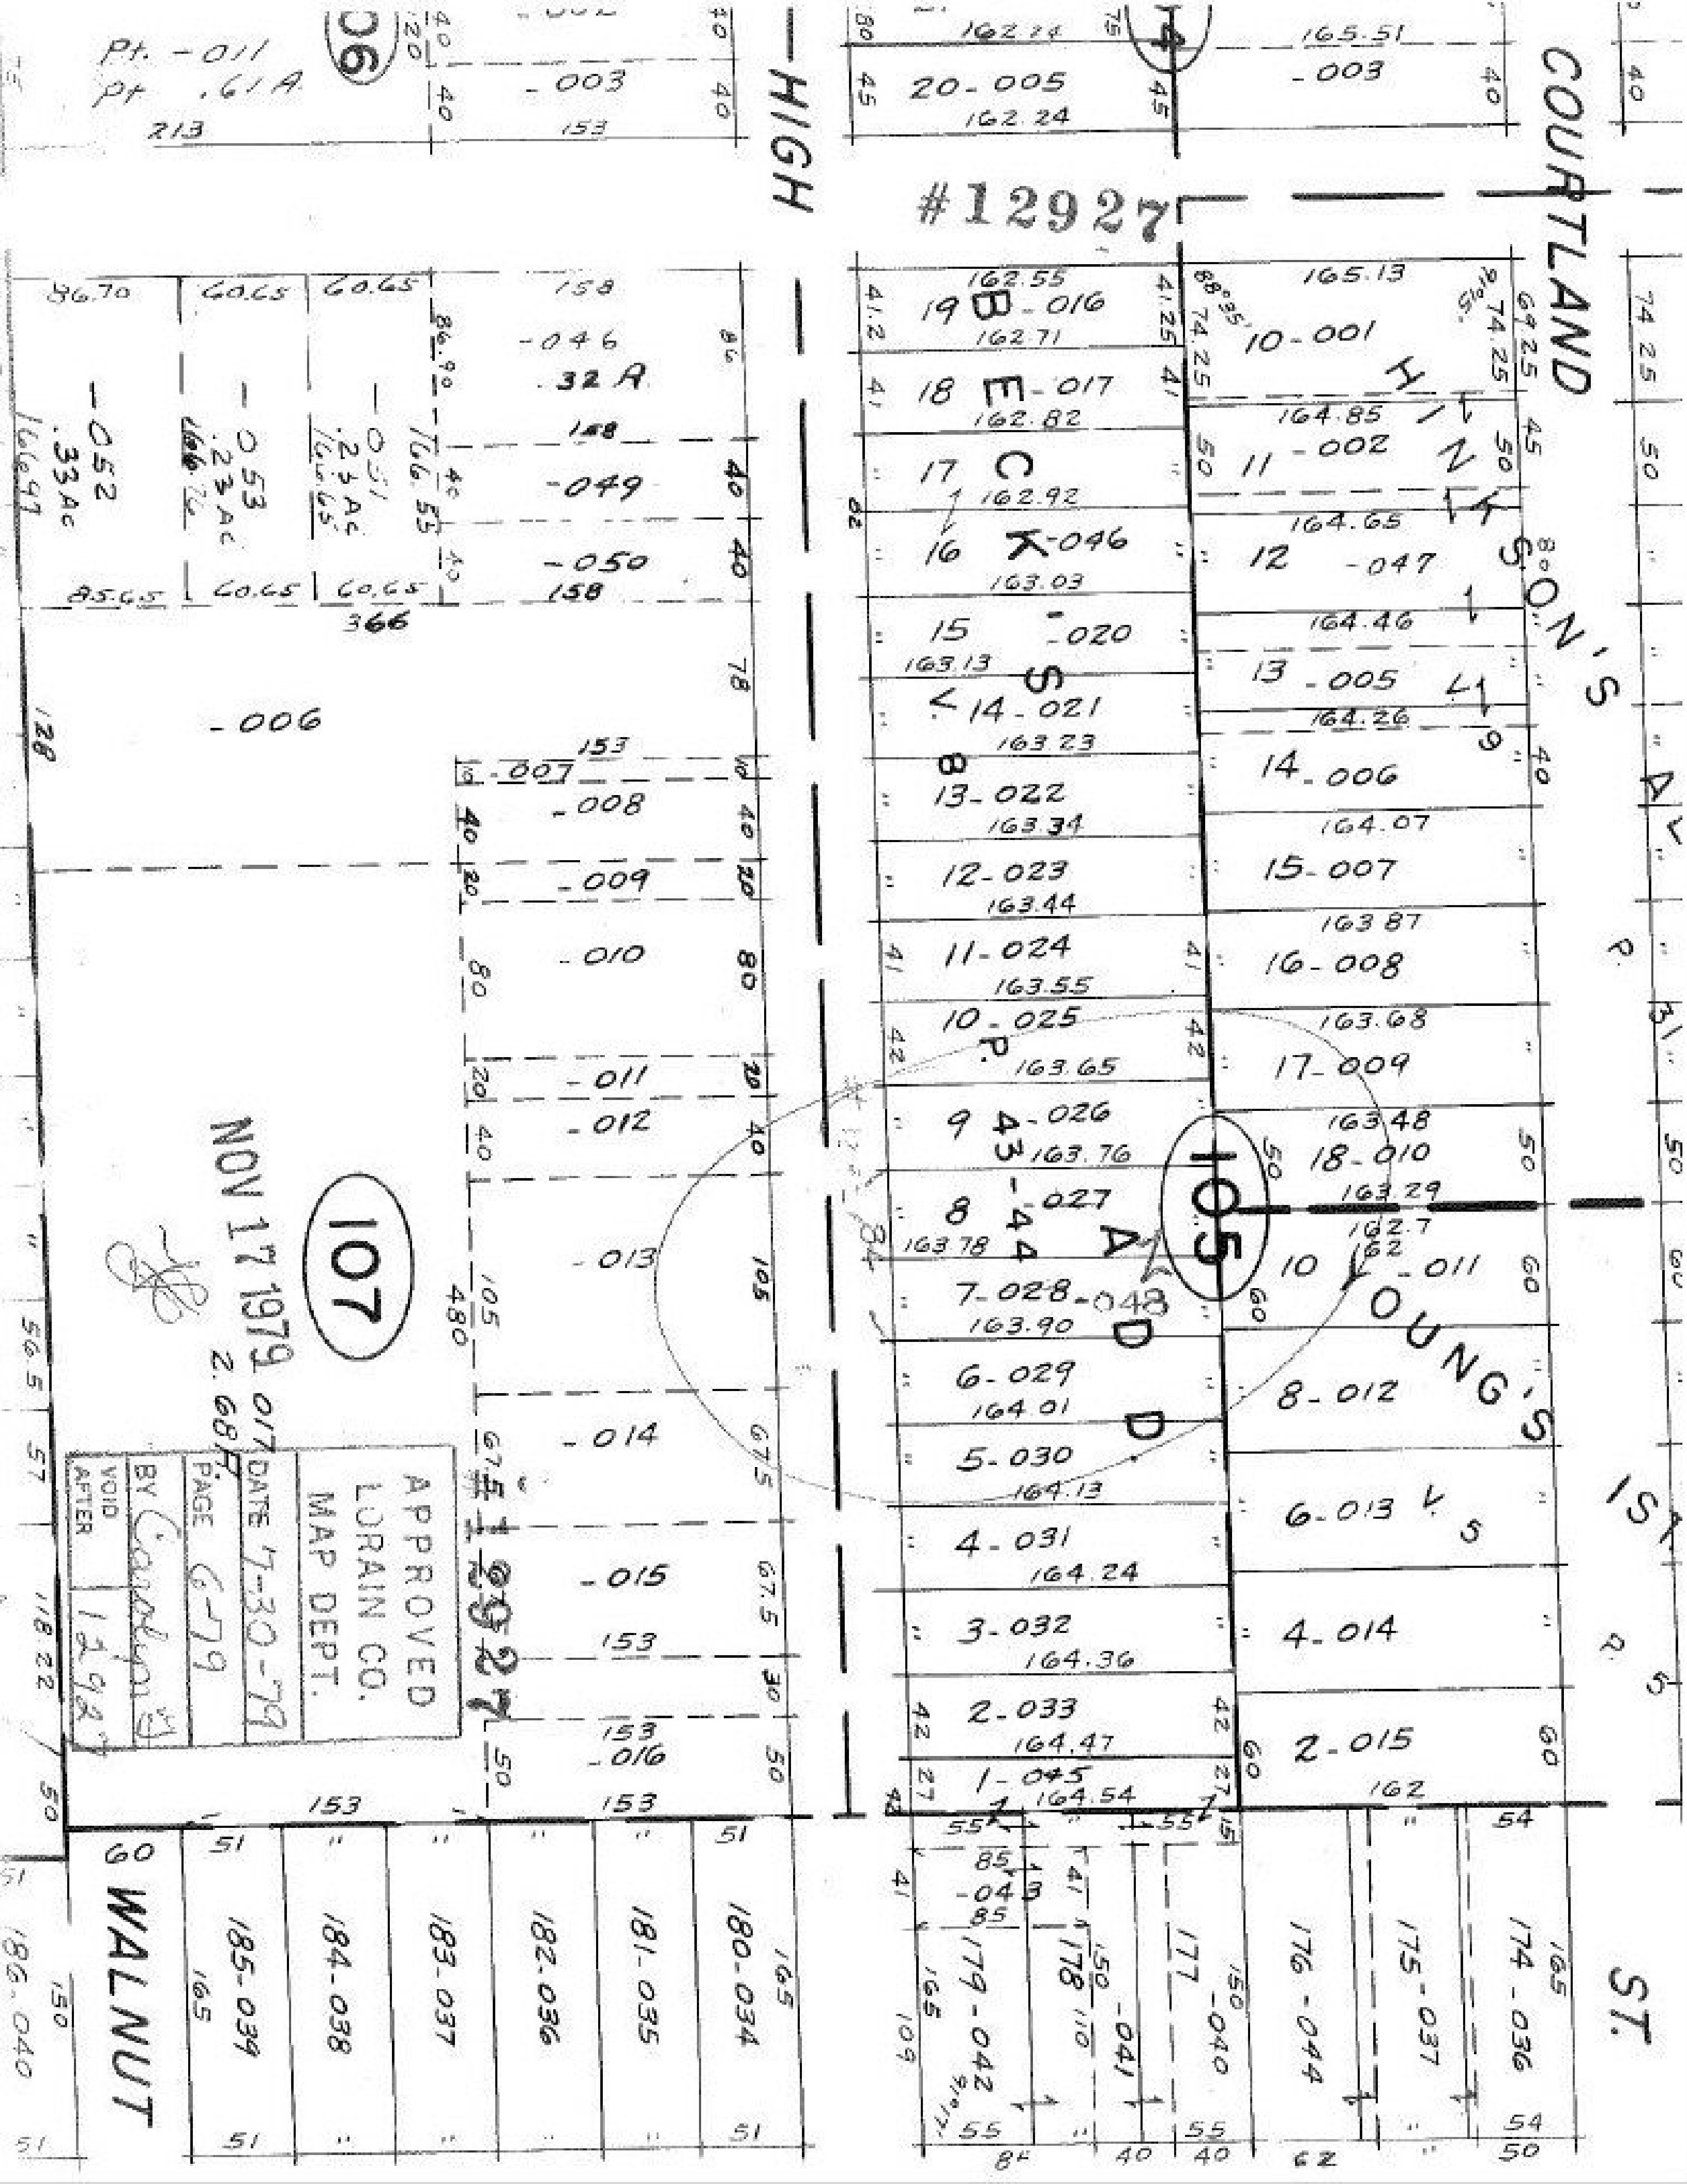

#12927
HIGH
COURTLAND
WALNUT
ST.
BECK'S SUB.
HINKSON'S ALLOT.
YOUNG'S 1ST ADD.
107
105
NOV 17 1979
APPROVED LORAIN CO. MAP DEPT.
DATE 7-30-79
PAGE 6-79
BY
VOID AFTER
Pt. -011
Pt. .61 A
-003
20-005
10-001
11-002
12-047
13-005
14-006
15-007
16-008
17-009
18-010
10-011
8-012
6-013
4-014
2-015
19-016
18-017
17
16-046
15-020
14-021
13-022
12-023
11-024
10-025
9-026
8-027
7-028
-048
6-029
5-030
4-031
3-032
2-033
1-045
-043
-046
.32 A
-049
-050
-052
.33 Ac
-053
.23 Ac
-051
.23 Ac
366
-006
-007
-008
-009
-010
-011
-012
-013
-014
-015
-016
480
2.68 A
185-039
184-038
183-037
182-036
181-035
180-034
186-040
179-042
178
-041
177
-040
176-044
175-037
174-036