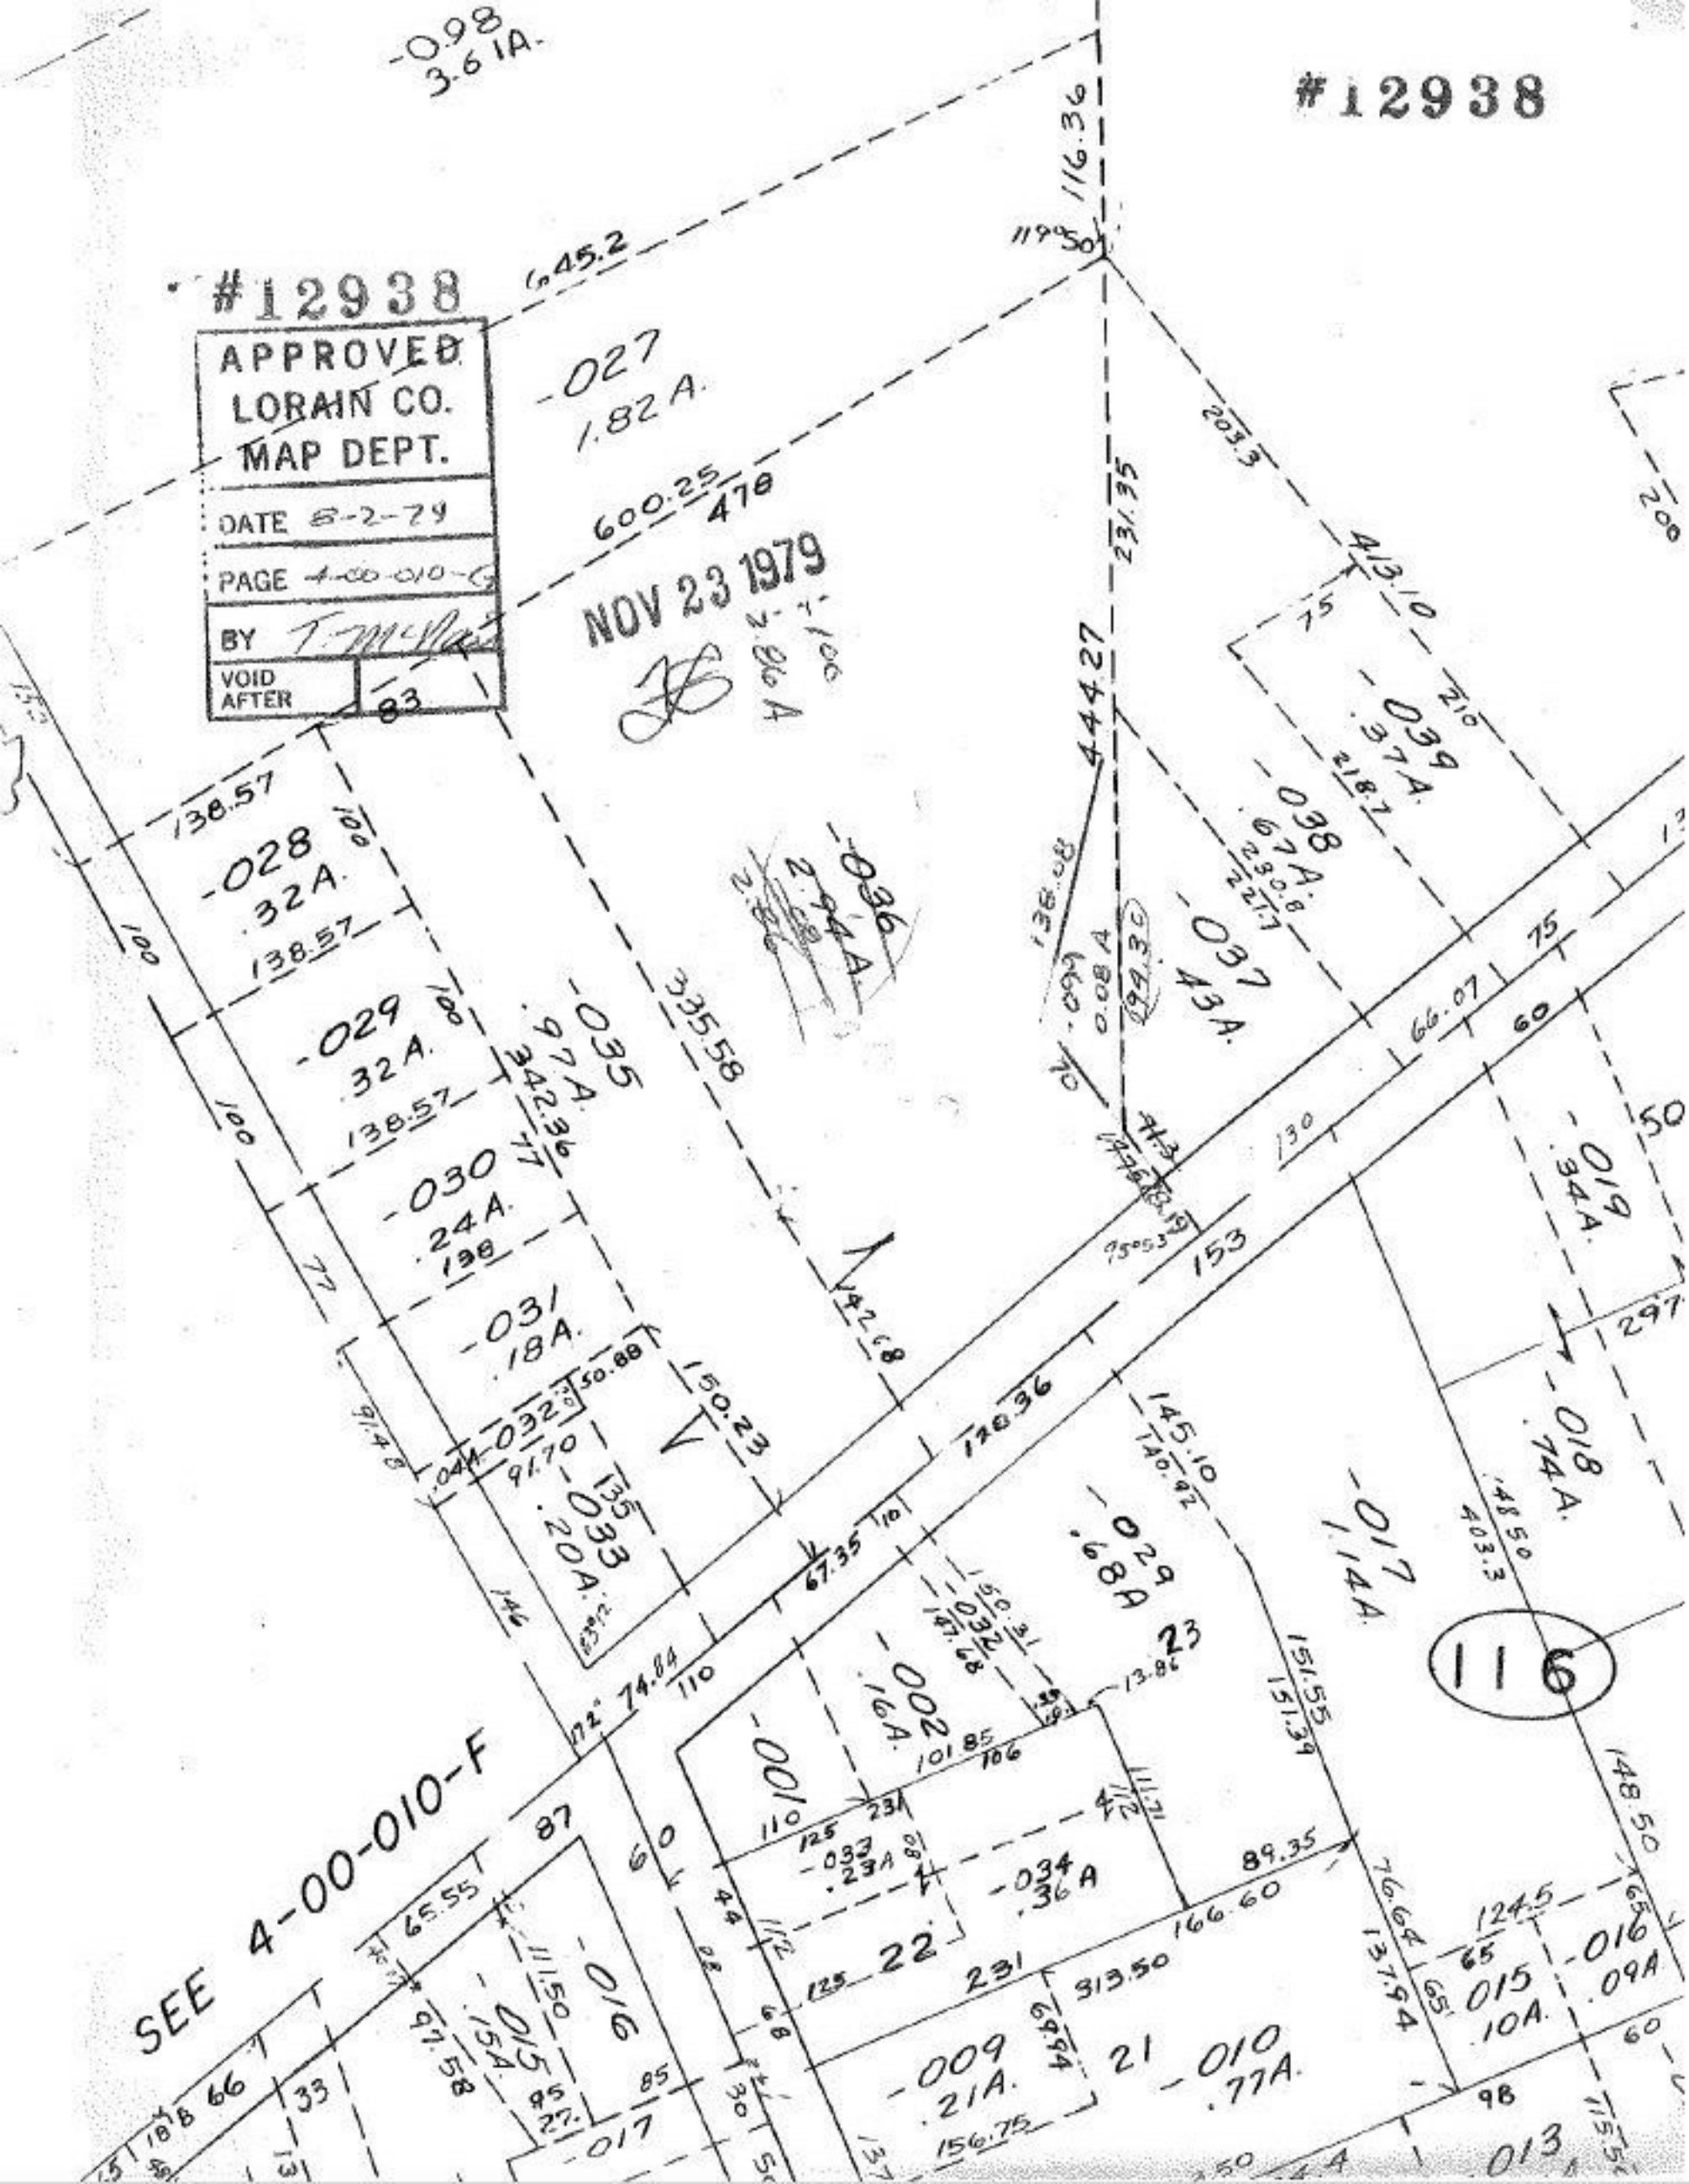
#12938
#12938
APPROVED
LORAIN CO.
MAP DEPT.
DATE 8-2-79
PAGE 4-00-010-G
BY
VOID AFTER
NOV 23 1979
SEE 4-00-010-F
116
-027
1.82 A.
-028
.32 A.
-029
.32 A.
-030
.24 A.
-031
.18 A.
-032
-033
.20 A.
-035
.97 A.
-036
2.94 A.
-037
.43 A.
-038
.67 A.
-039
.37 A.
-017
1.14 A.
-018
.74 A.
-019
.34 A.
-029
.68 A
-002
.16 A.
-001
-033
.23 A
-034
.36 A
-009
.21 A.
-010
.77 A.
-015
.10 A.
-016
.09 A
-016
-015
.15 A.
-017
-013
-0.98
3.61 A.
645.2
600.25
478
116.36
119°50'
444.27
231.35
203.3
413.10
138.57
335.58
150.23
142.68
128.36
145.10
151.55
151.39
166.60
89.35
313.50
156.75
74.84
67.35
65.55
97.58
111.50
66.07
148.50
403.3
124.5
137.94
76.64