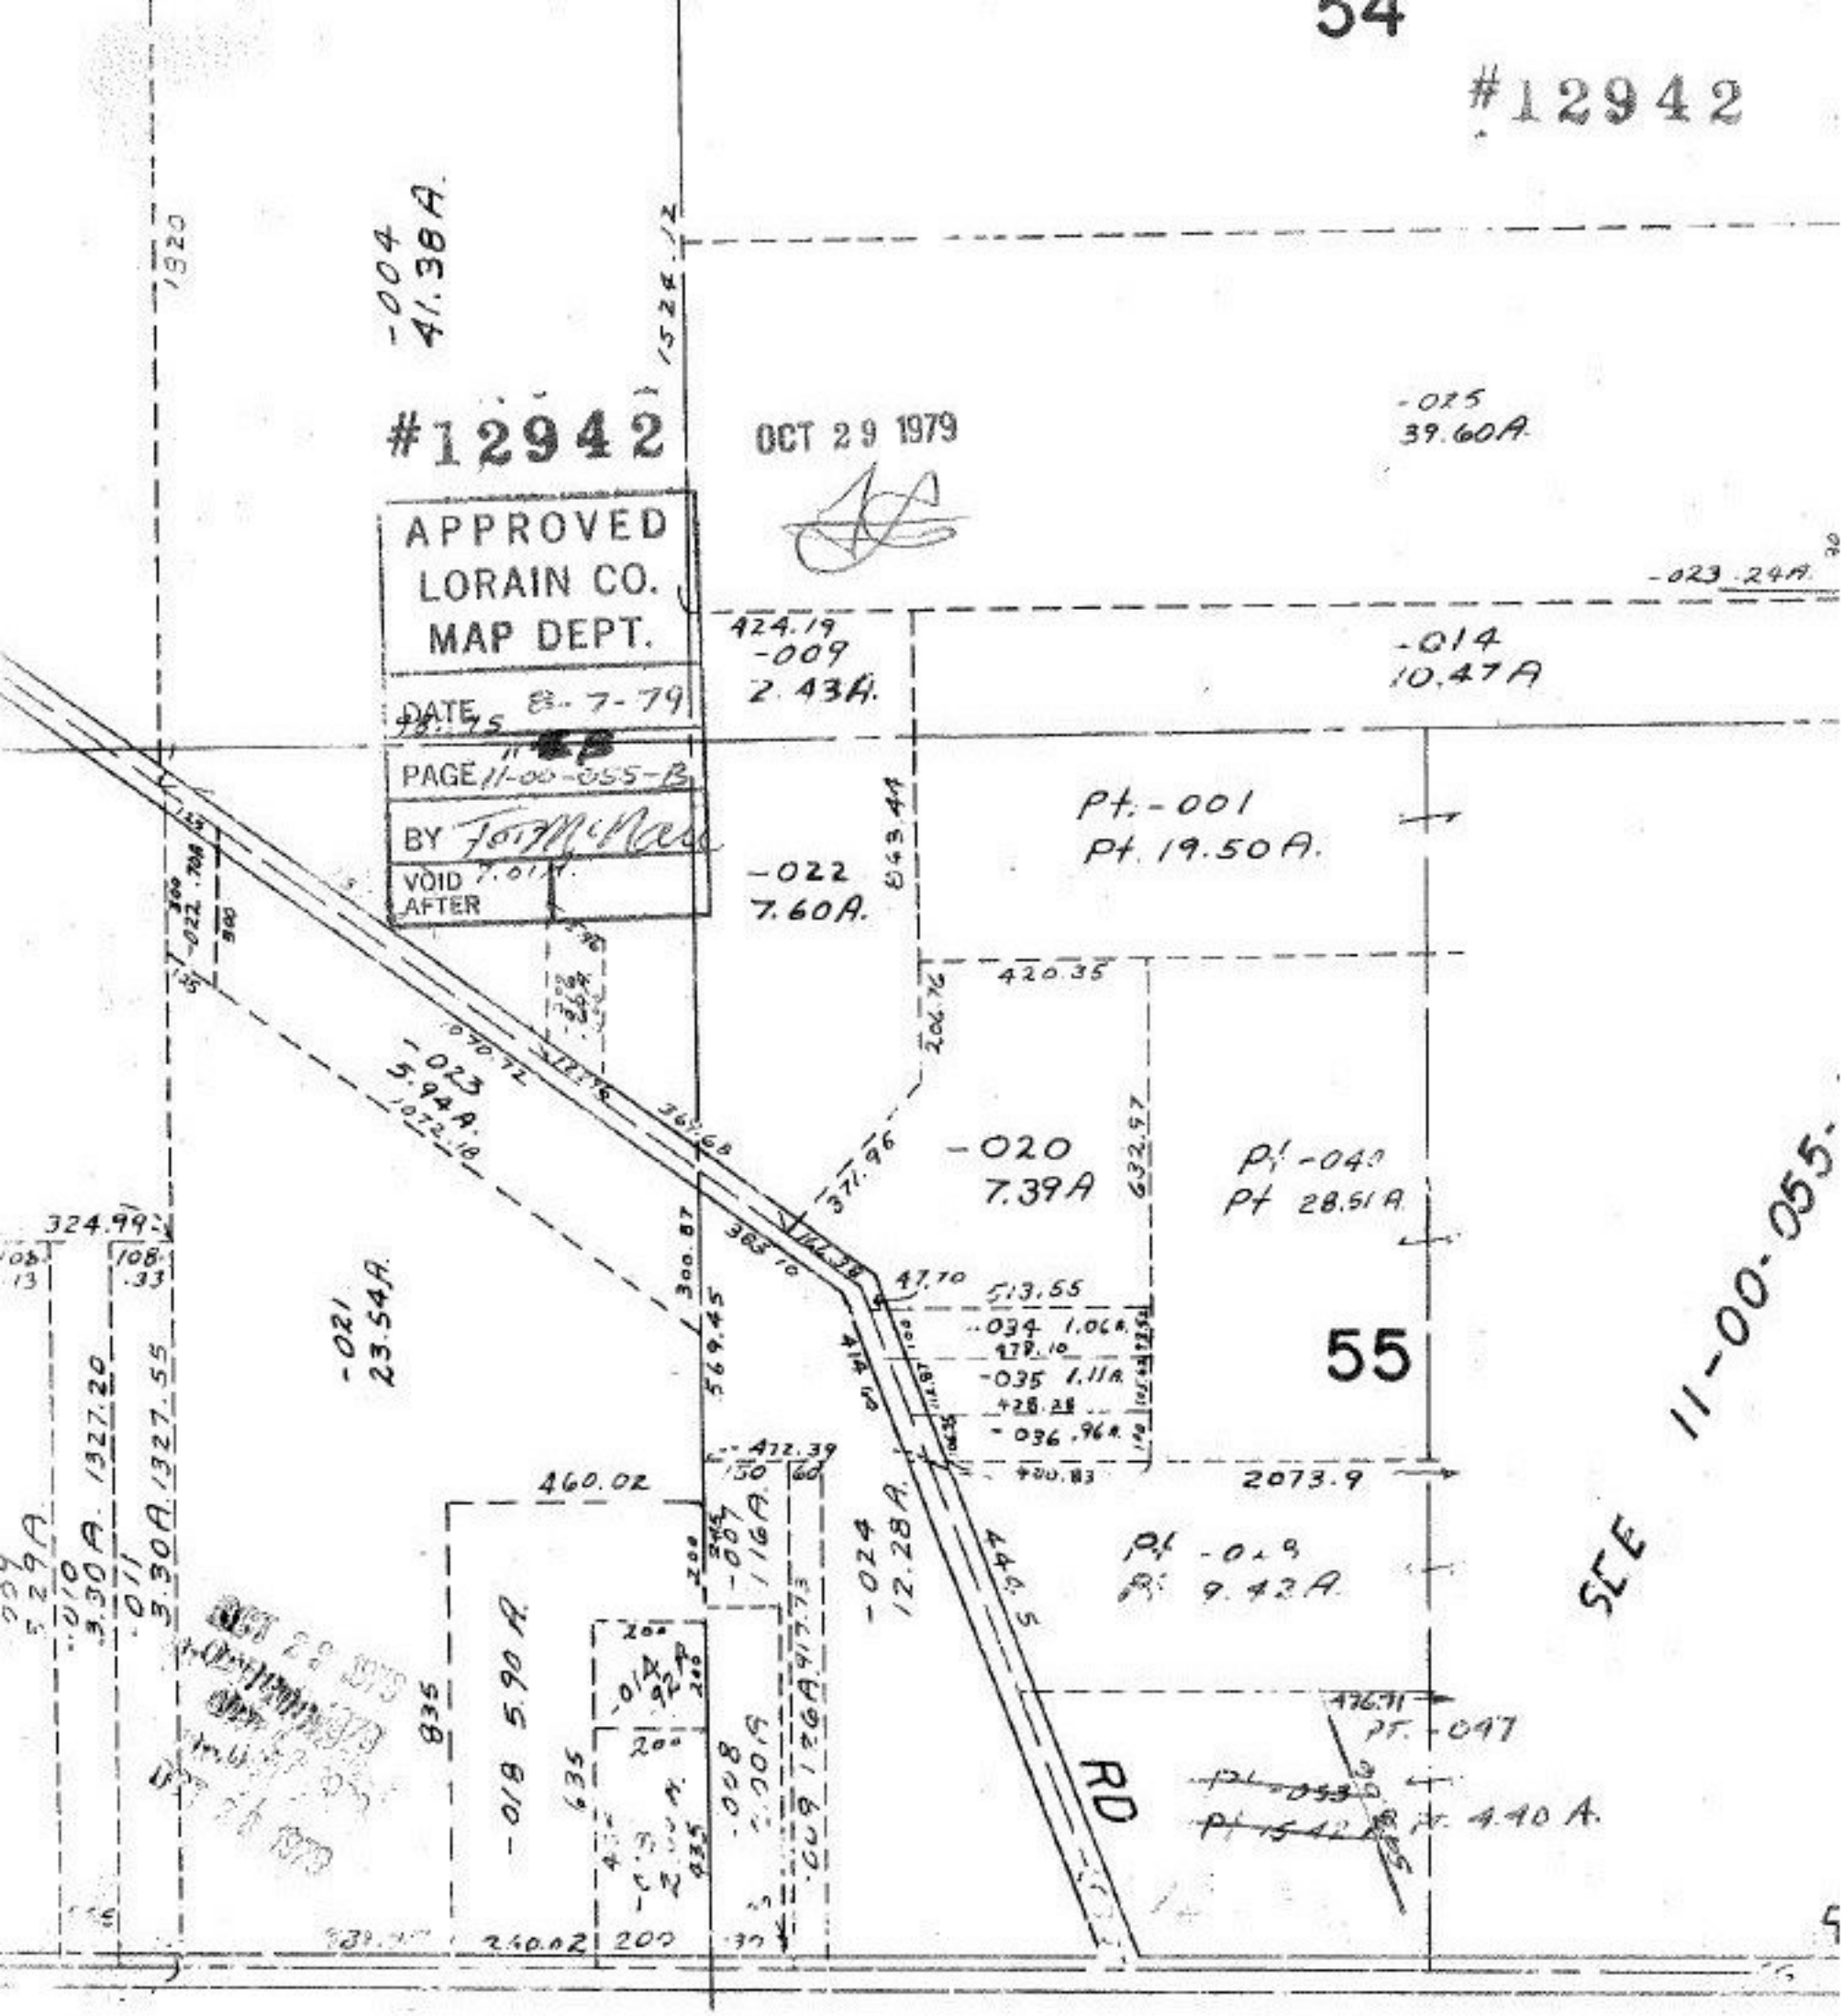
54
#12942
#12942
OCT 29 1979
APPROVED
LORAIN CO.
MAP DEPT.
DATE 8-7-79
PAGE 11-00-055-B
BY
VOID AFTER
-004
41.38A.
-025
39.60A.
-023 .24A.
424.19
-009
2.43A.
-014
10.47A
Pt.-001
Pt. 19.50A.
-022
7.60A.
420.35
-023
5.94A.
-020
7.39A
Pt -040
Pt 28.51A.
55
11-00-055-
-021
23.54A.
324.99
513.55
-034 1.06A.
-035 1.11A.
-036 .96A.
2073.9
460.02
-024
12.28A.
Pt -049
Pt 9.42A.
SEE
-018 5.90A.
-008
RD
Pt. -047
Pt. 4.40 A.
240.02
200