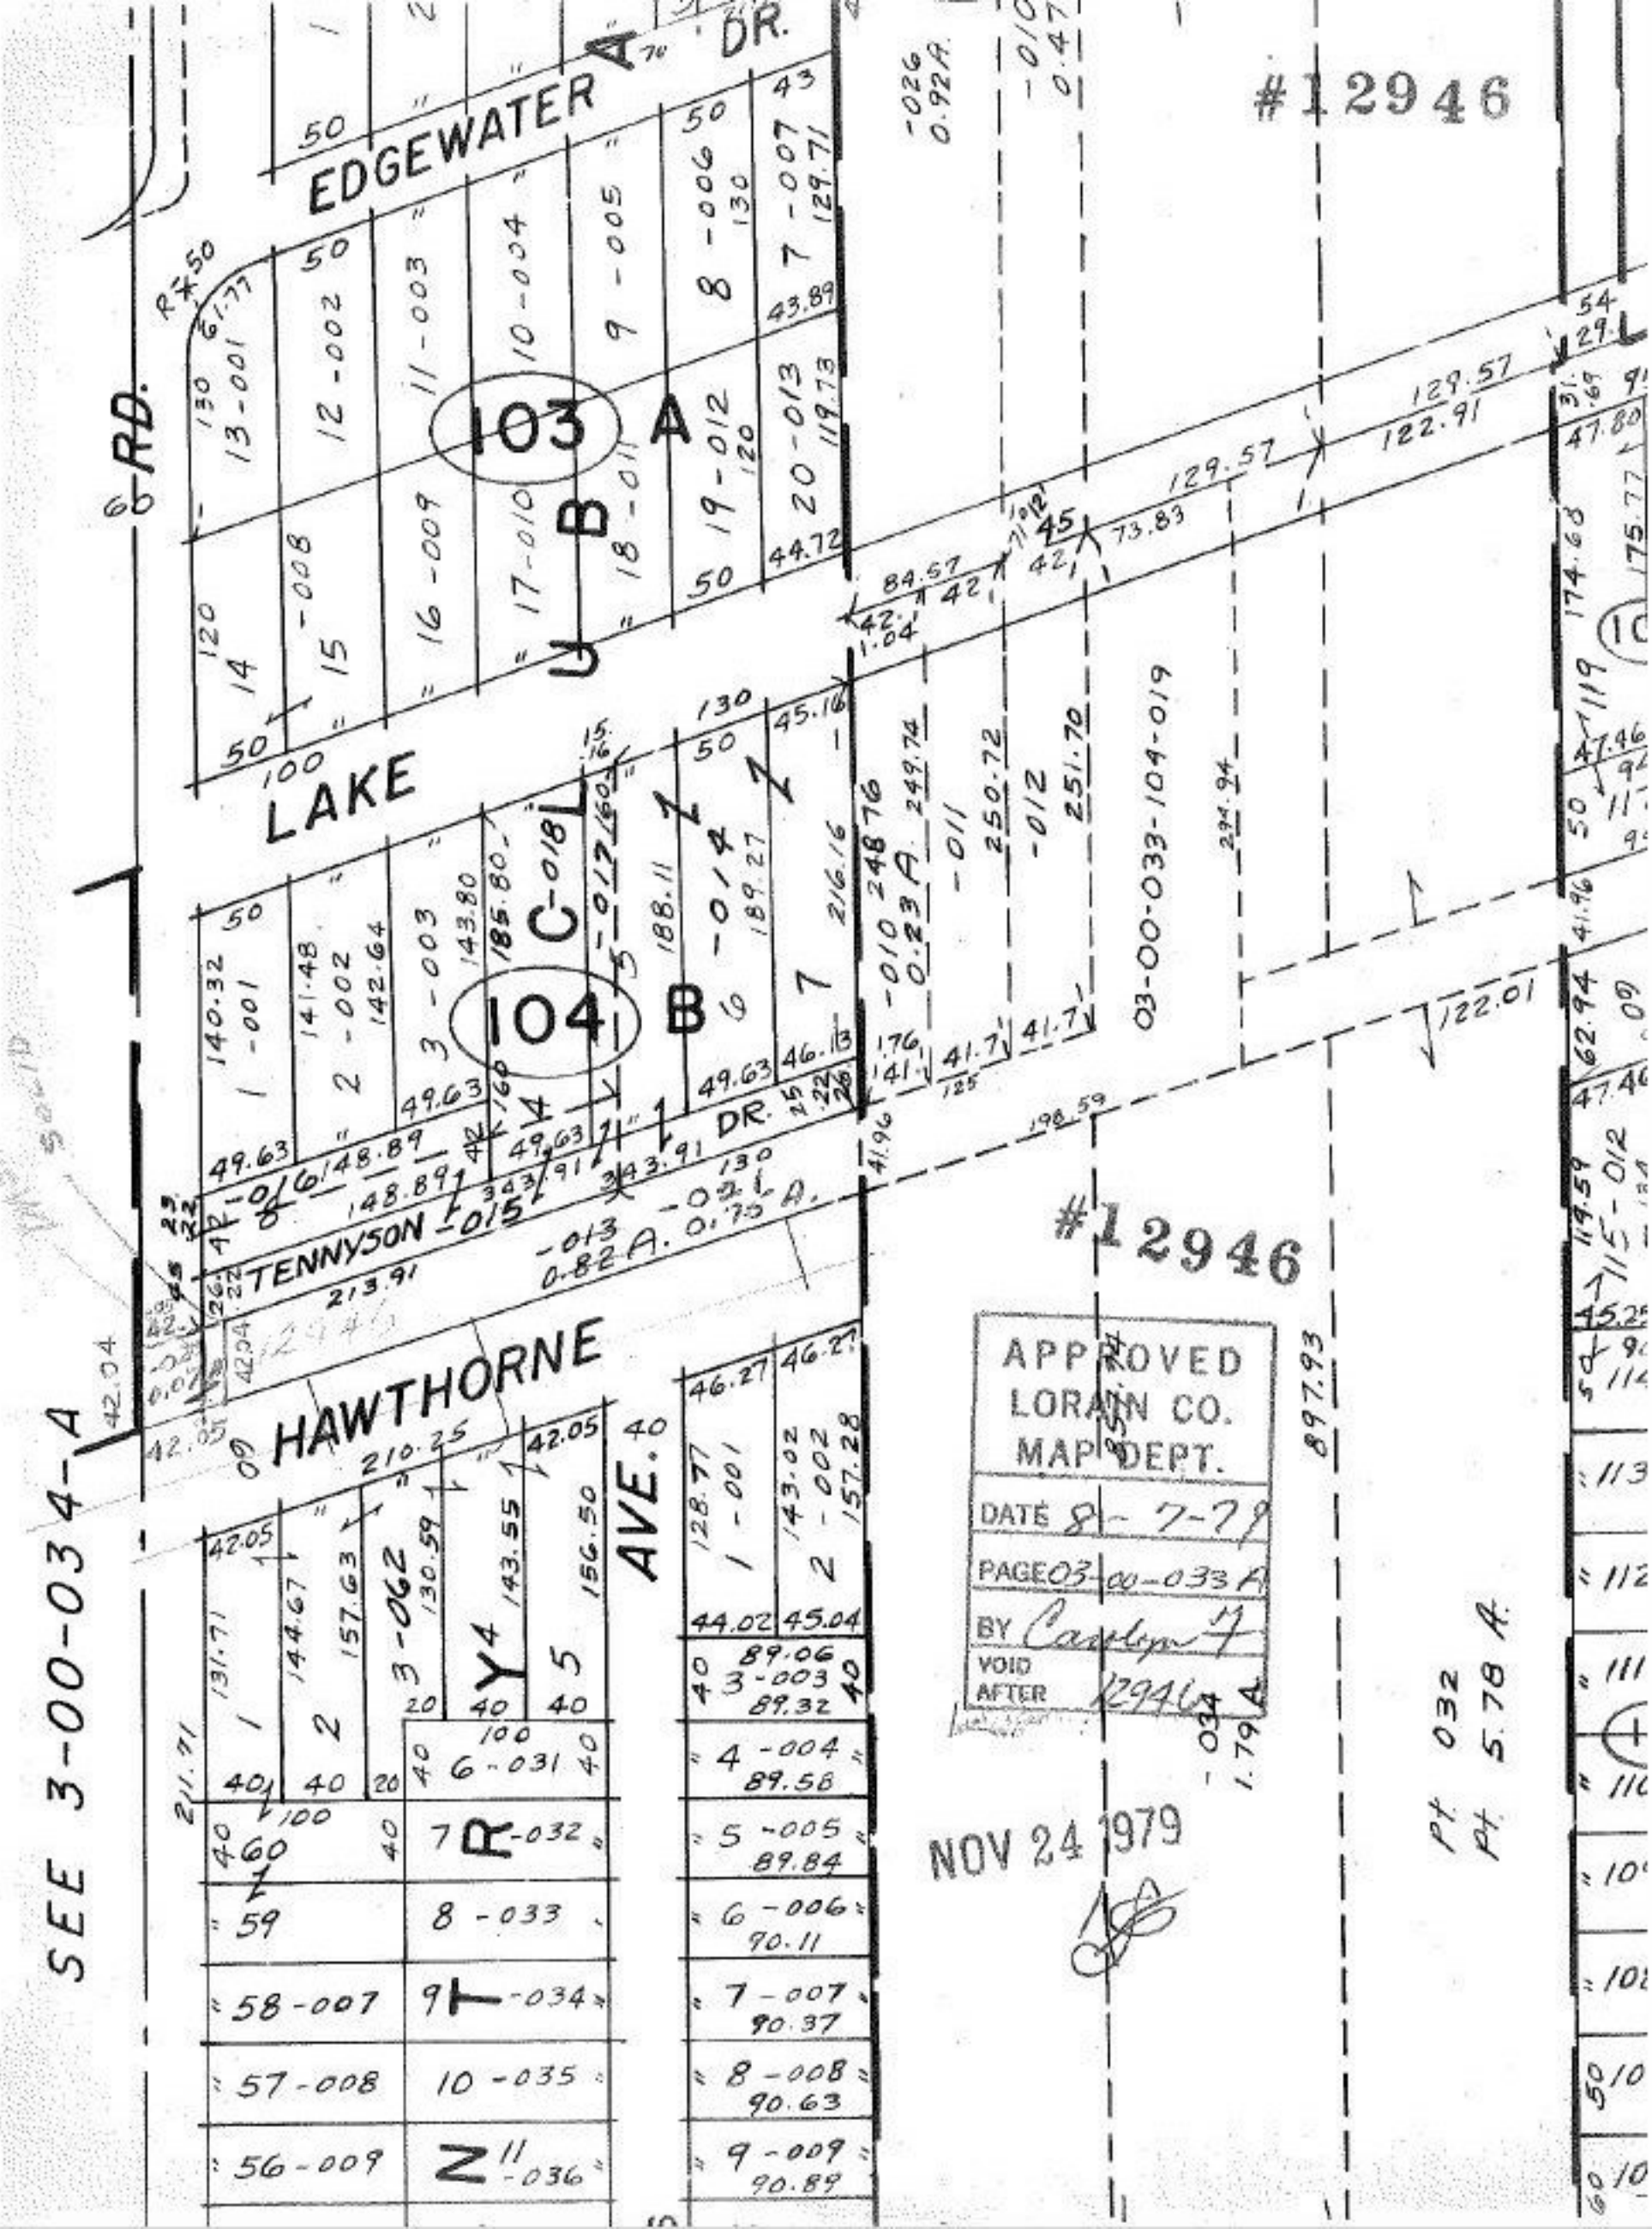

#12946
EDGEWATER DR.
LAKE
HAWTHORNE
AVE.
TENNYSON DR.
103 A
104 B
SEE 3-00-034-A
03-00-033-104-019
#12946
APPROVED
LORAIN CO.
MAP DEPT.
DATE 8-7-79
PAGE 03-00-033 A
BY Carolyn
VOID AFTER 12946
NOV 24 1979
Pt 032
Pt 5.78 A