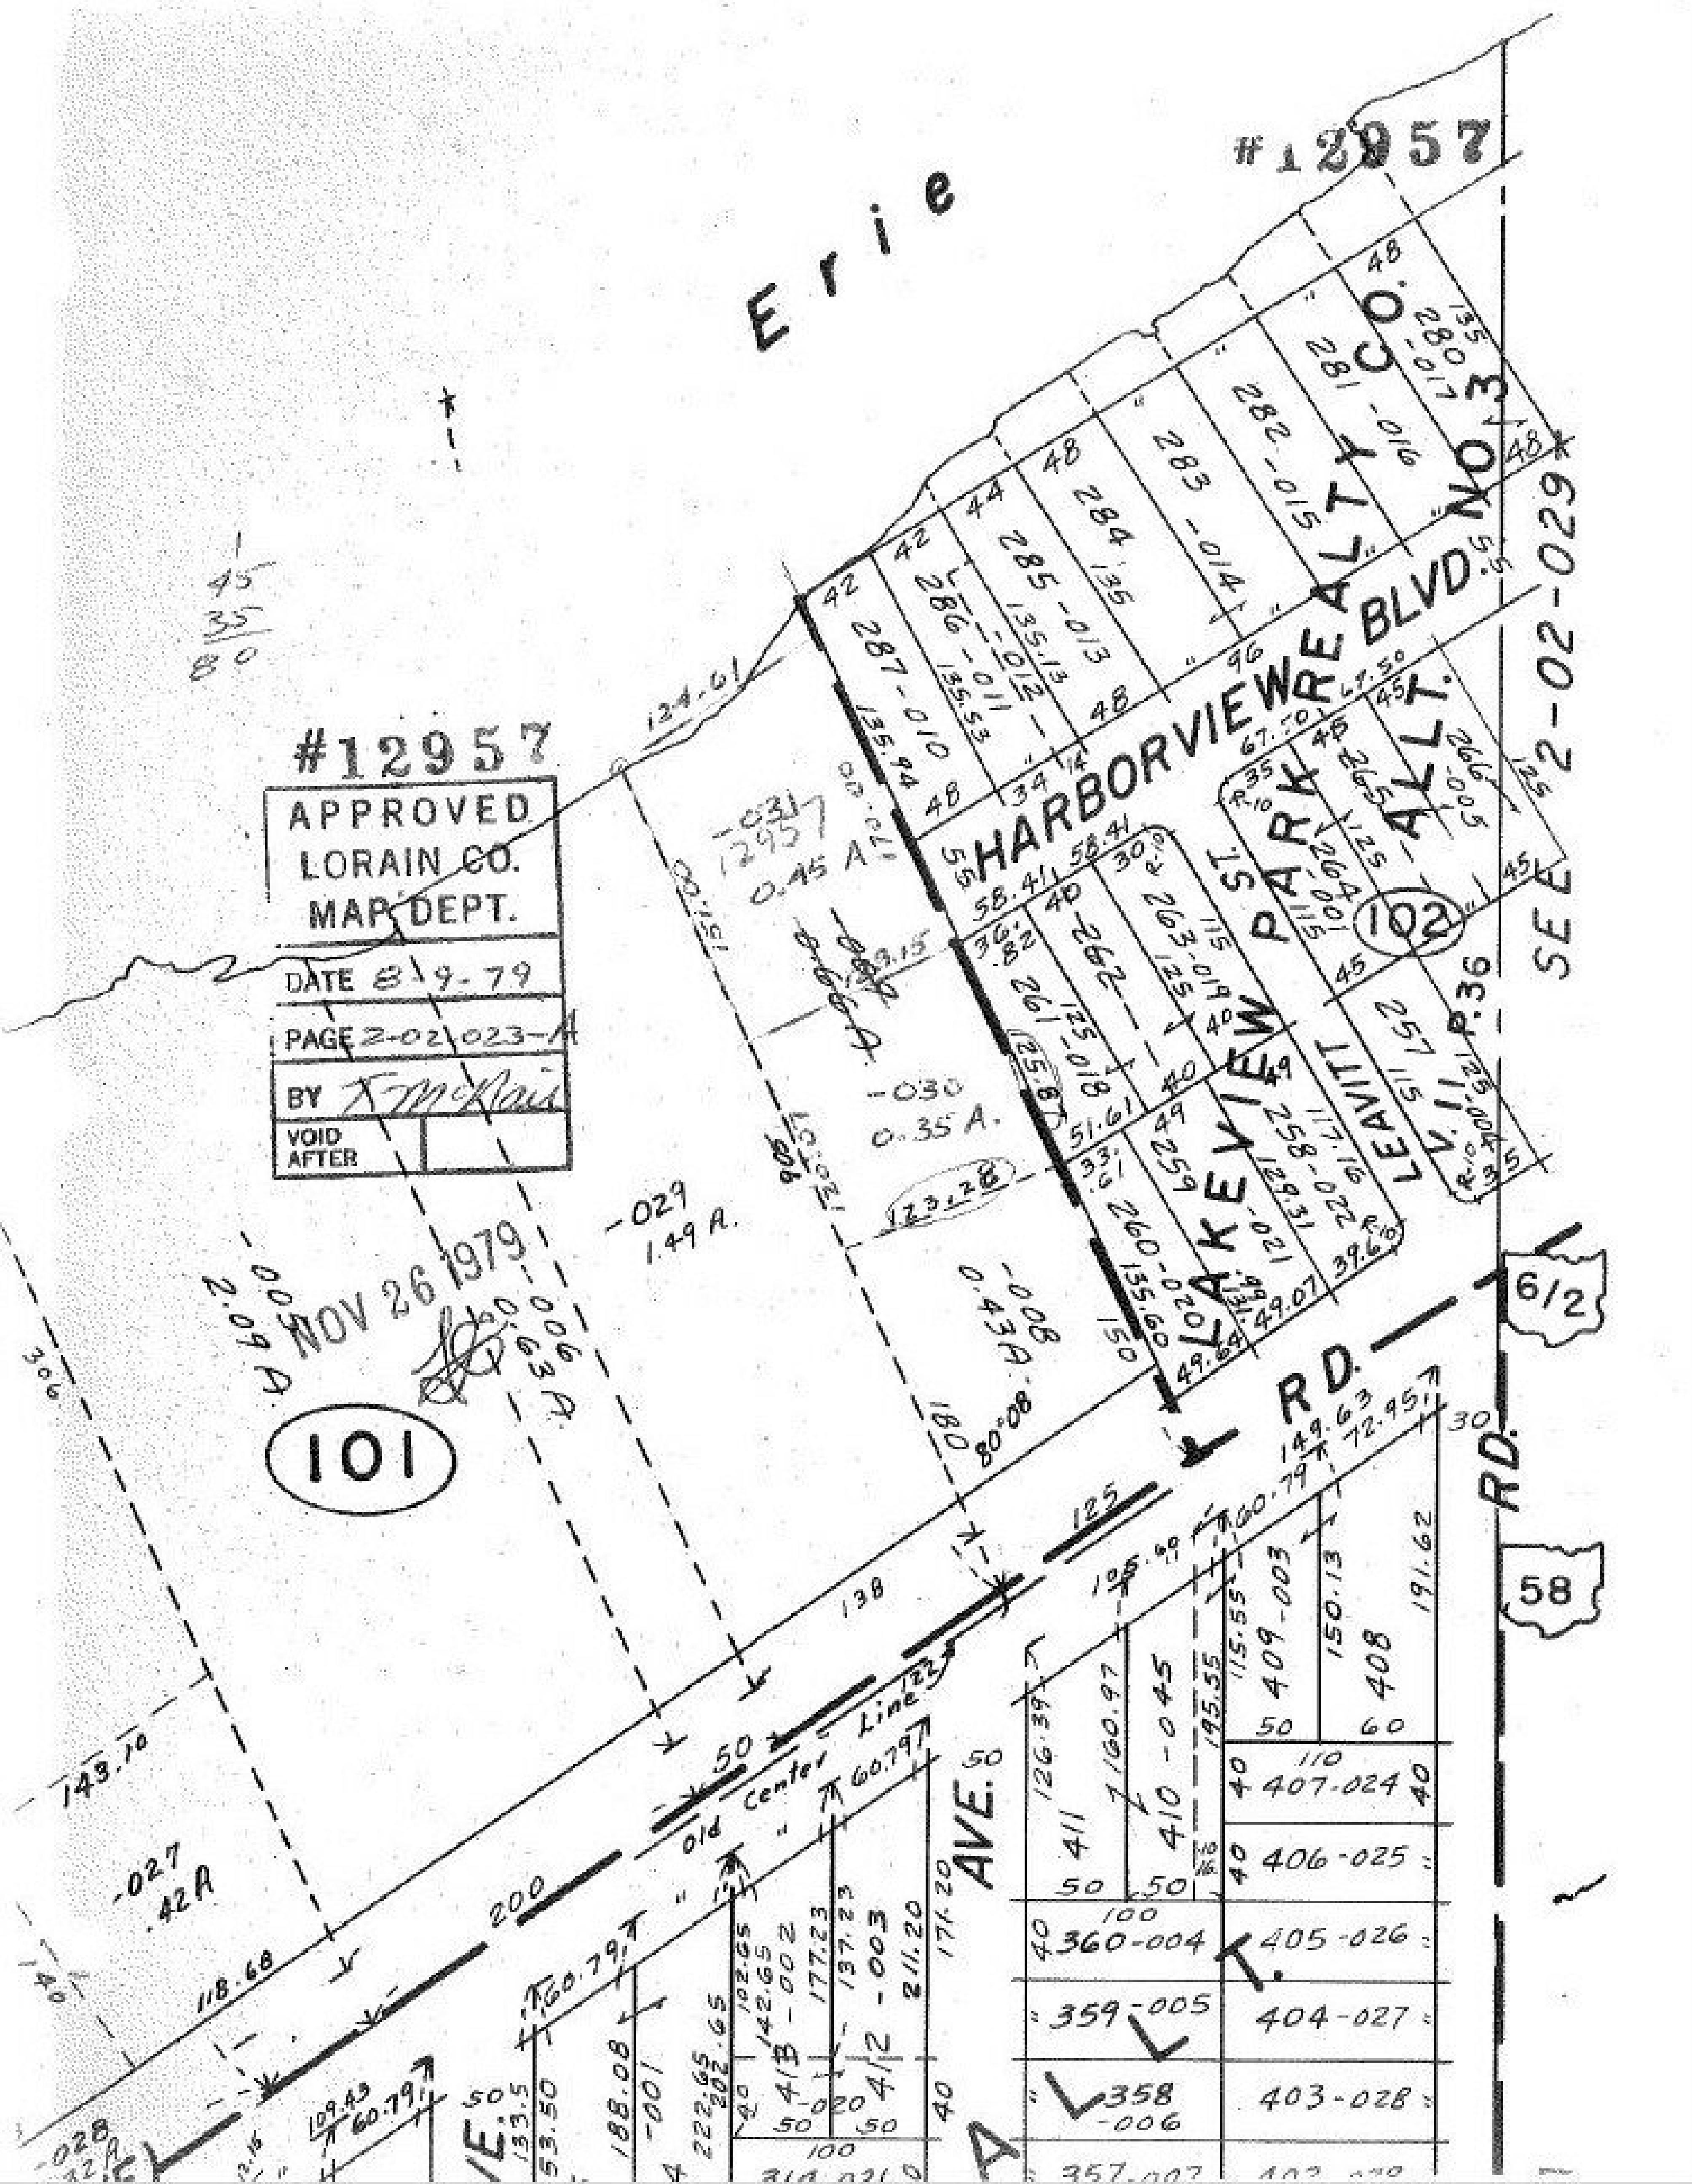
Erie
#12957
APPROVED
LORAIN CO.
MAP DEPT.
DATE 8-9-79
PAGE 2-02-023-A
BY
VOID AFTER
NOV 26 1979
101
102
HARBORVIEW BLVD.
HARBORVIEW REALTY CO. NO. 3 ALLT.
LAKEVIEW ST.
LAKEVIEW PARK ALLT.
LEAVITT
V. 11 P. 36
SEE 2-02-029
RD.
AVE.
Old Center Line
-031
0.45 A.
-030
0.35 A.
-029
1.49 A.
-027
.42 A
-008
0.43 A
287-010
286-011
285-012
284-013
283-014
282-015
281-016
280-017
263-019
262-018
261-018
260-020
259
258
257
266-009
265
264
409-003
408
407-024
406-025
405-026
404-027
403-028
410-045
411
360-004
359-005
358-006
357-007
413-002
412-003
6/2
58