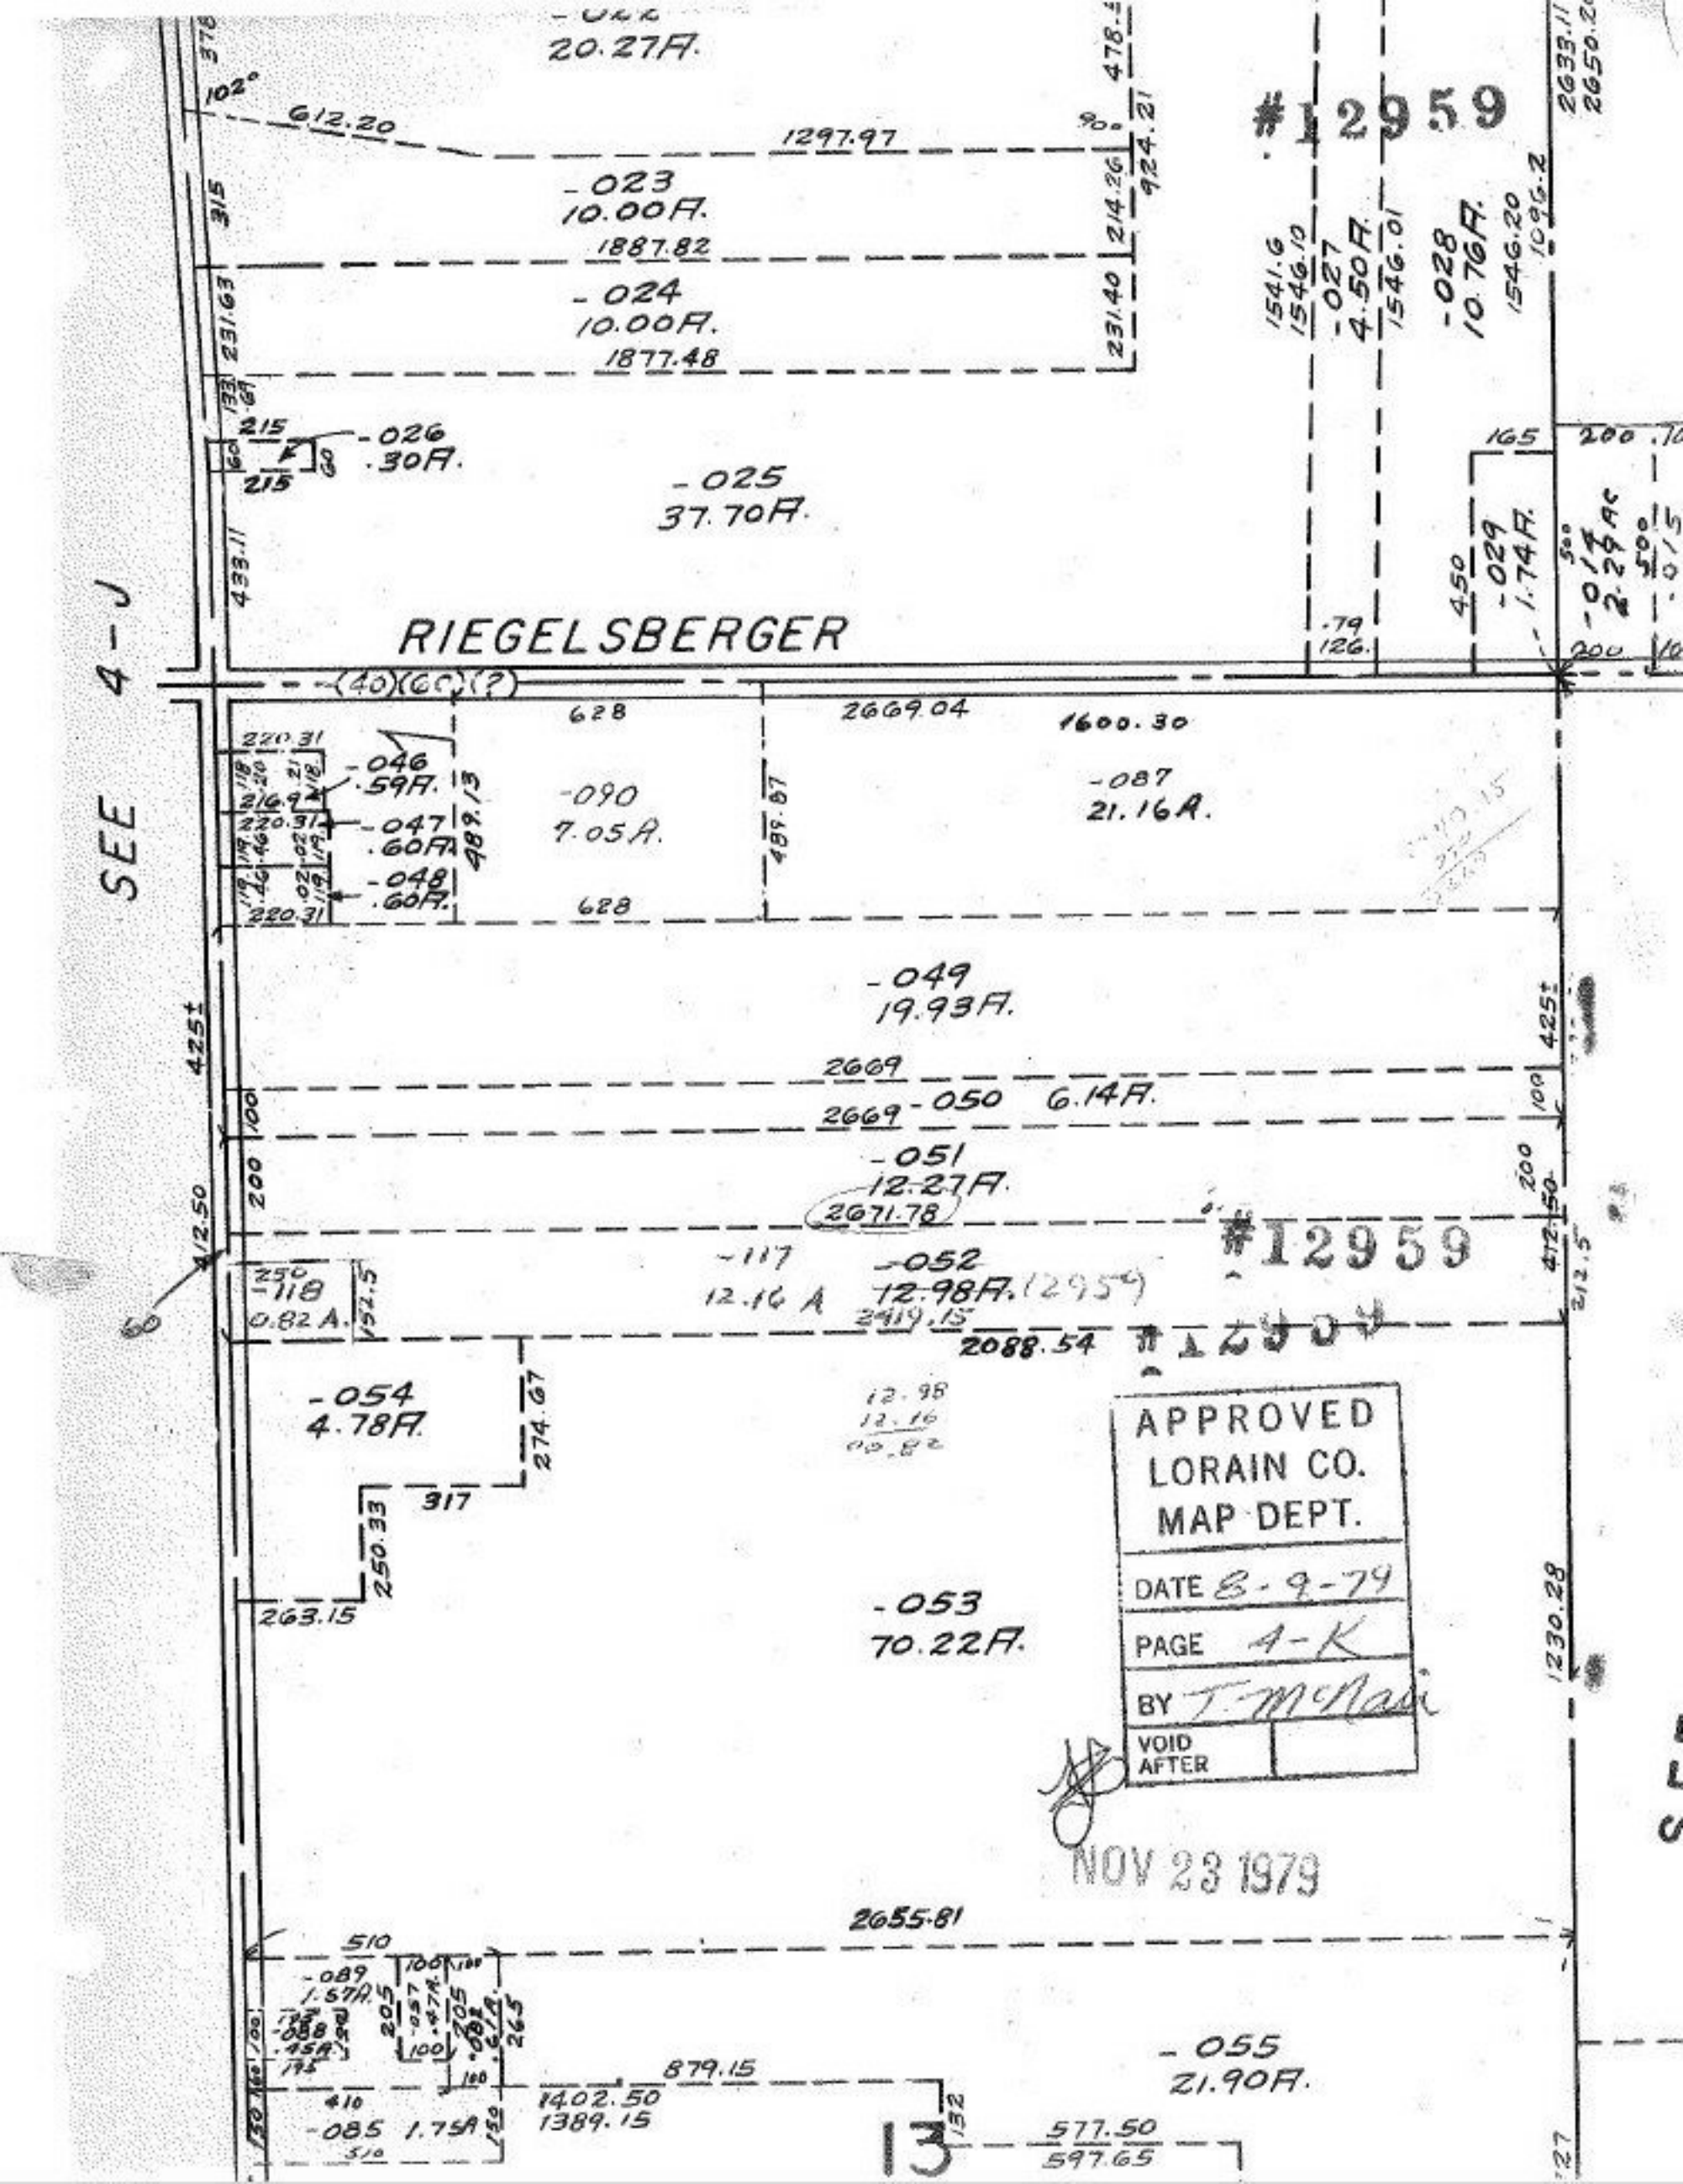

20.27A.
612.20
1297.97
-023
10.00A.
1887.82
-024
10.00A.
1877.48
-026
.30A.
-025
37.70A.
RIEGELSBERGER
SEE 4-J
#12959
-027
4.50A.
-028
10.76A.
-029
1.74A.
-014
2.29 Ac
-046
.59A.
-047
.60A.
-048
.60A.
-090
7.05A.
-087
21.16A.
-049
19.93A.
-050 6.14A.
-051
12.27A.
2671.78
-117
12.16 A
-052
12.98A. (2959)
2419.15
2088.54
-118
0.82 A.
-054
4.78A.
-053
70.22A.
-055
21.90A.
-089
1.57A.
-085 1.75A
879.15
1402.50
1389.15
577.50
597.65
2655.81
2669.04
1600.30
2633.11
2650.20
1541.6
1546.10
1546.01
1546.20
1096.2
1230.28
APPROVED
LORAIN CO.
MAP DEPT.
DATE 8-9-79
PAGE 4-K
BY T. McNair
VOID AFTER
NOV 23 1979
13