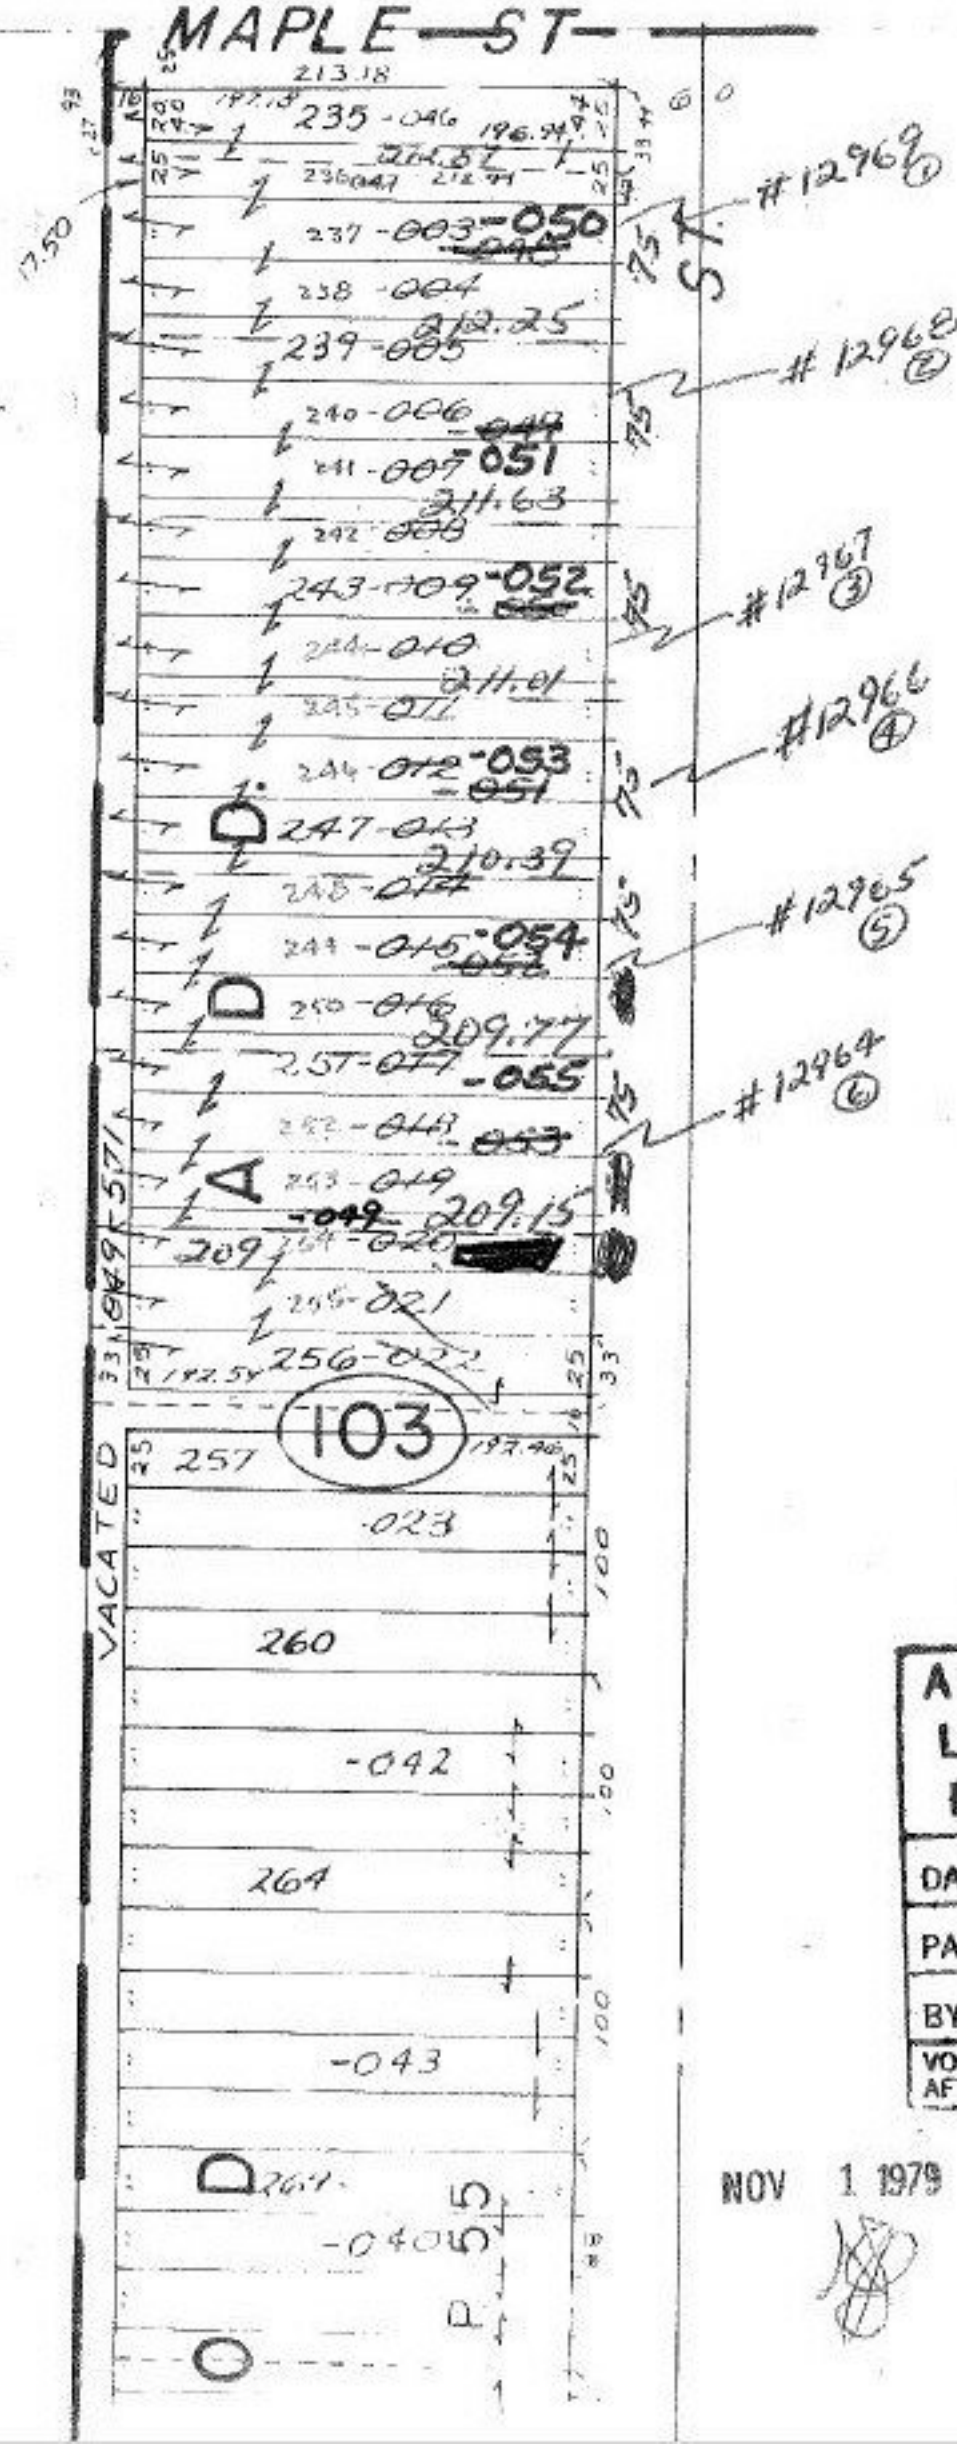

#12964
#12965
#12966
#12967
#12968
#12969

APPROVED
LORAIN CO.
MAP DEPT.
DATE 8-20-79
PAGE 9-00-074B
BY
VOID AFTER

NOV 1 1979