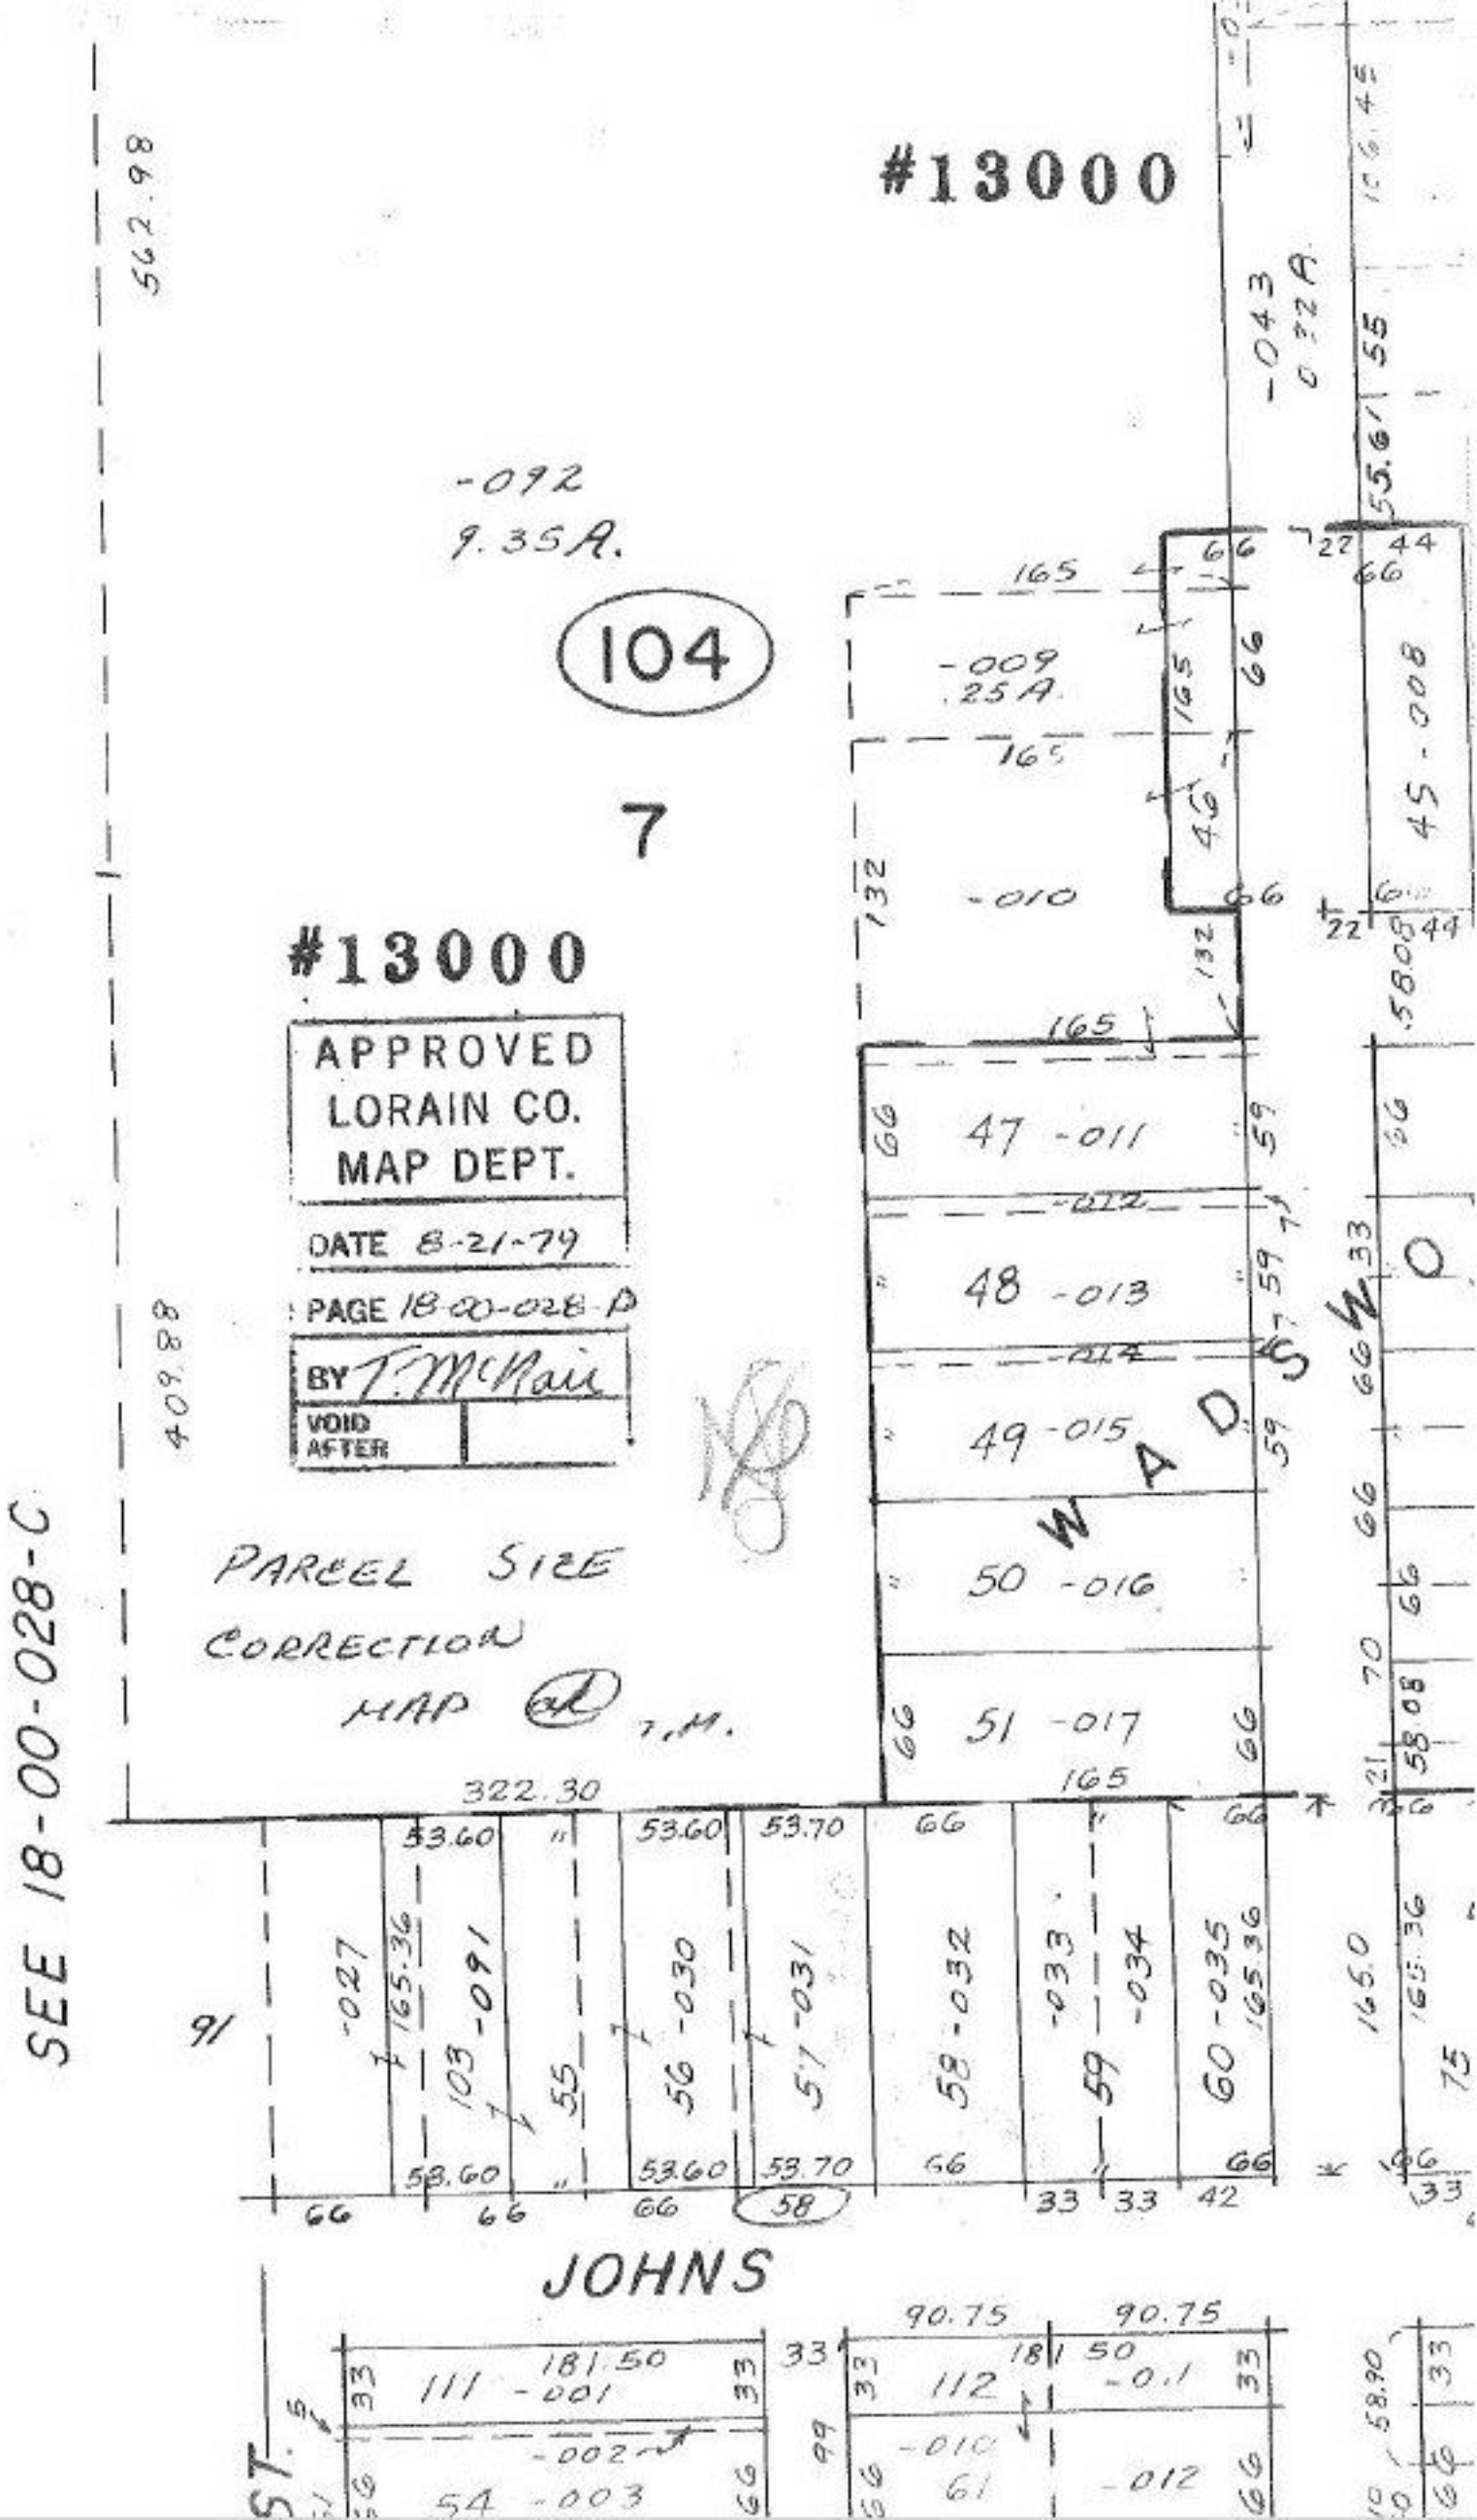

#13000
562.98
-092
9.35A.
104
7
#13000
APPROVED
LORAIN CO.
MAP DEPT.
DATE 8-21-79
PAGE 18-00-028-D
BY T. McNair
VOID AFTER
409.88
PARCEL SIZE
CORRECTION
MAP
T.M.
SEE 18-00-028-C
-043
0.32A
-009
.25A
-010
47 -011
48 -013
49 -015
50 -016
51 -017
WADSWO
322.30
91
-027
103 -091
55
56 -030
57 -031
58 -032
-033
59 -034
60 -035
JOHNS
111 -001
-002
54 -003
112
-010
61
-012