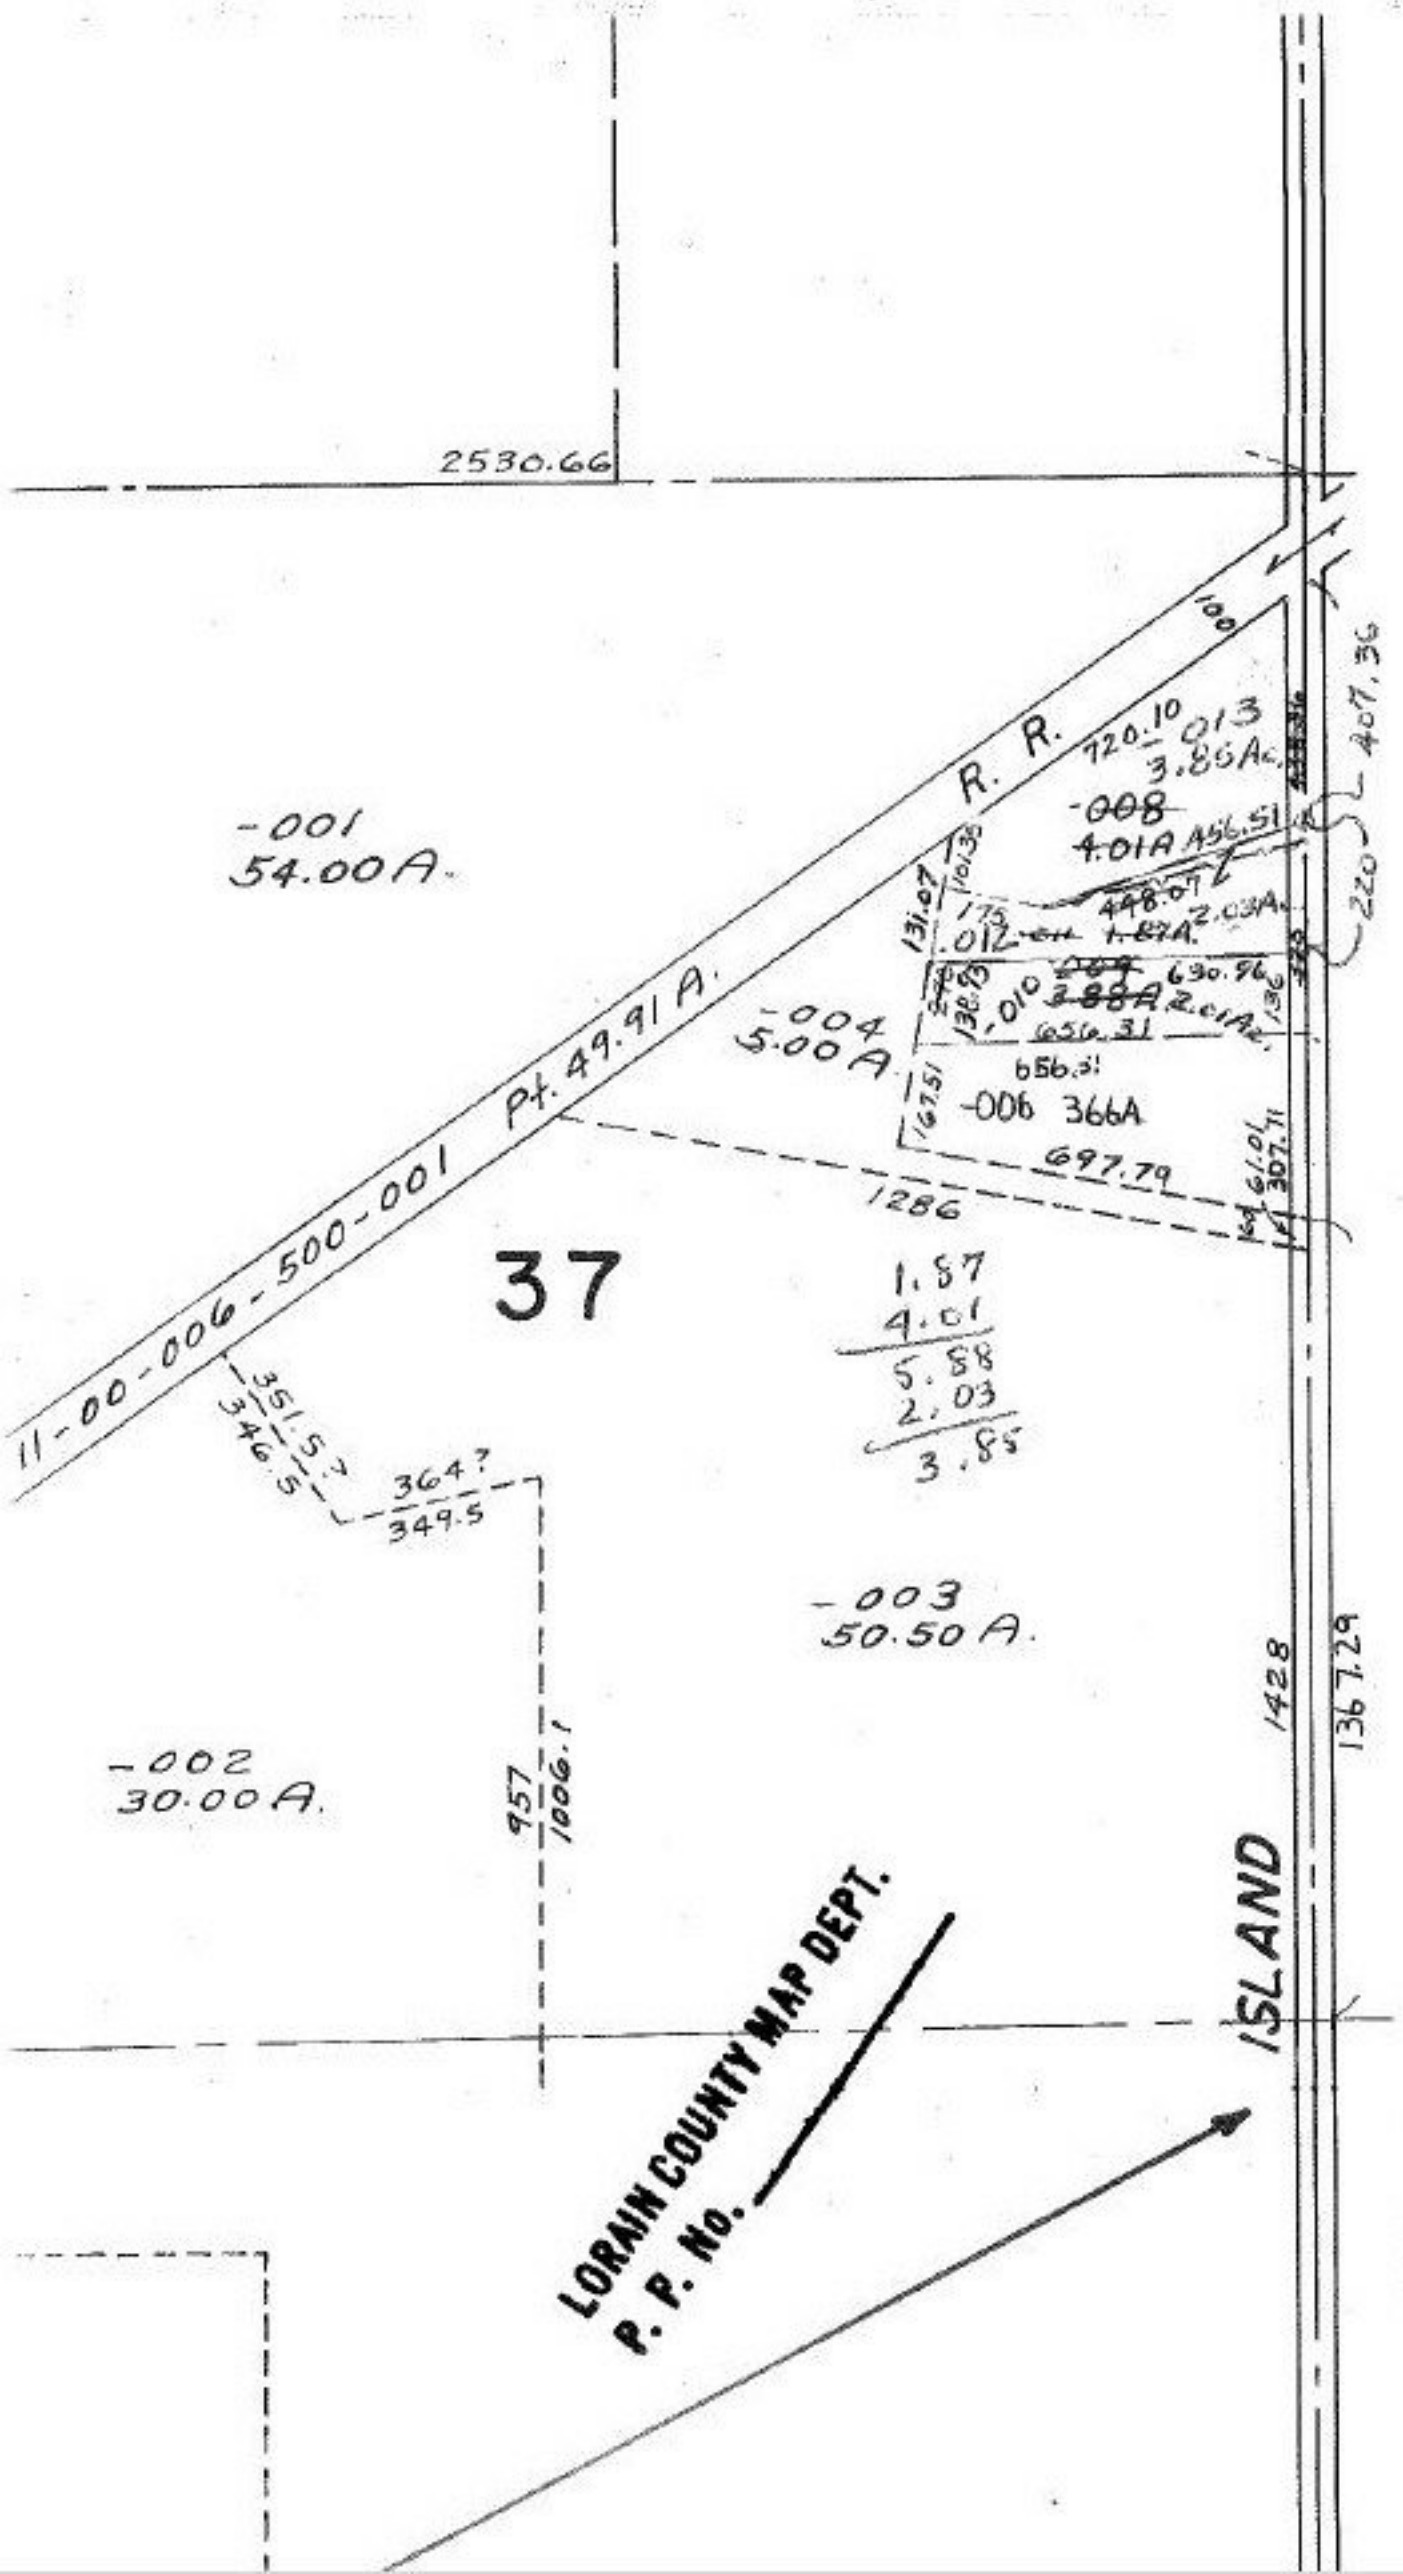

#13009

APPROVED
LORAIN CO.
MAP DEPT.
DATE 8-21-79
PAGE 11-G North
BY
VOID AFTER

OCT 29 1979