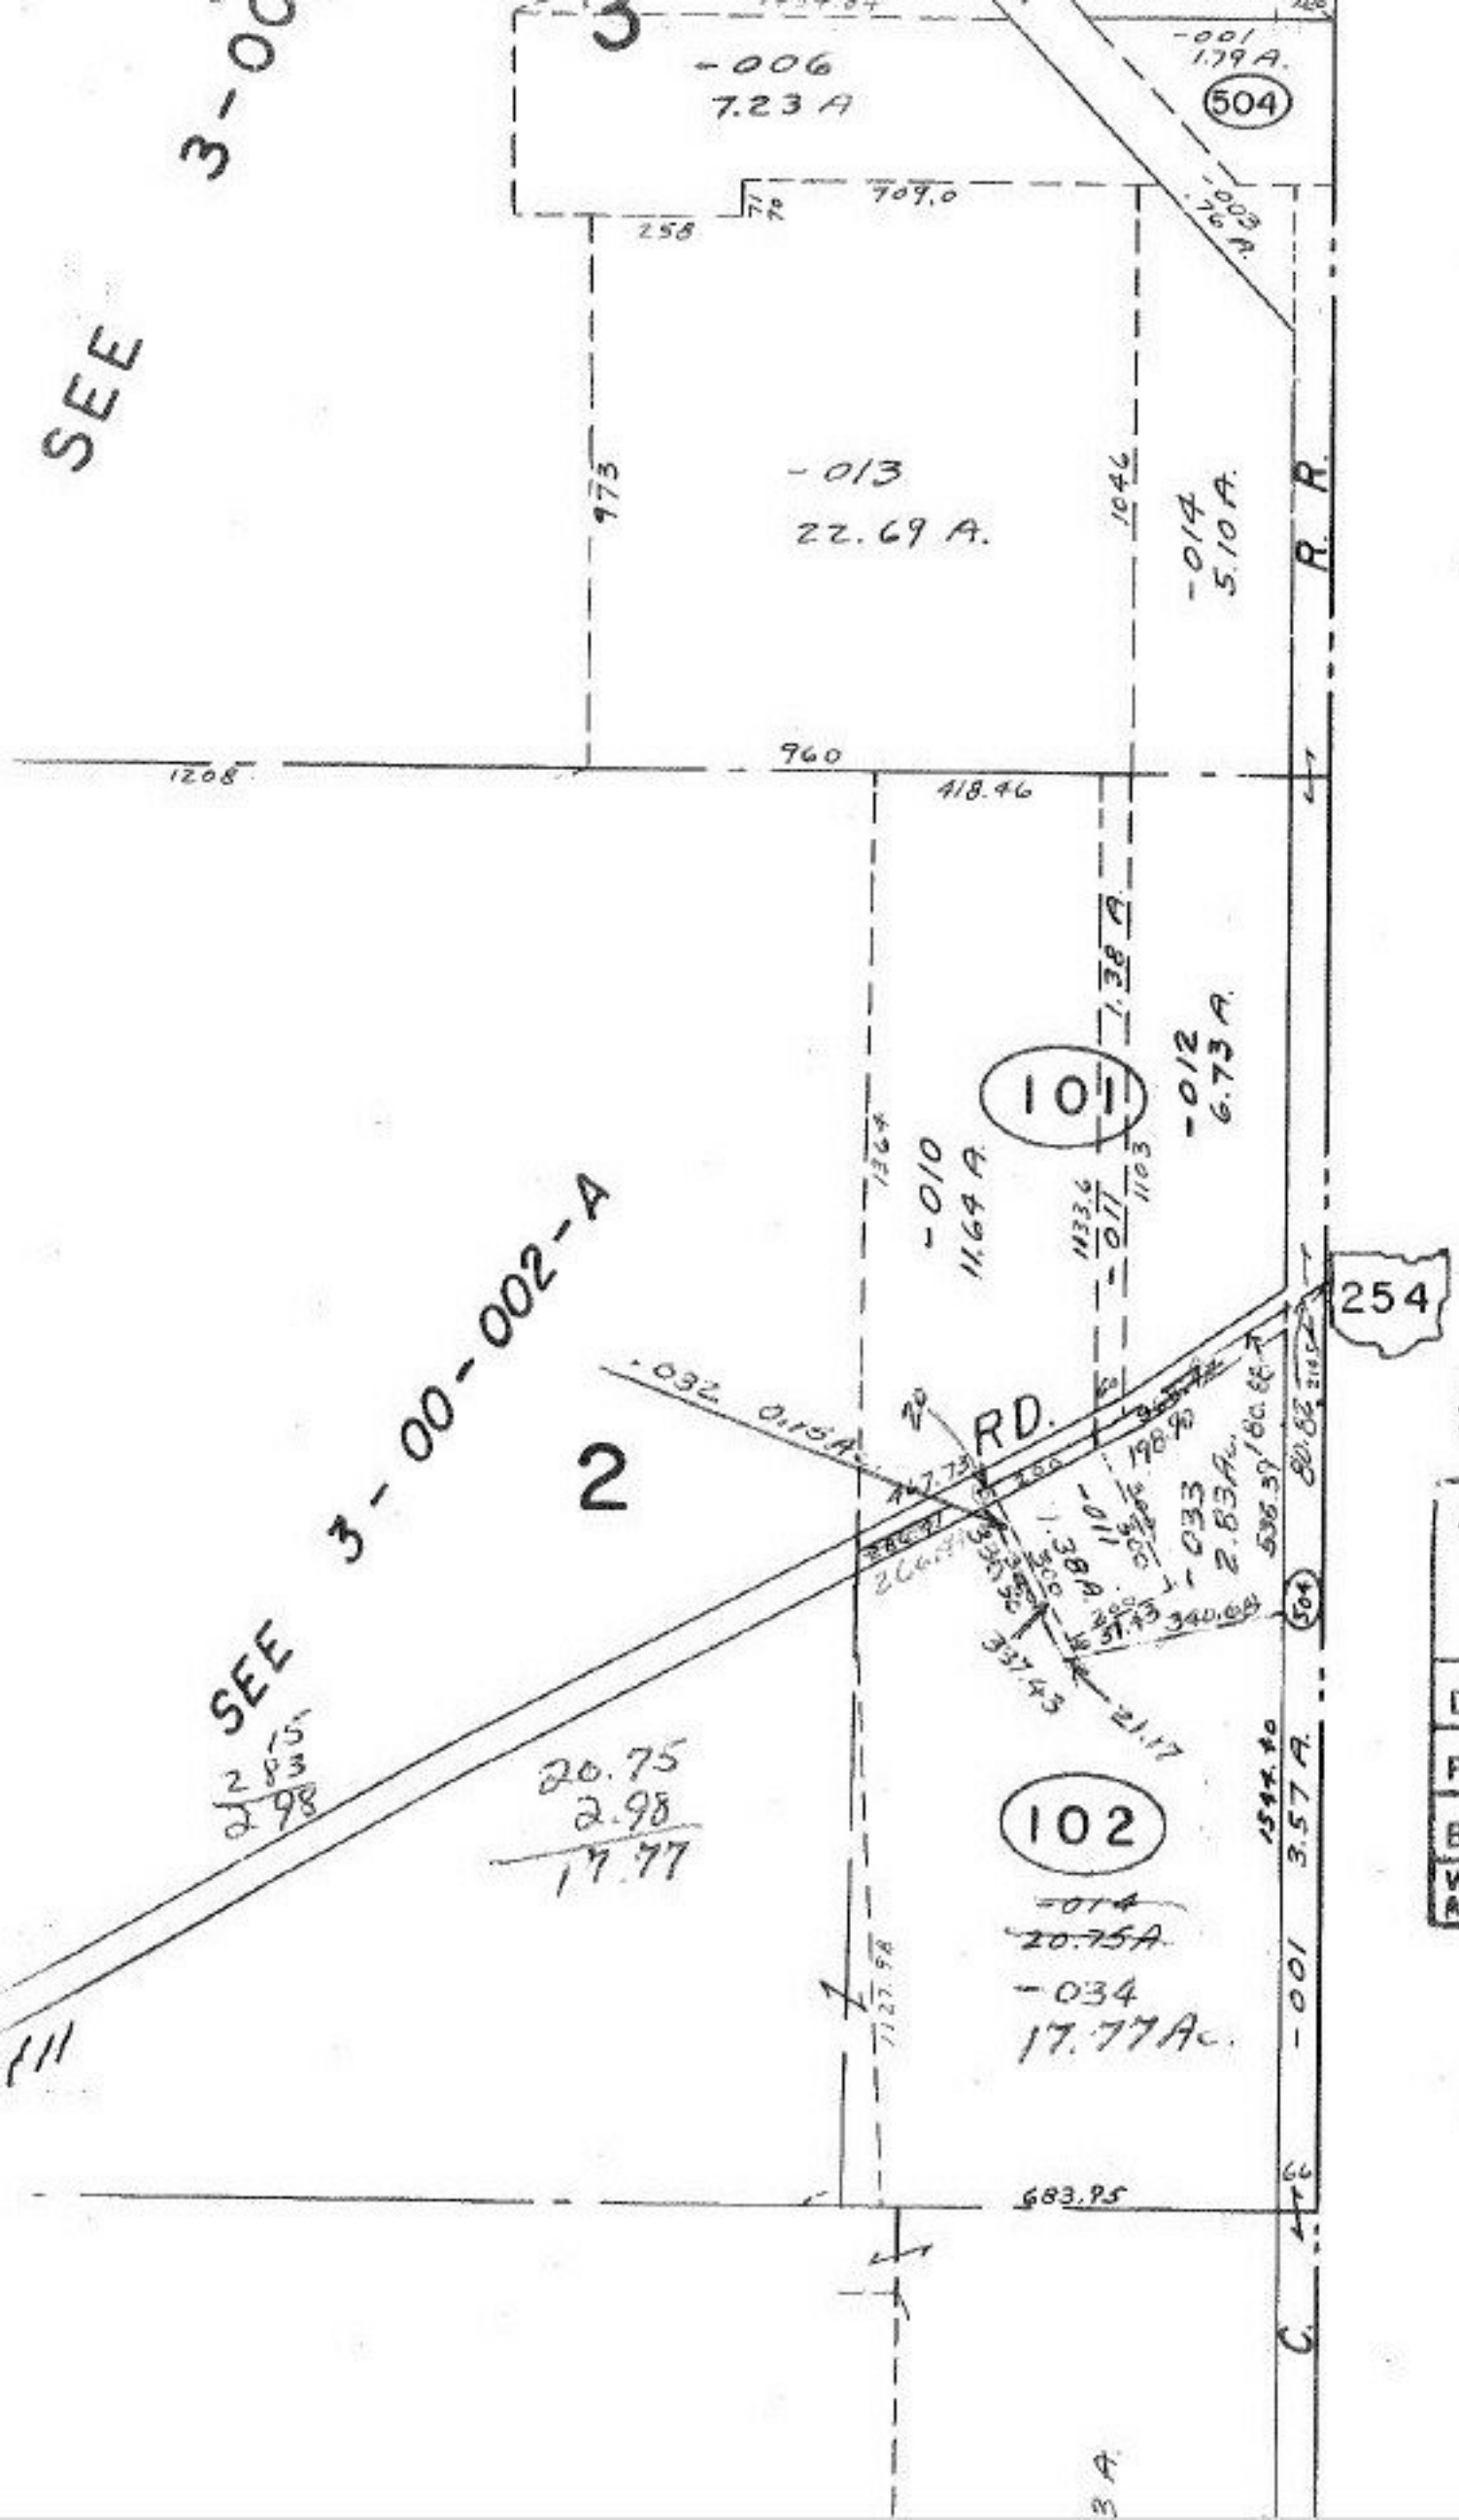

#13015

APPROVED
LORAIN CO.
MAP DEPT.

DATE 8-21-79

PAGE 3-L

BY [signature]

VOID AFTER

NOV 24 1979

[signature]