13016

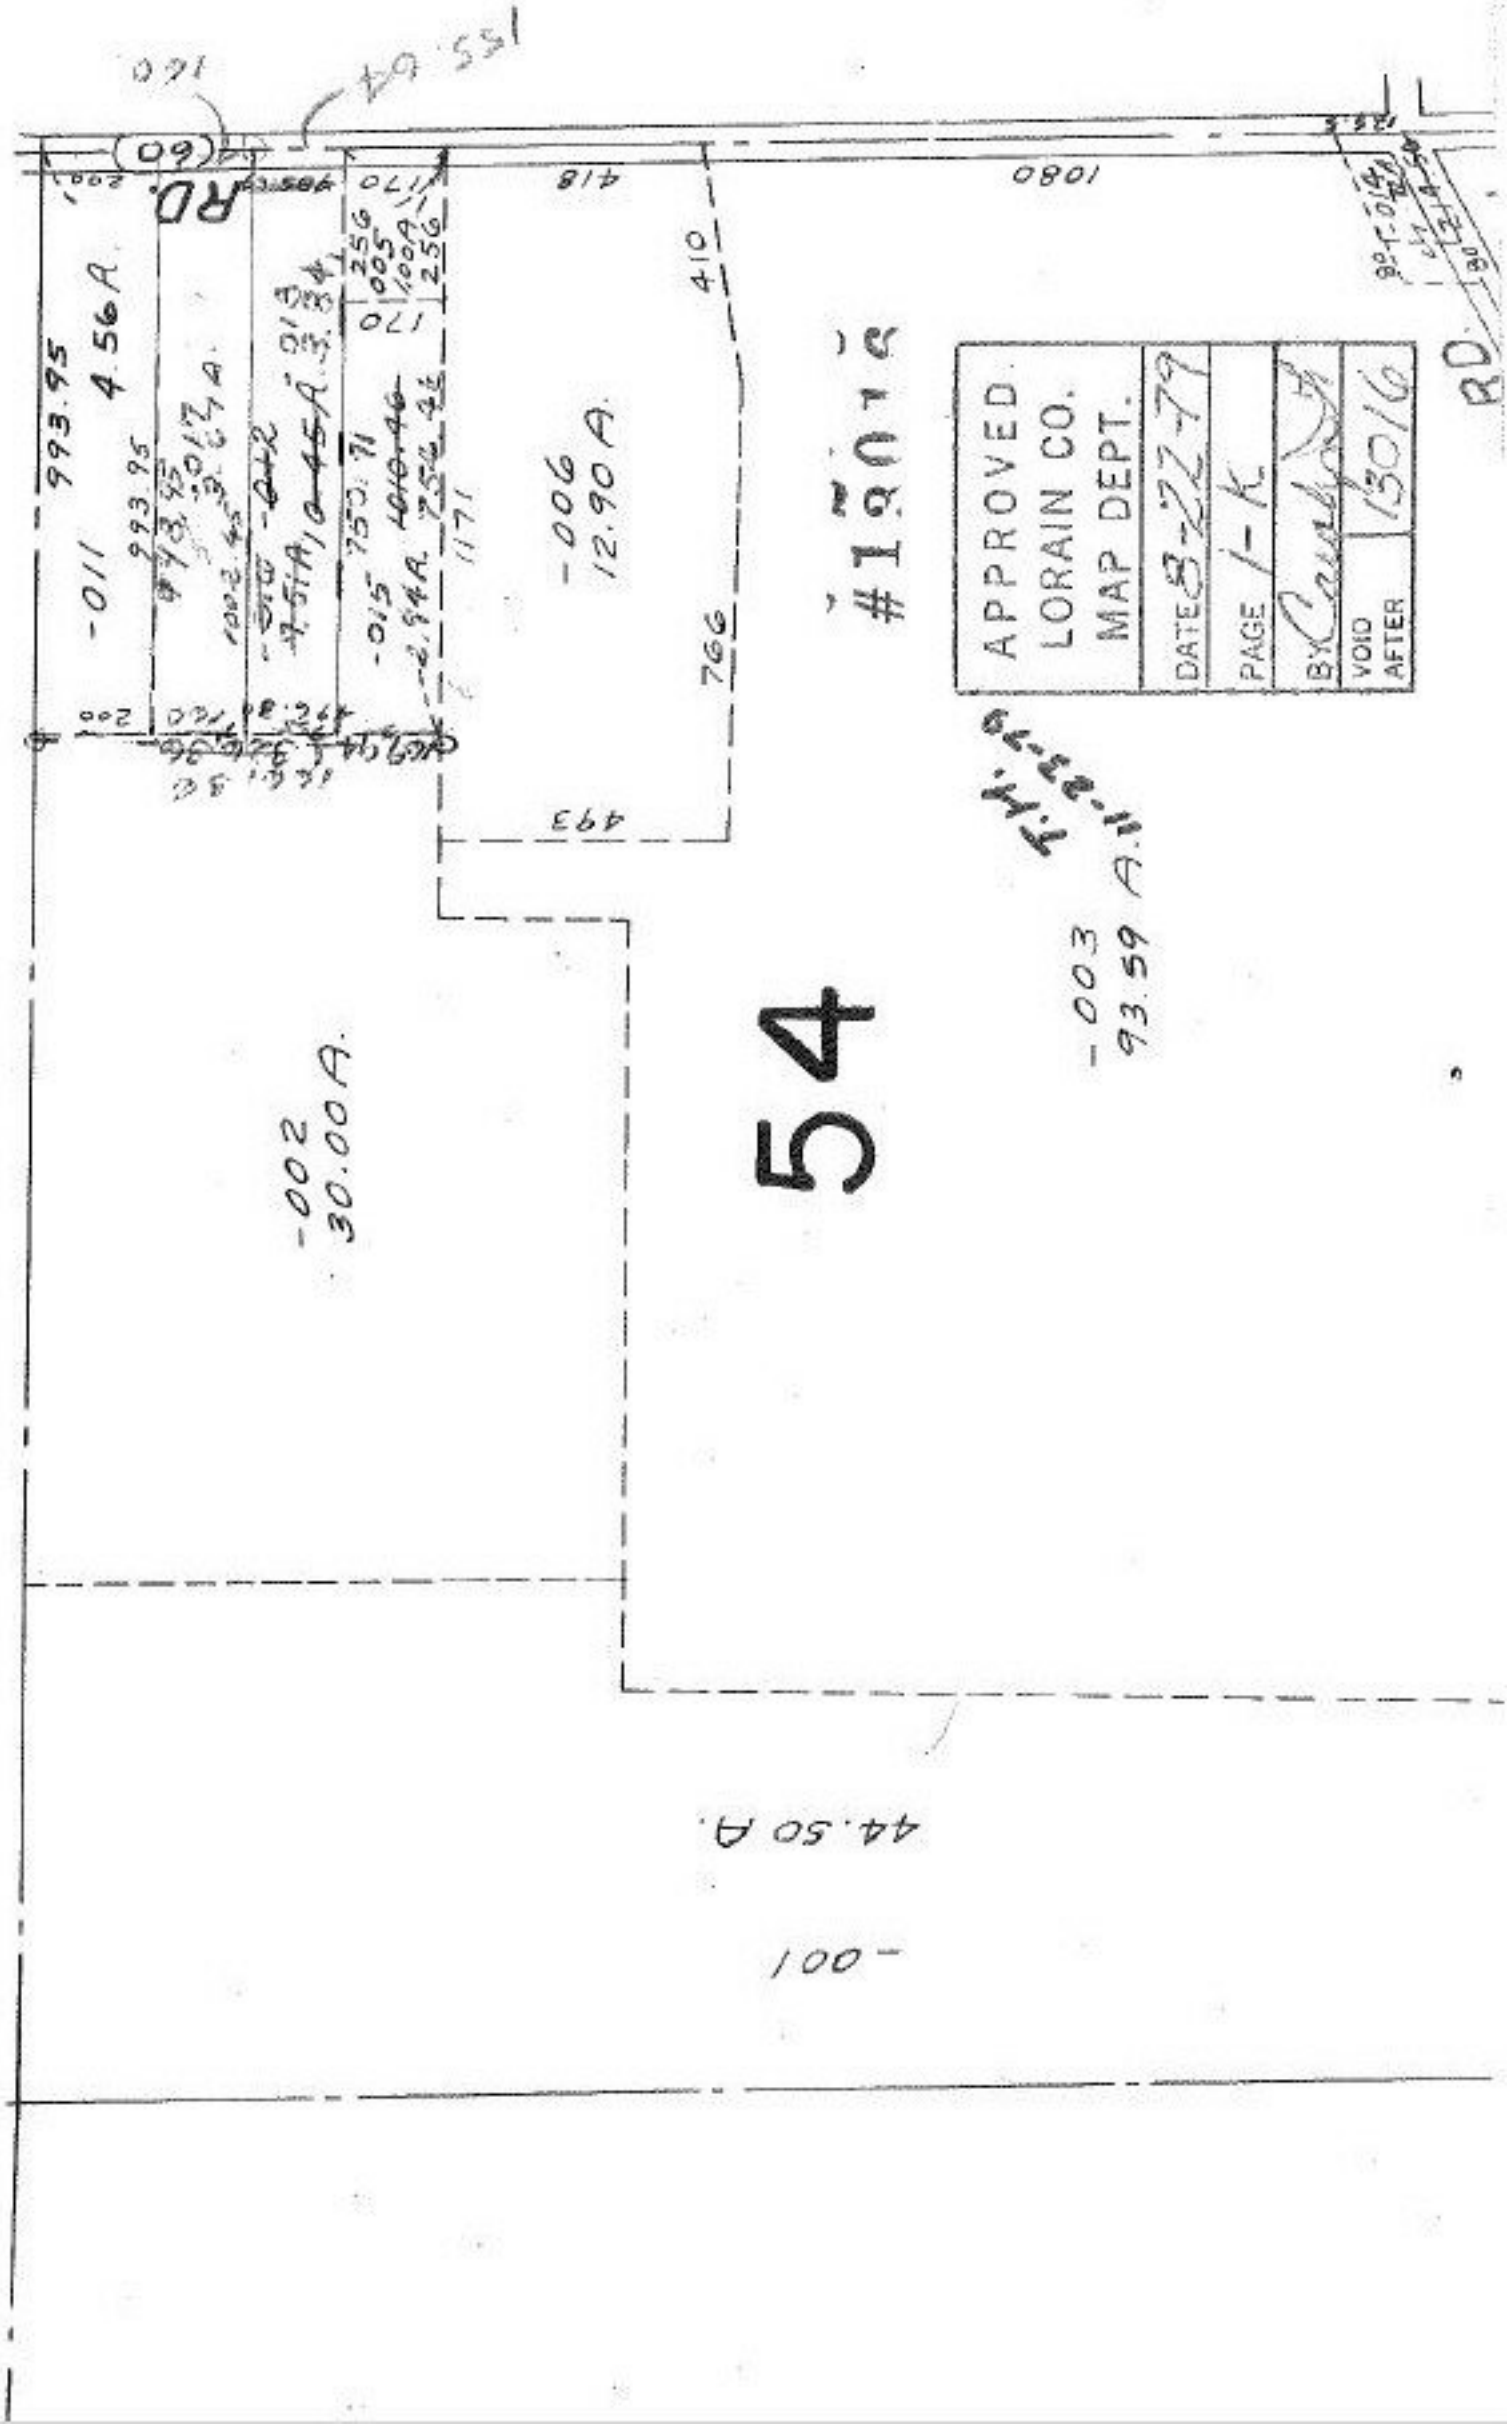

RD.
993.95
4.56 A.
-011
-006
12.90 A.
-002
30.00 A.
-003
93.59 A.
-001
44.50 A.
1080
418
410
766
493
1171
APPROVED
LORAIN CO.
MAP DEPT.
DATE 8-22-79
PAGE 1-K
BY
VOID AFTER 13016
#13016
54

#13016