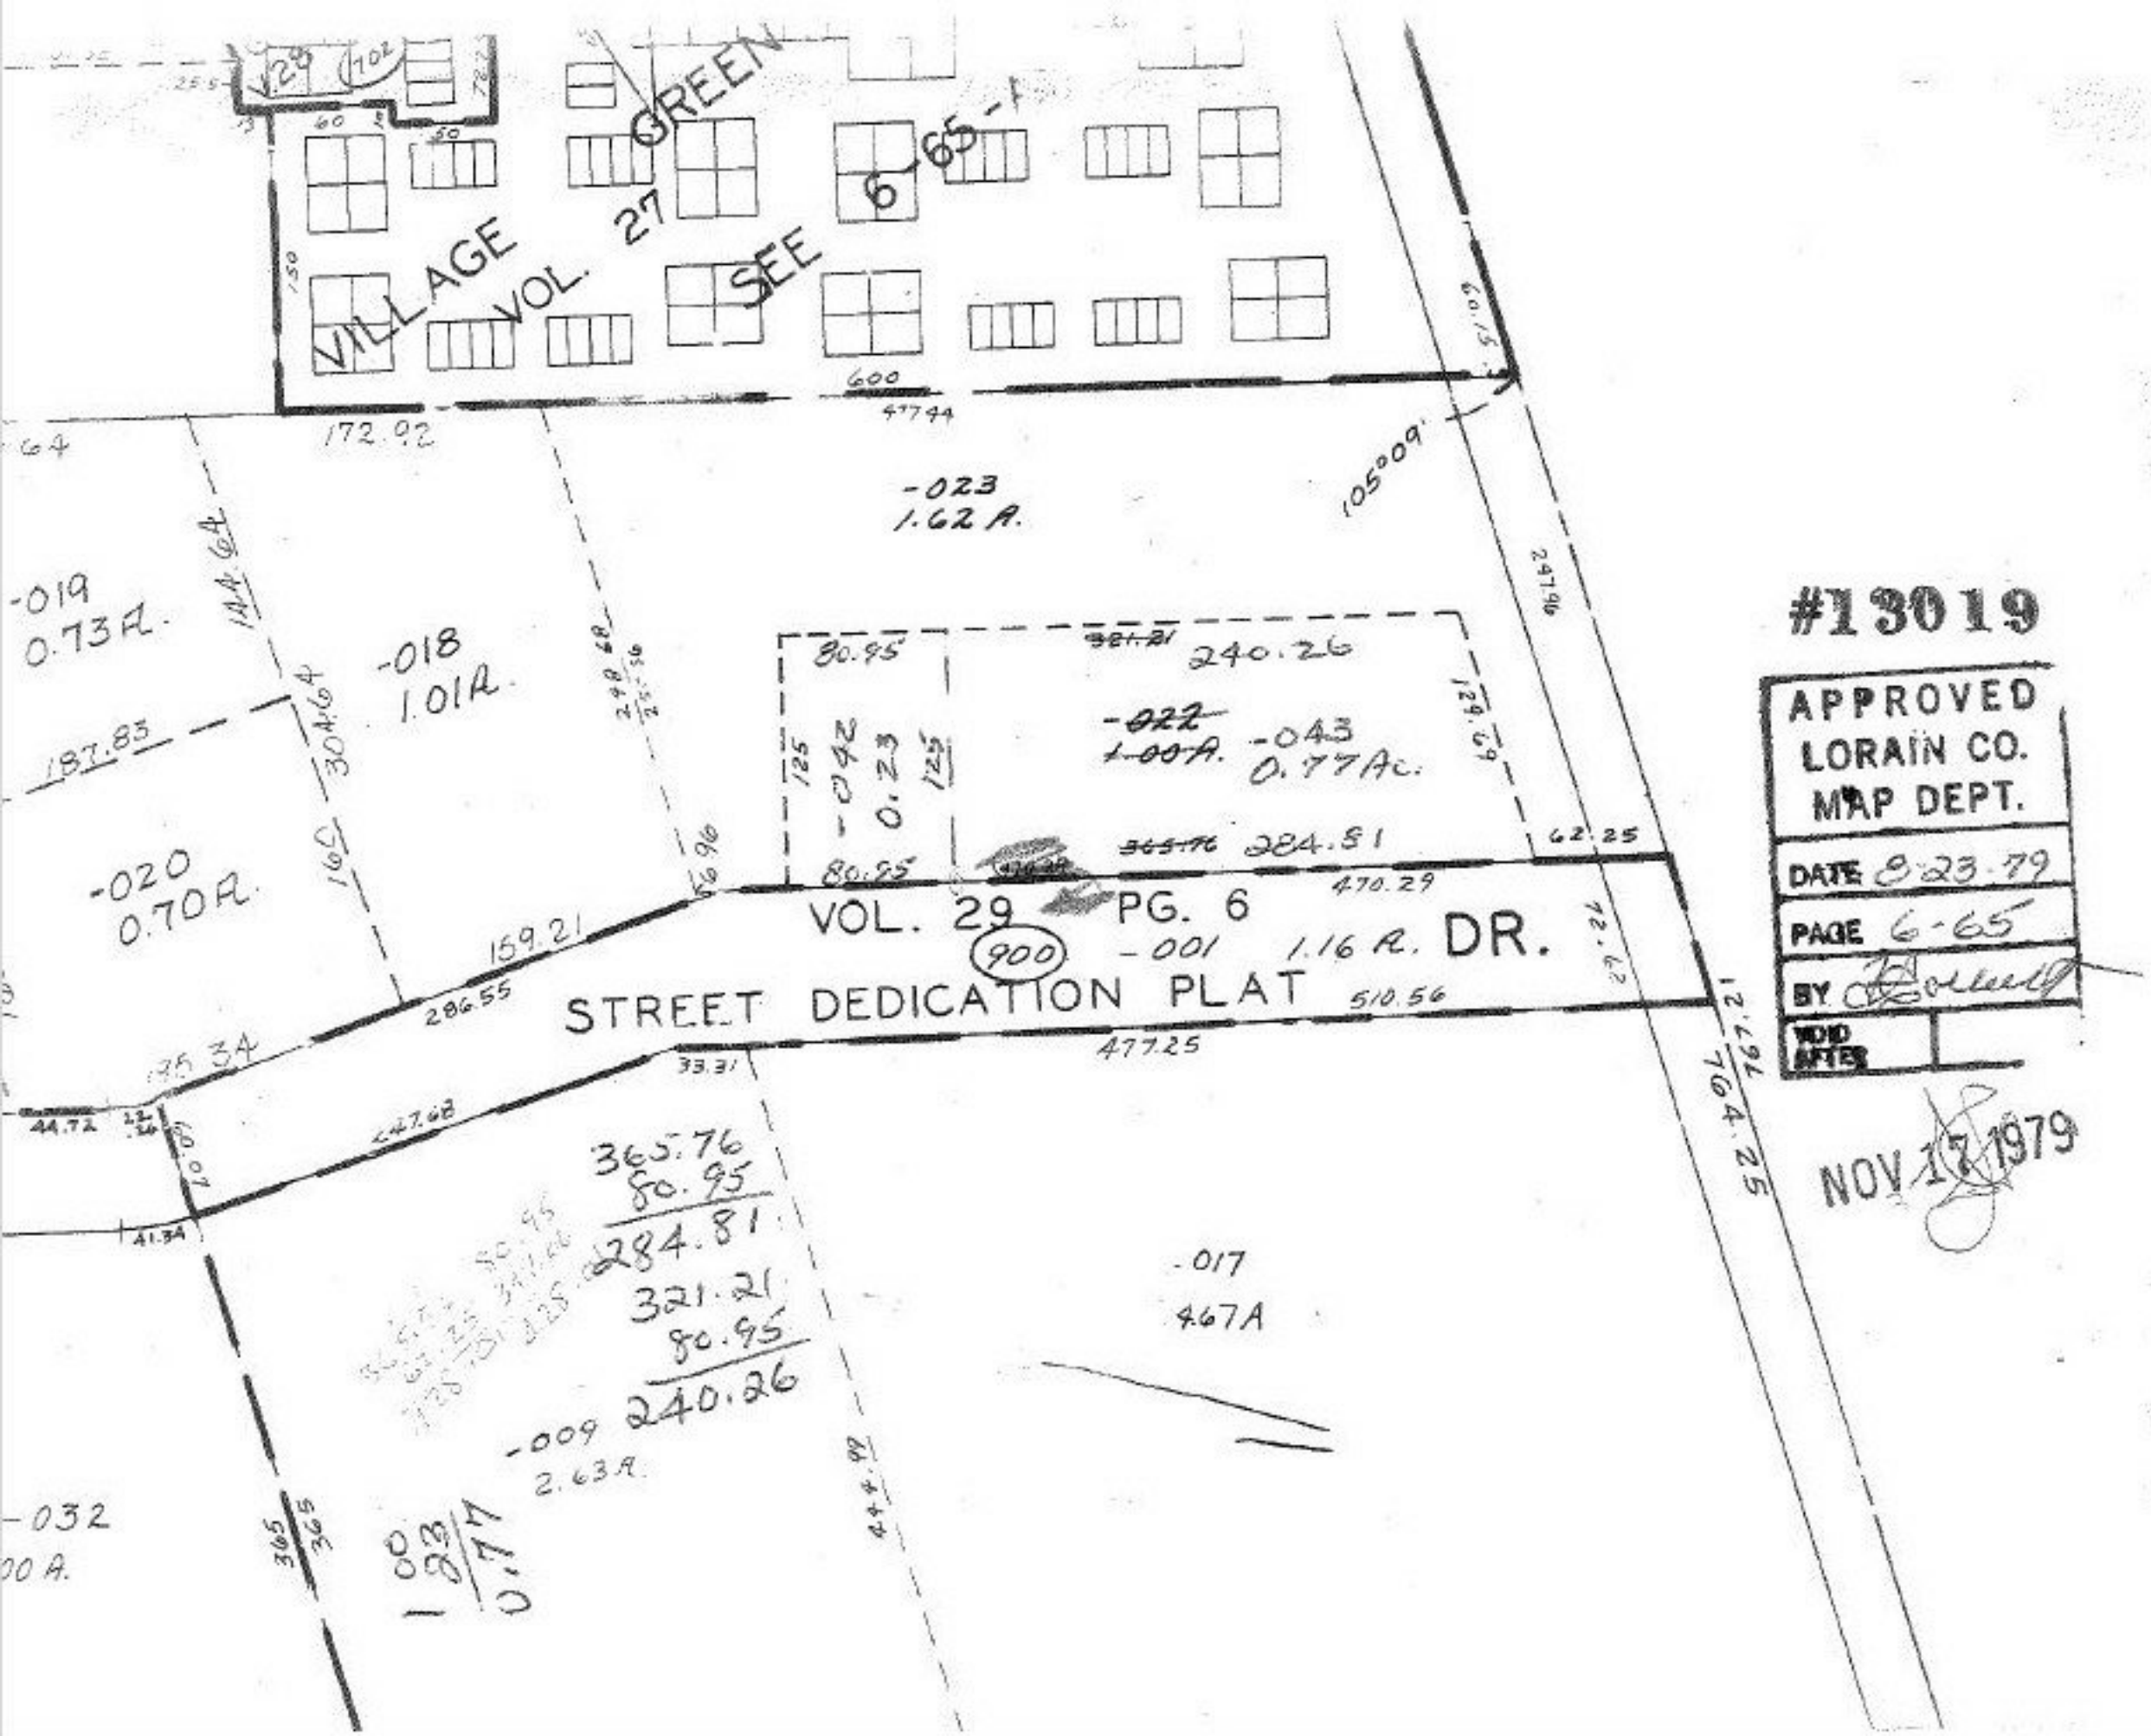

#13019

APPROVED
LORAIN CO.
MAP DEPT.

DATE 8-23-79
PAGE 6-65
BY [signature]
VOID AFTER

NOV 17 1979