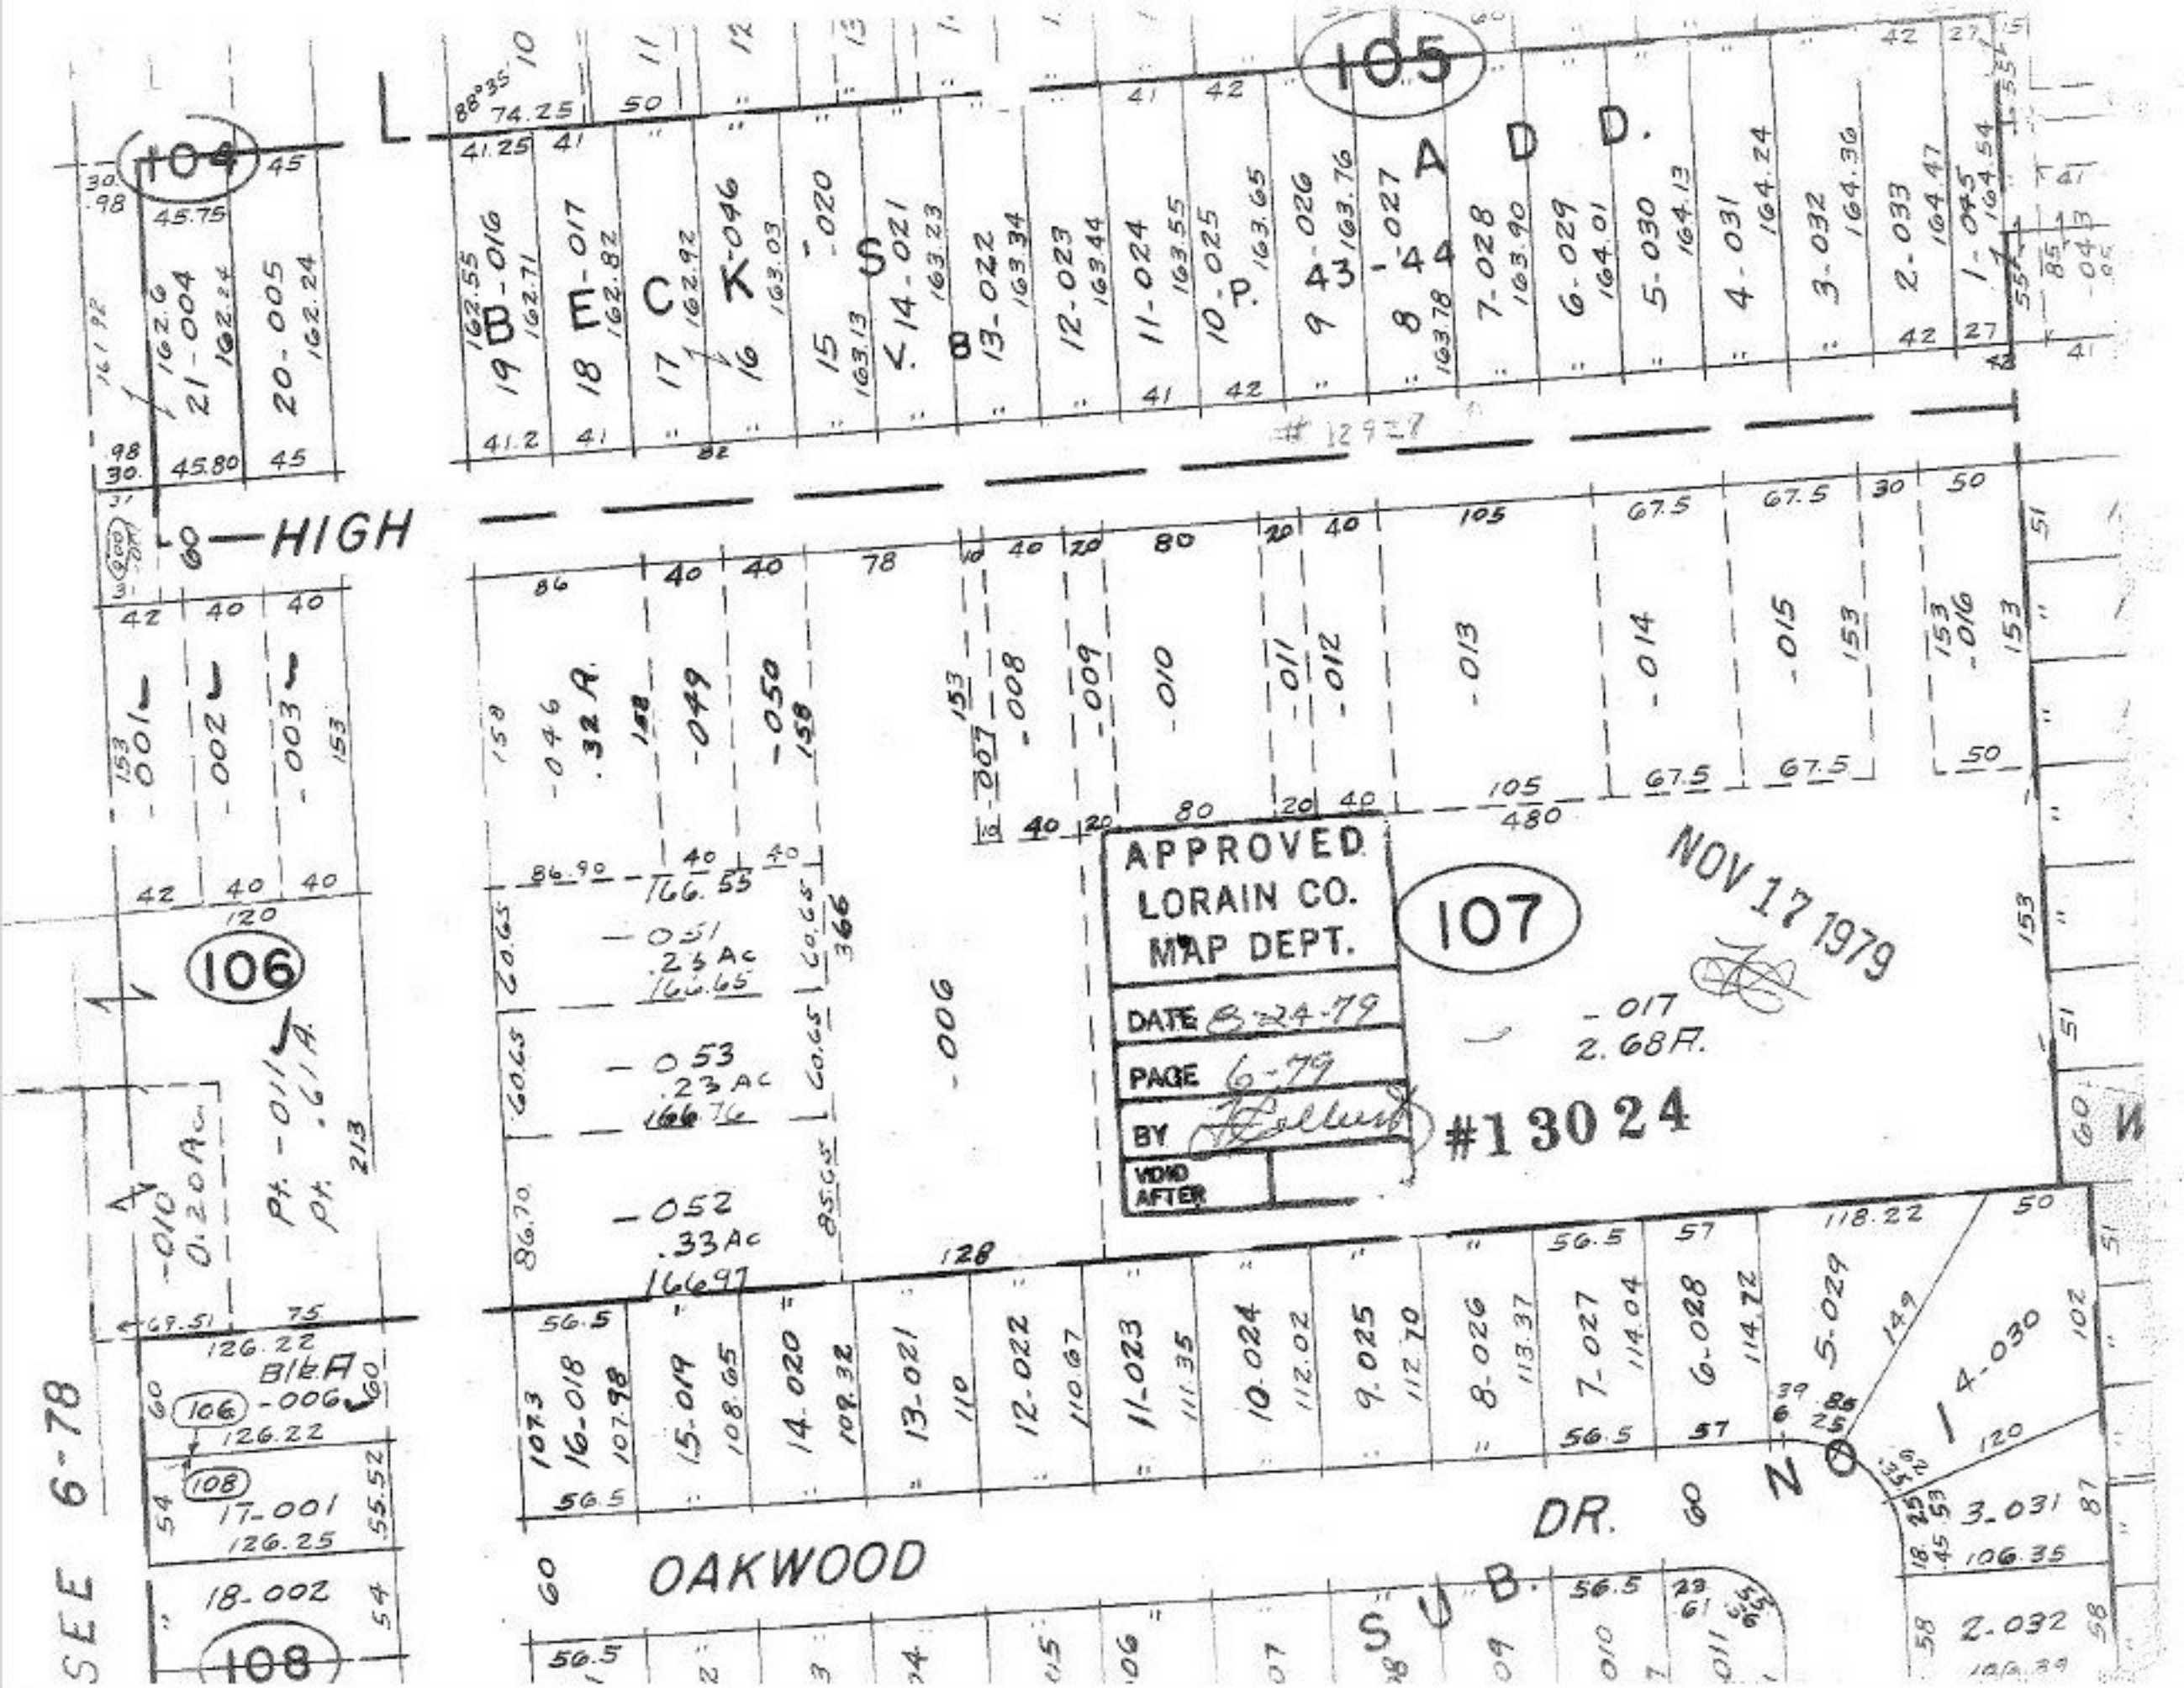

APPROVED
LORAIN CO.
MAP DEPT.
DATE 8-24-79
PAGE 6-79
BY
VOID AFTER
NOV 17 1979
#13024
#12927
BECKS ADD.
HIGH
OAKWOOD DR.
SUB.
SEE 6-78
104
105
106
107
108