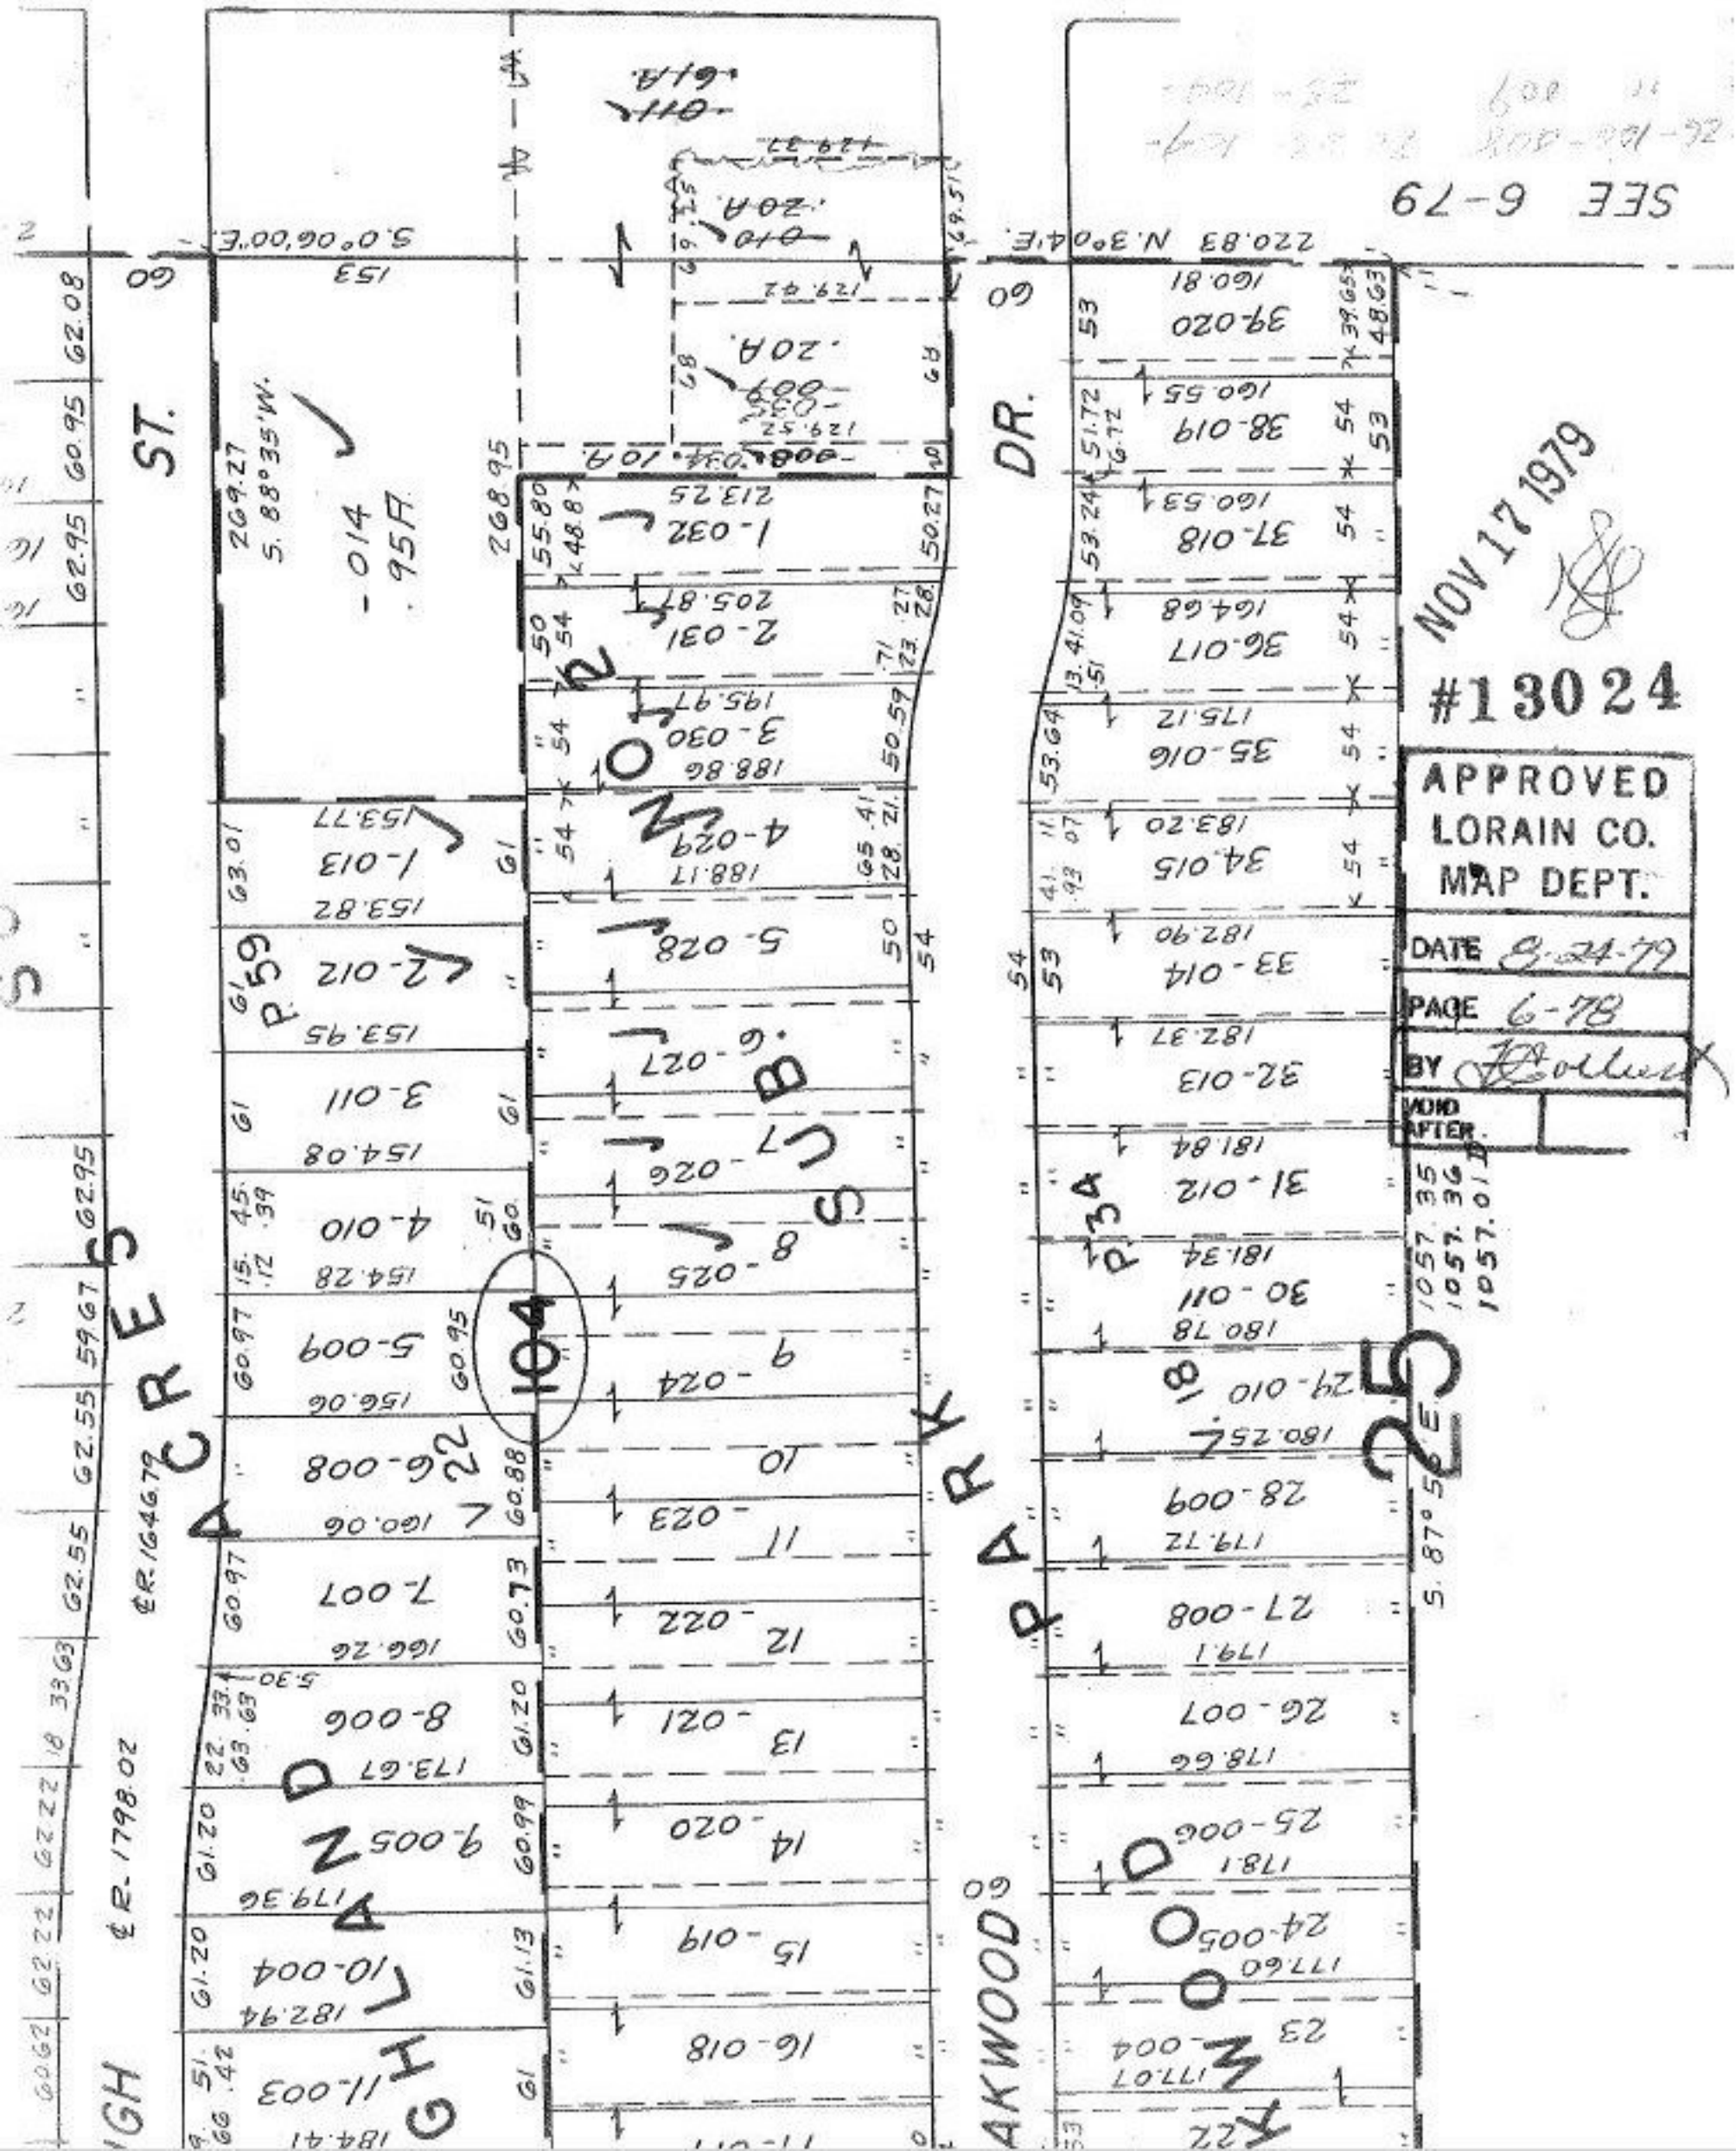

SEE 6-79
NOV 17 1979
#13024
APPROVED
LORAIN CO.
MAP DEPT.
DATE 8-24-79
PAGE 6-78
BY
VOID AFTER
ST.
DR.
ACRES
SUB
PARK
104
25