#13026

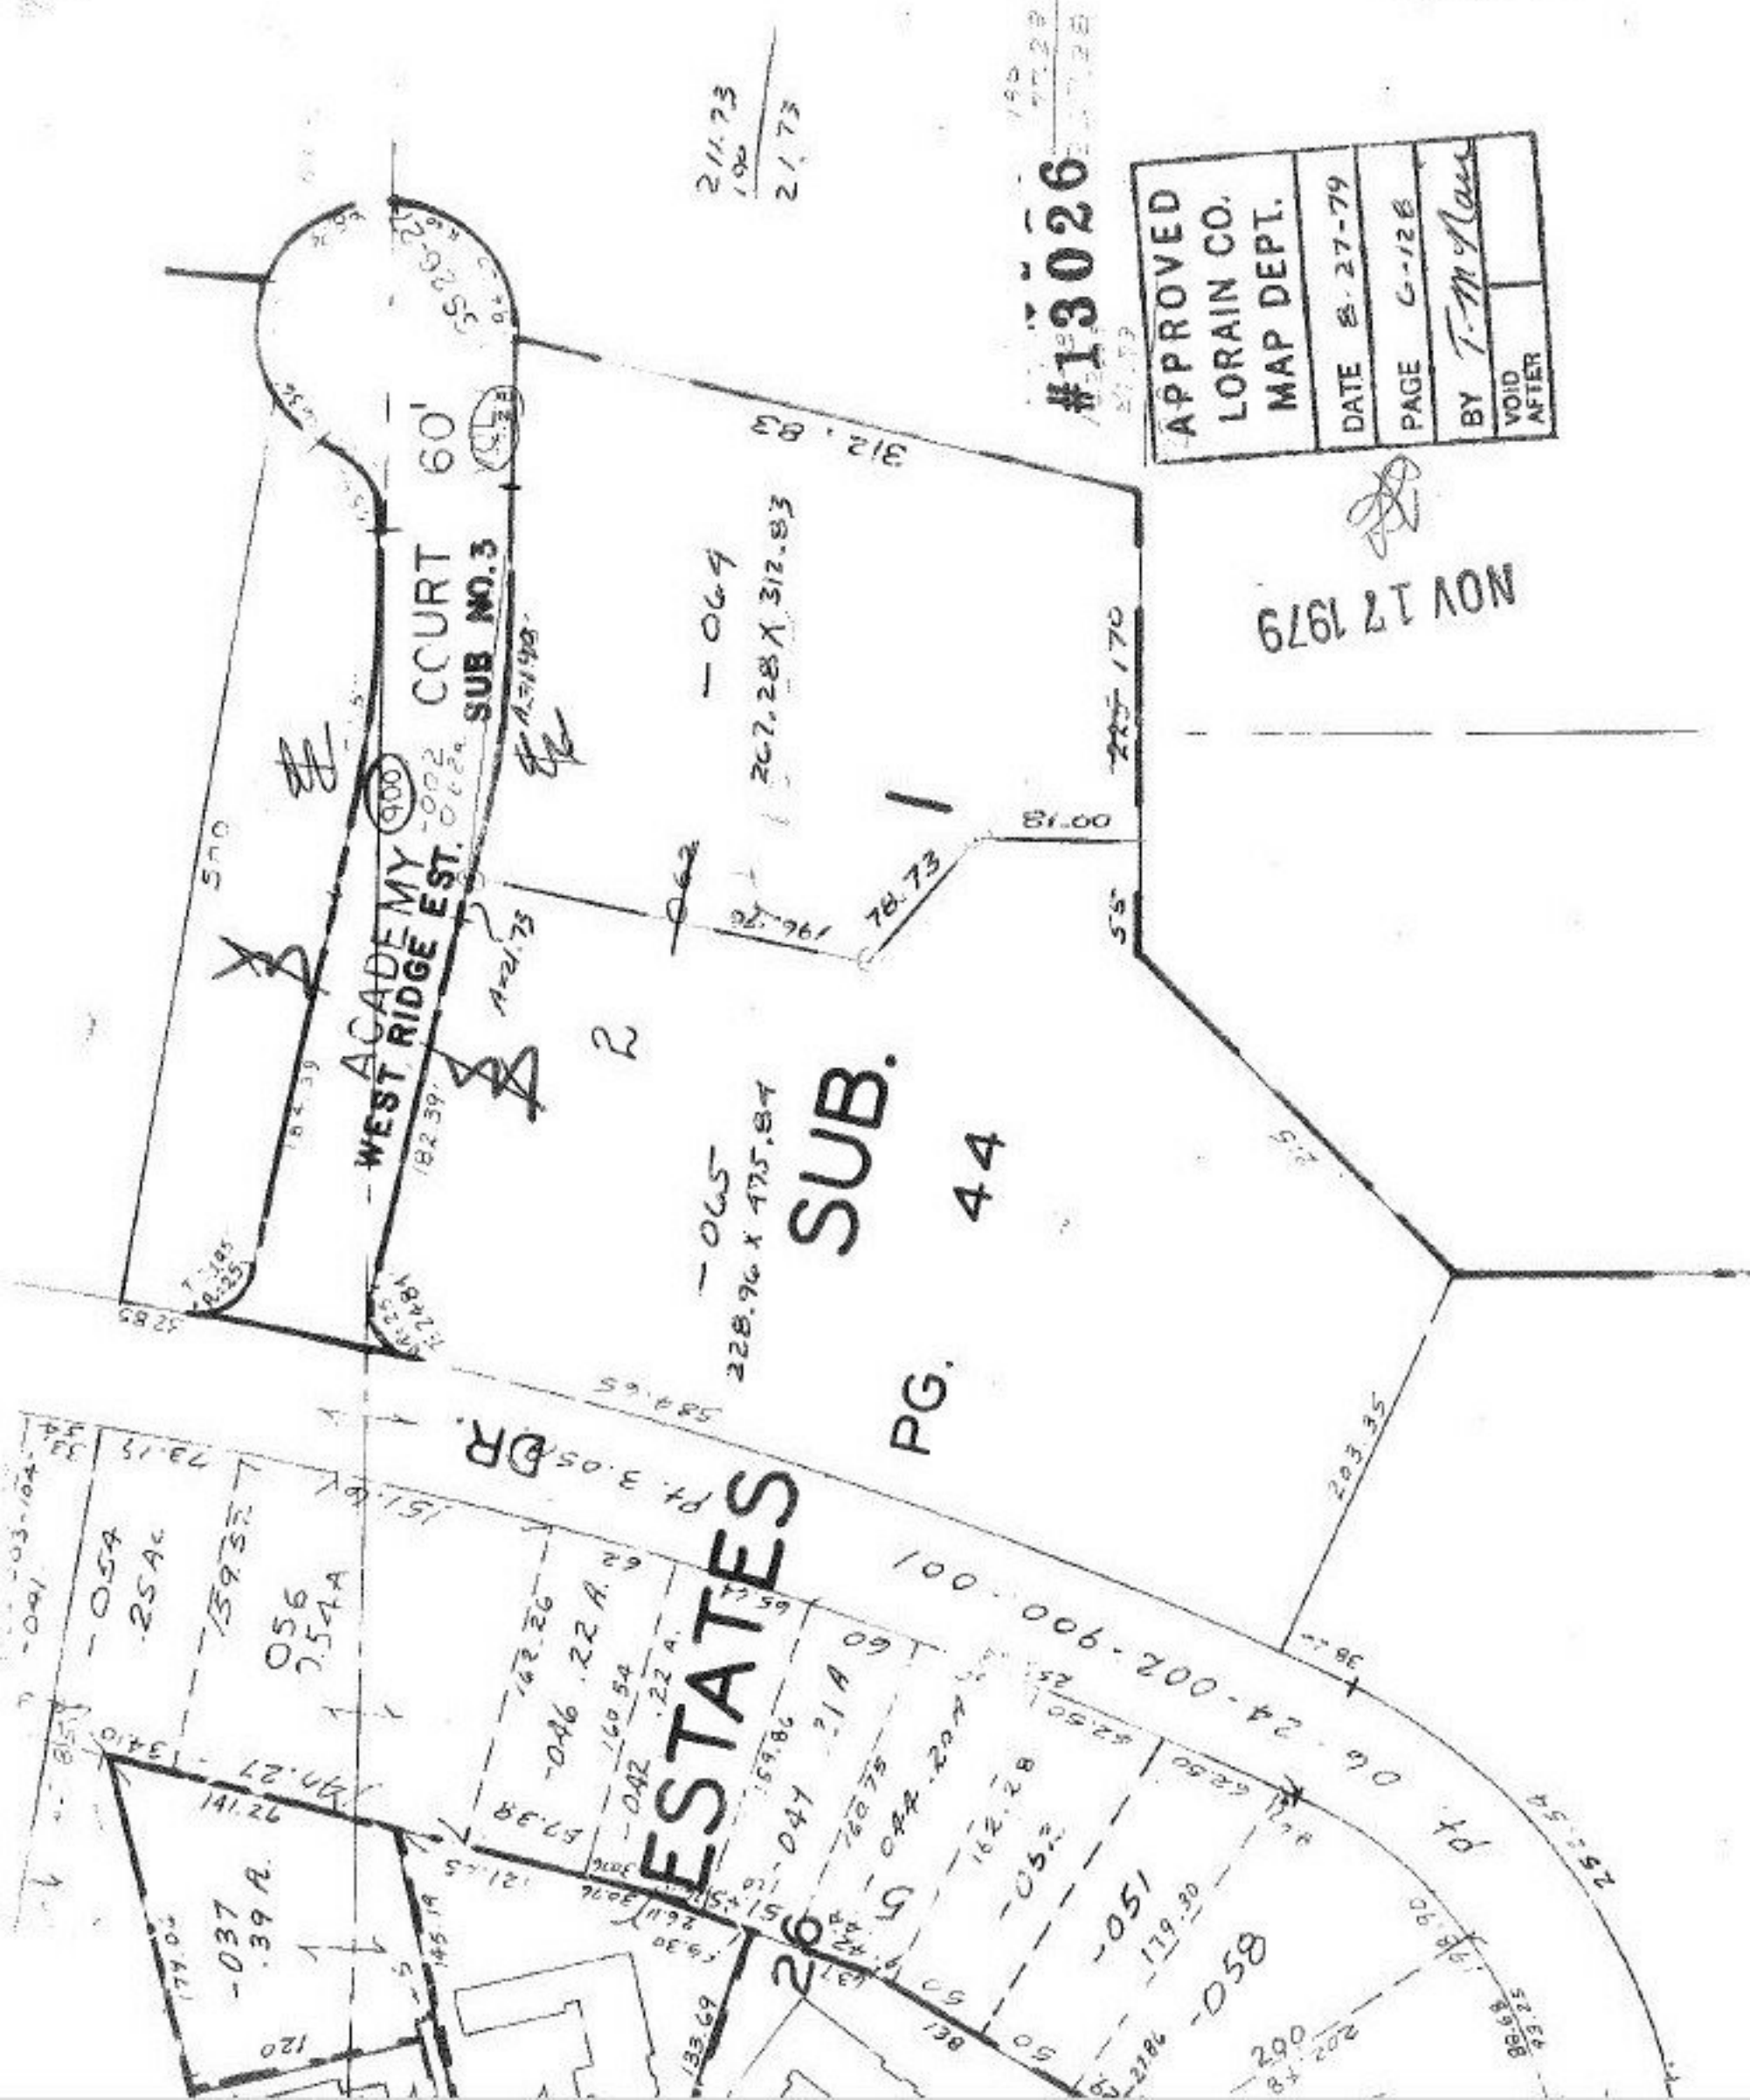

#13026
APPROVED
LORAIN CO.
MAP DEPT.
DATE 8-27-79
PAGE G-128
BY T. McNair
VOID AFTER
NOV 17 1979
ACADEMY COURT 60'
WEST RIDGE EST. SUB NO. 3
SUB. 44
PG. 26
ESTATES
DR.
312.83
267.28 X 312.83
228.96 X 475.84