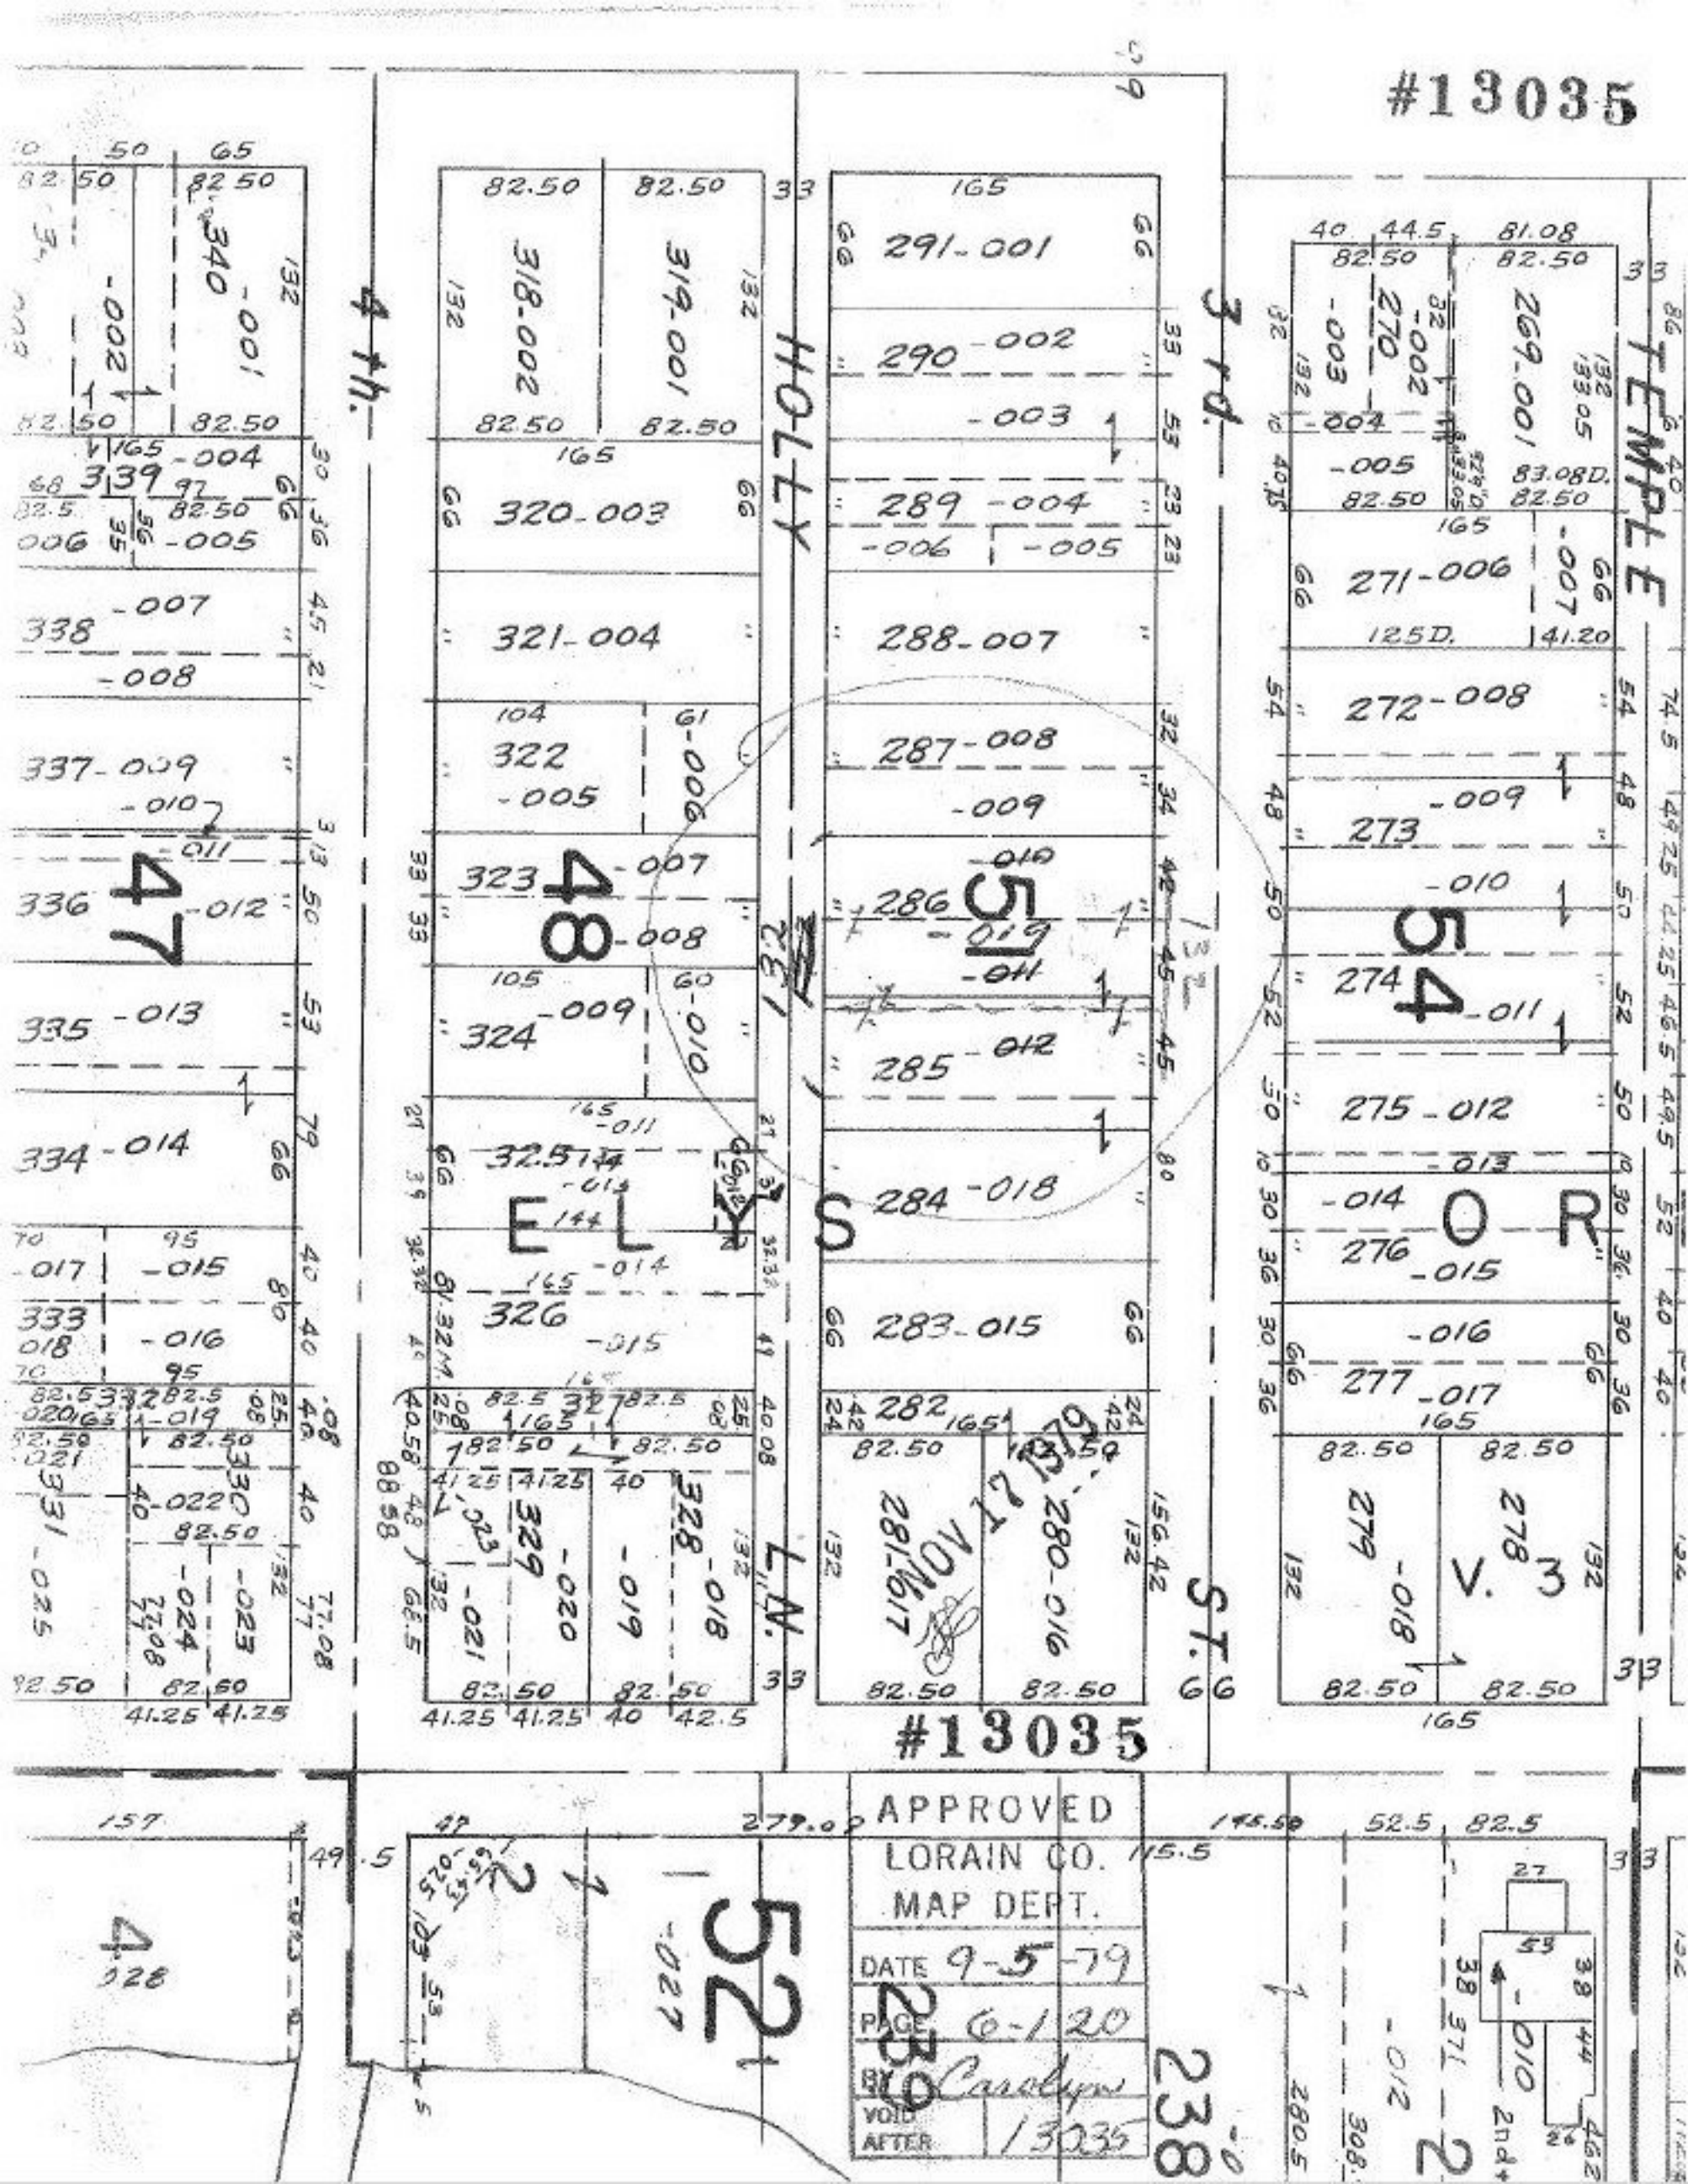
#13035
4 th.
3 rd.
HOLLY
TEMPLE
ELYS
OR
LN.
ST.
V. 3
47
48
54
52
NOV 17 1979
#13035
APPROVED
LORAIN CO.
MAP DEPT.
DATE 9-5-79
PAGE 6-120
BY Carolyn
VOID AFTER 13035