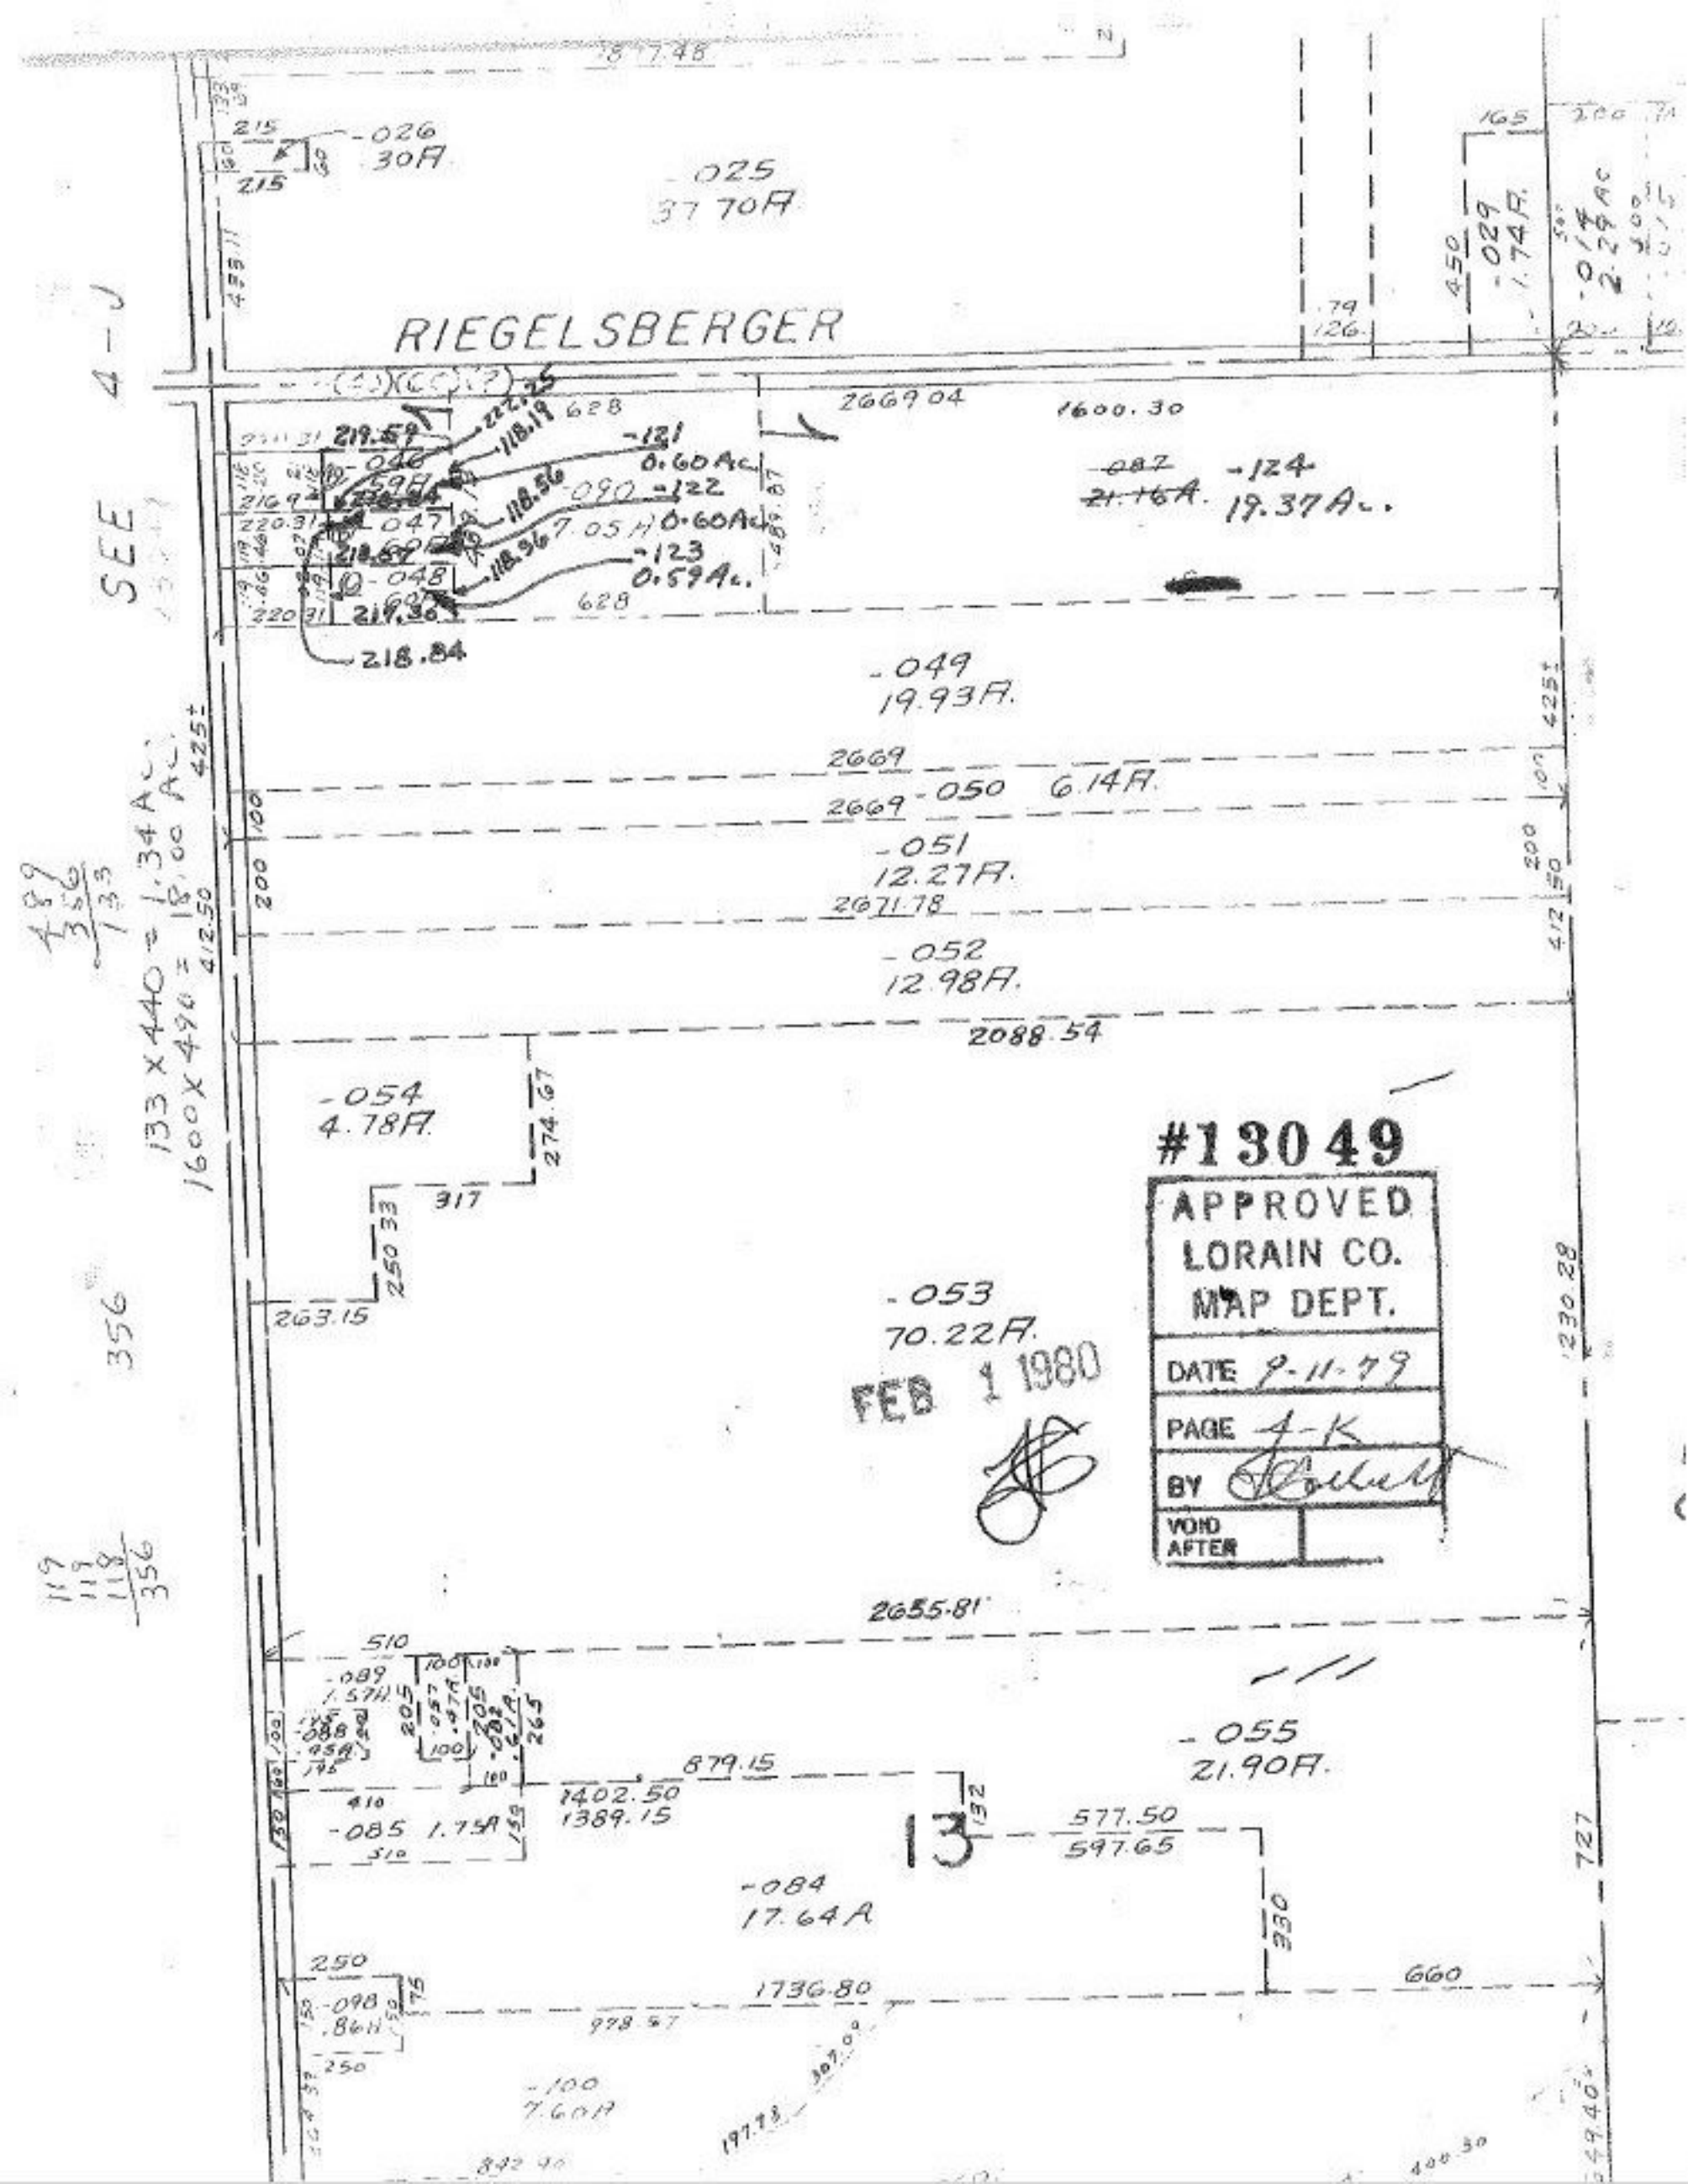

#13049

APPROVED
LORAIN CO.
MAP DEPT.

DATE 9-11-79

PAGE 4-K

BY [signature]

VOID AFTER

FEB 1 1980