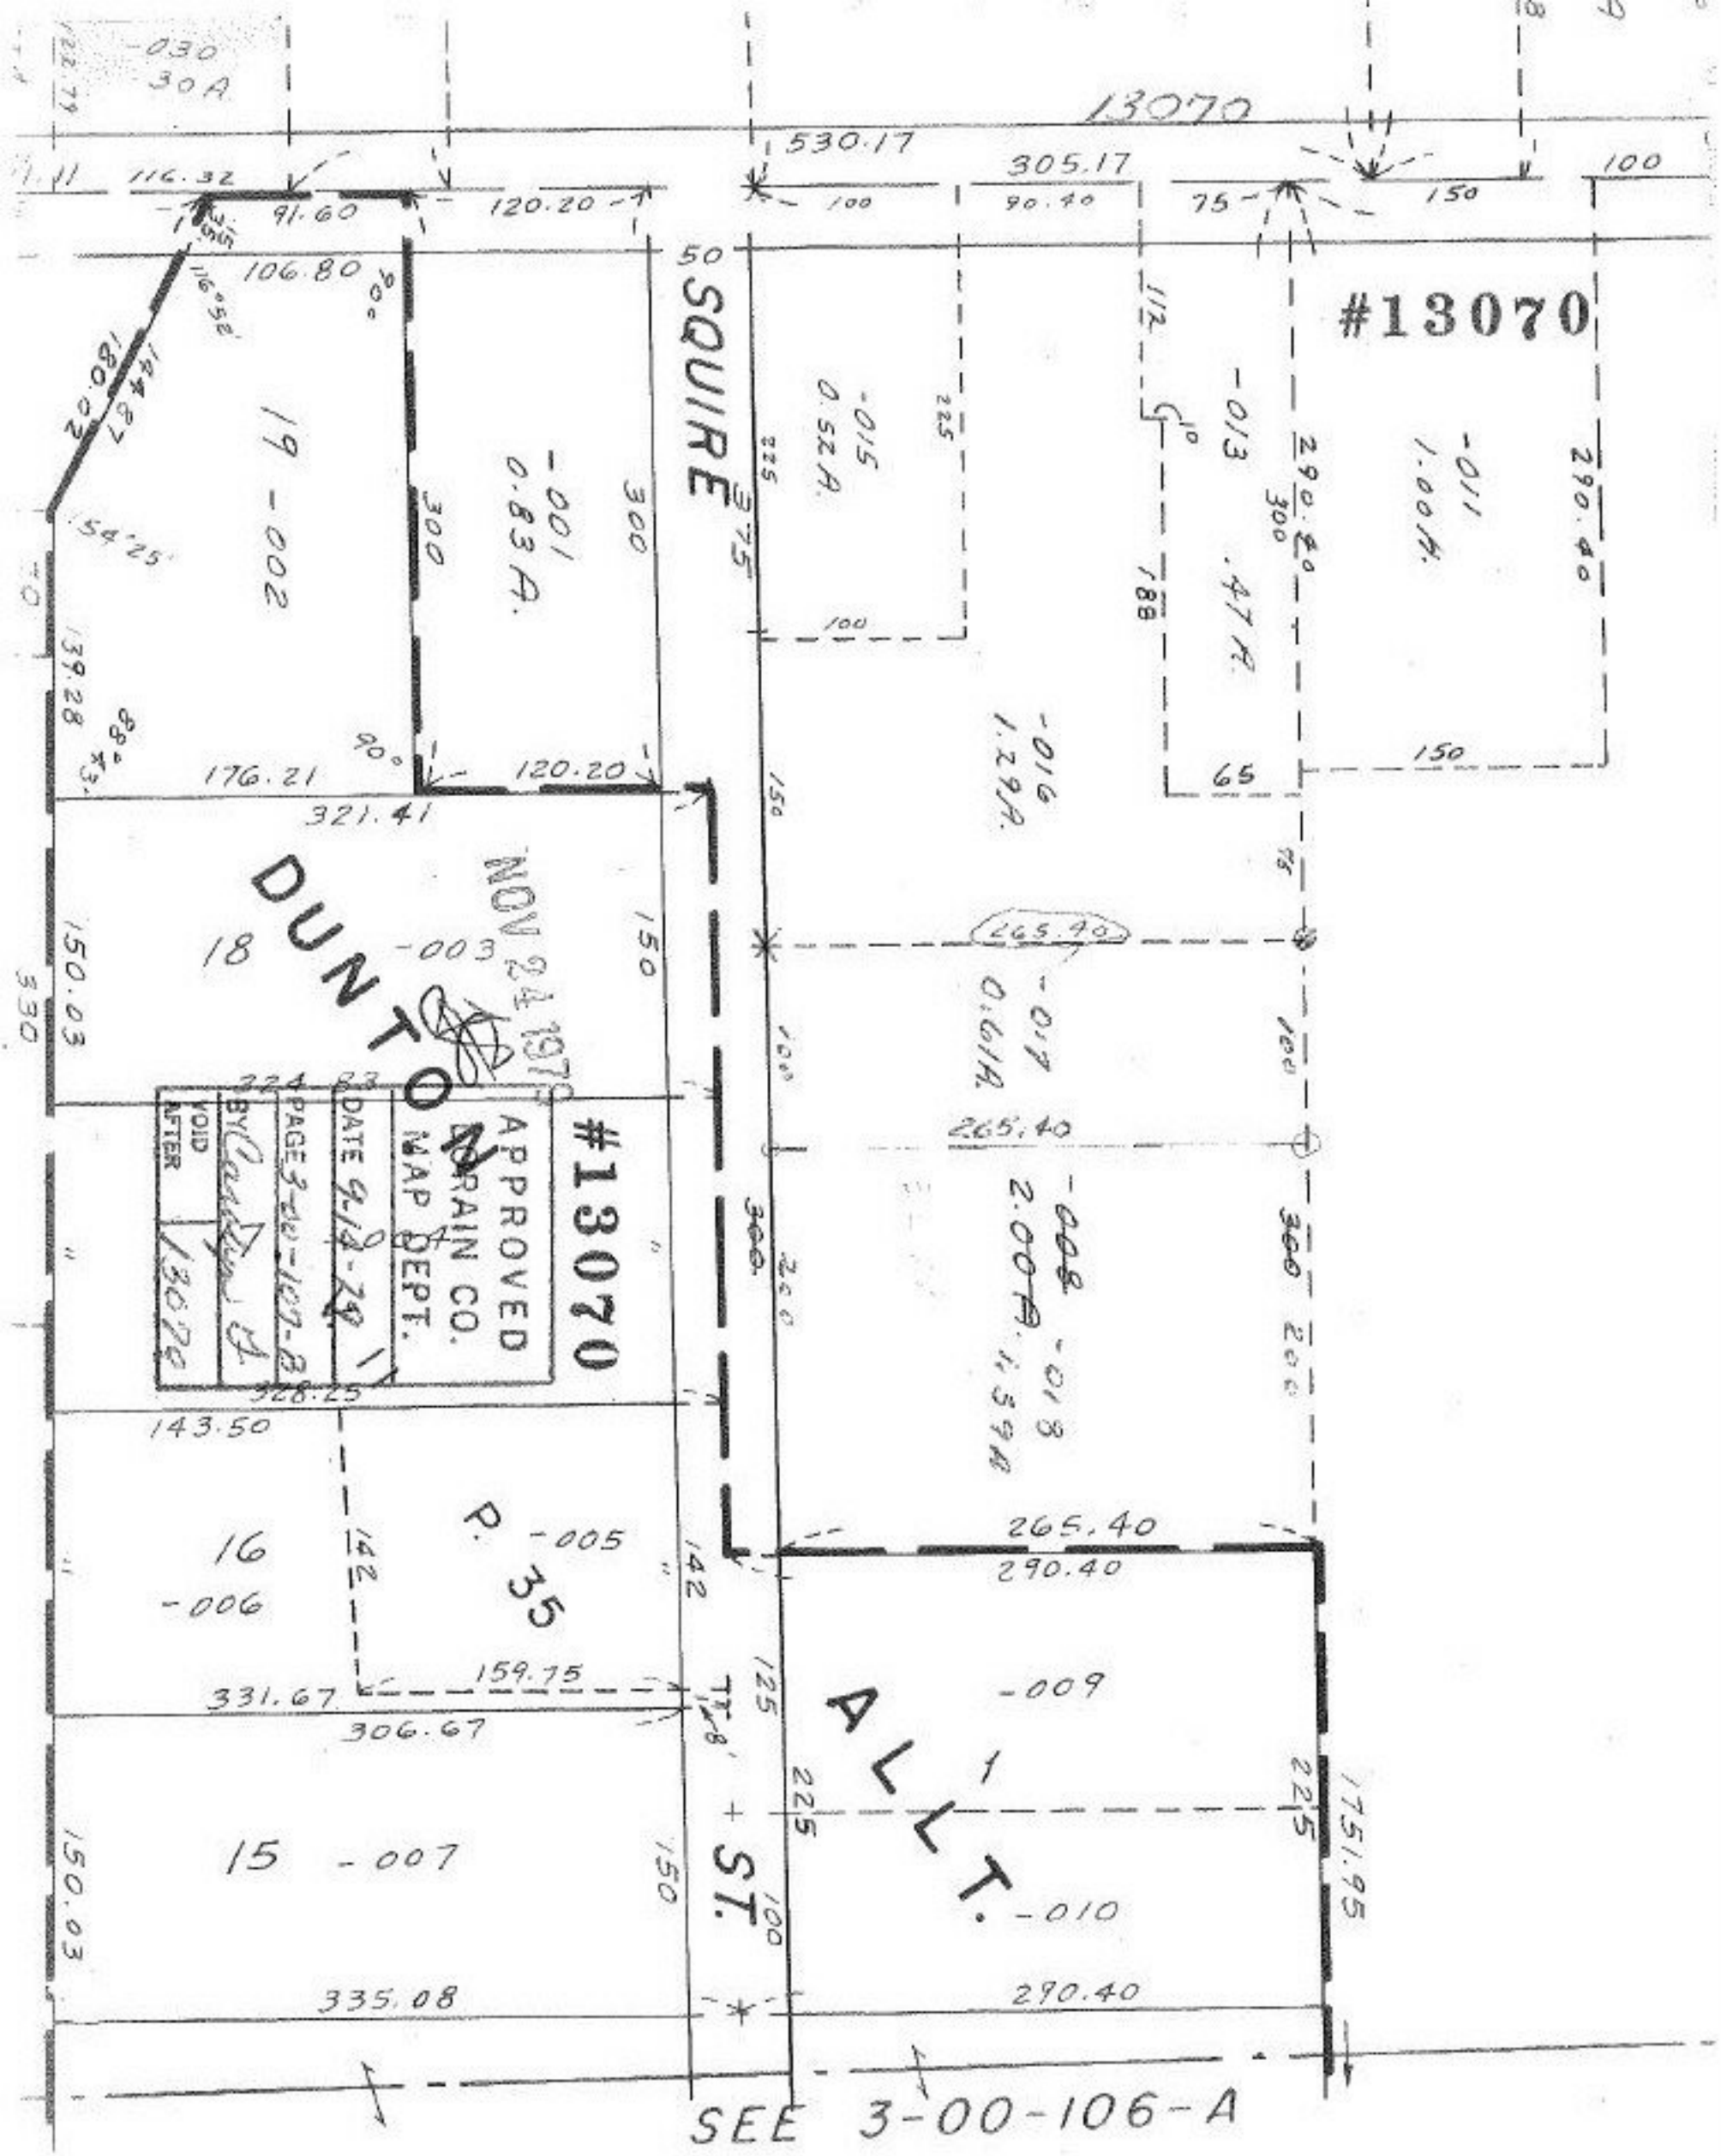

13070
#13070
SQUIRE
ST.
DUNTON
ALLT.
P. 35
#13070
APPROVED
MAP DEPT.
NOV 24 1979
DATE 9-14-79
PAGE 3-00-107-B
BY
VOID AFTER 13070
SEE 3-00-106-A