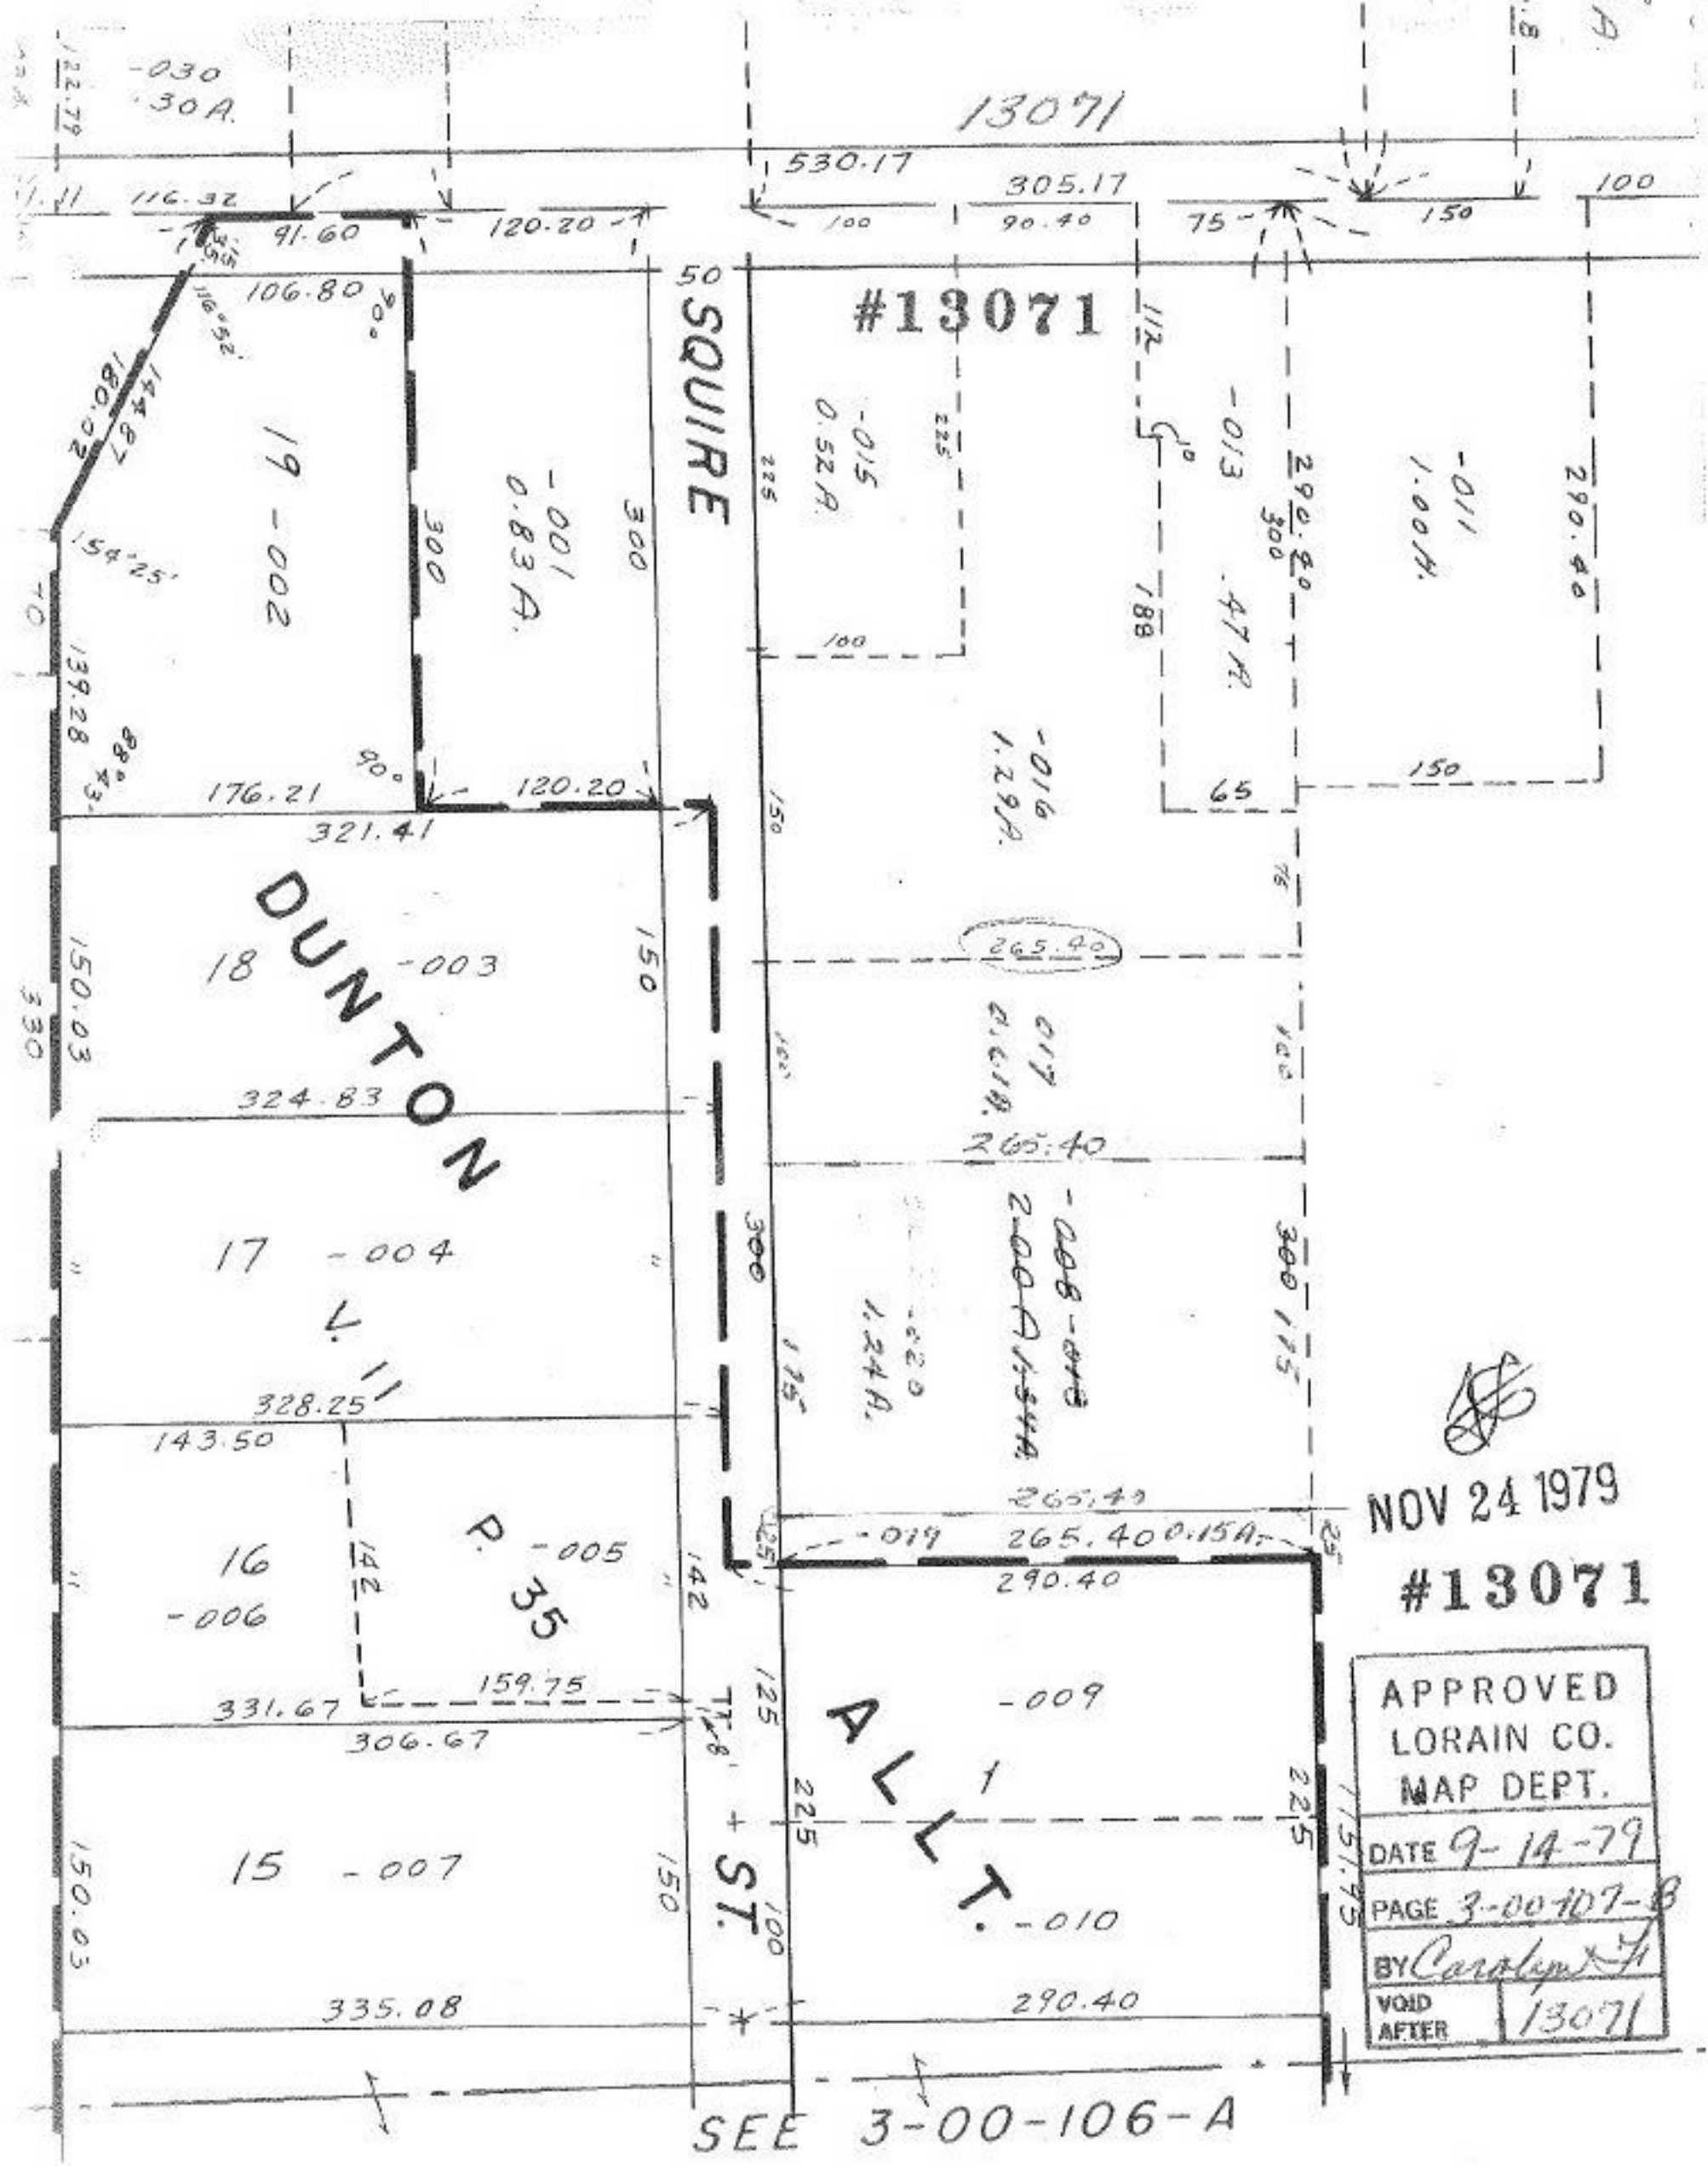

13071
#13071
SQUIRE
DUNTON
ALLT.
ST.
P. 35
19 -002
-001 0.83A.
-015 0.52A.
-013 .47A.
-011 1.00A.
-016 1.29A.
-017 0.61A.
-008 -018 2.00A 1.34A.
-020 1.24A.
18 -003
17 -004
16 -006
-005
15 -007
-009
-010
-019
530.17
305.17
116.32
91.60
120.20
106.80
176.21
321.41
324.83
328.25
143.50
331.67
306.67
159.75
335.08
290.40
265.40
SEE 3-00-106-A
NOV 24 1979
#13071
APPROVED
LORAIN CO.
MAP DEPT.
DATE 9-14-79
PAGE 3-00-107-B
BY Carolyn F.
VOID AFTER 13071