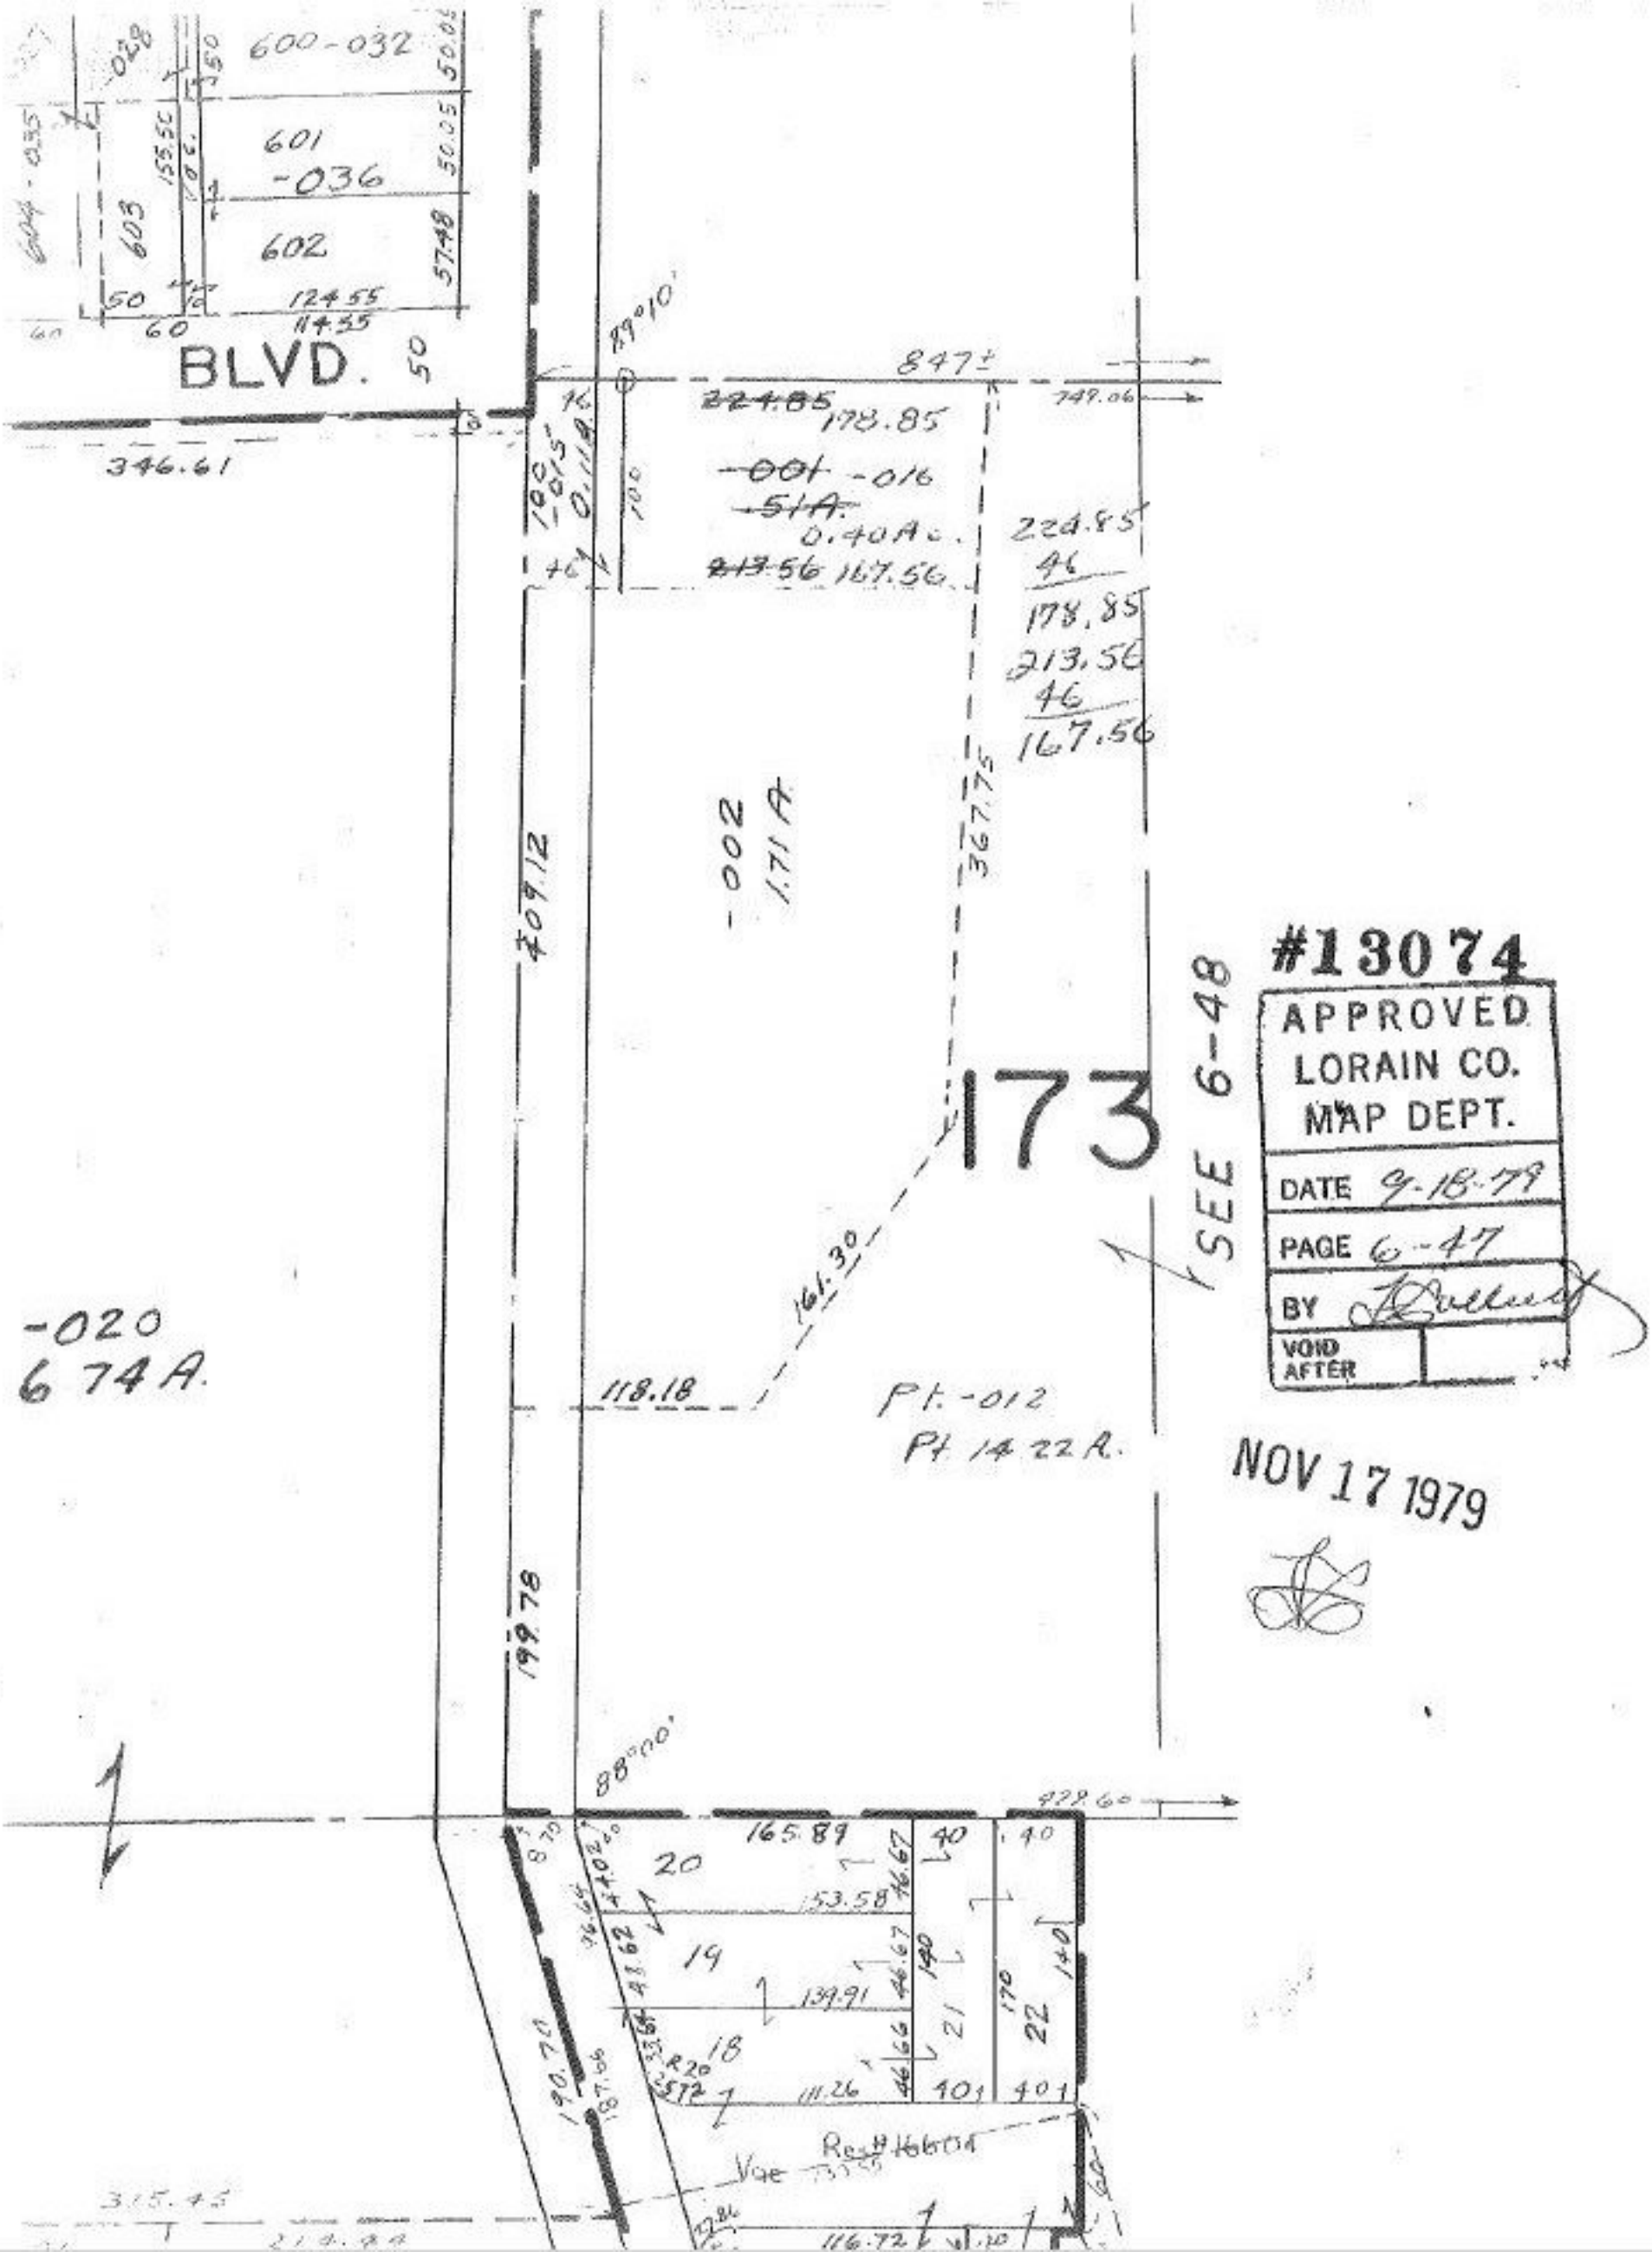

#13074

APPROVED
LORAIN CO.
MAP DEPT.

DATE 9-18-79

PAGE 6-47

BY [signature]

VOID AFTER

NOV 17 1979