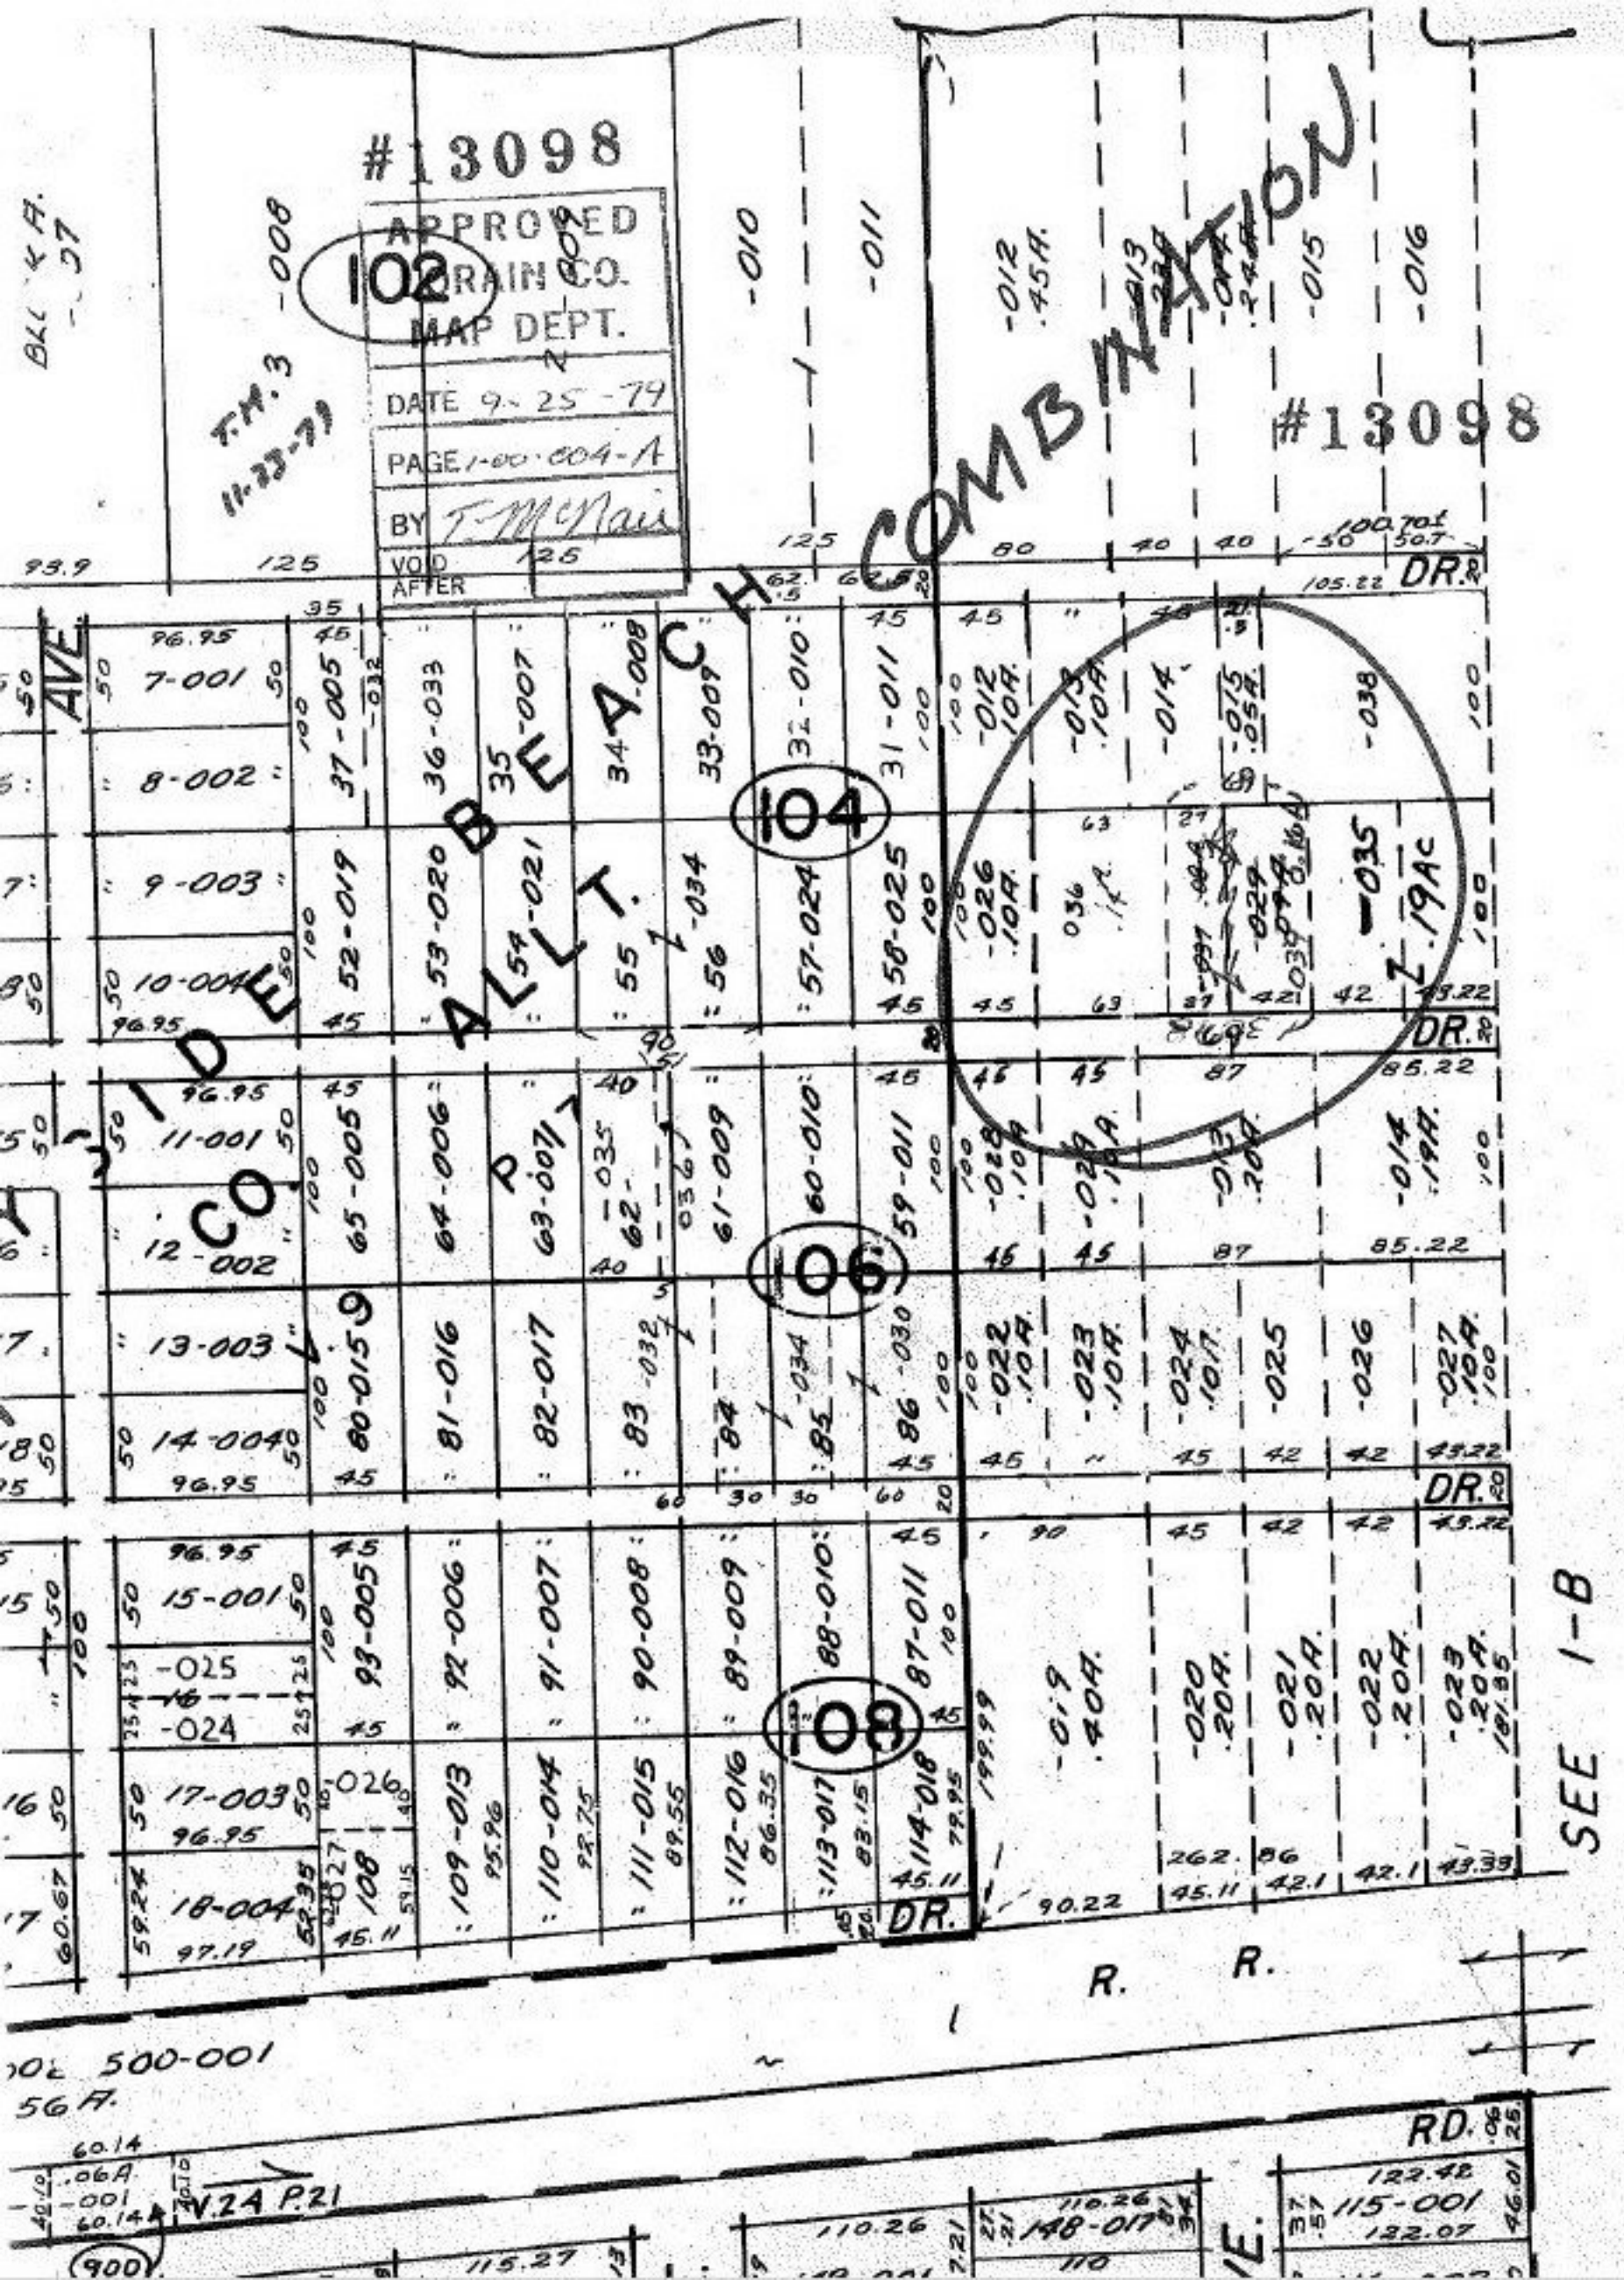

#13098
APPROVED
DRAIN CO.
MAP DEPT.
DATE 9-25-79
PAGE 1-00-004-A
BY T. McNair
VOID
AFTER
102
104
106
108
T.M. 3
11-23-79
#13098
COMBINATION
BEACH
ALLT.
CO
AVE.
DR.
RD.
SEE 1-B
R. R.
500-001
56A.
V.24 P.21