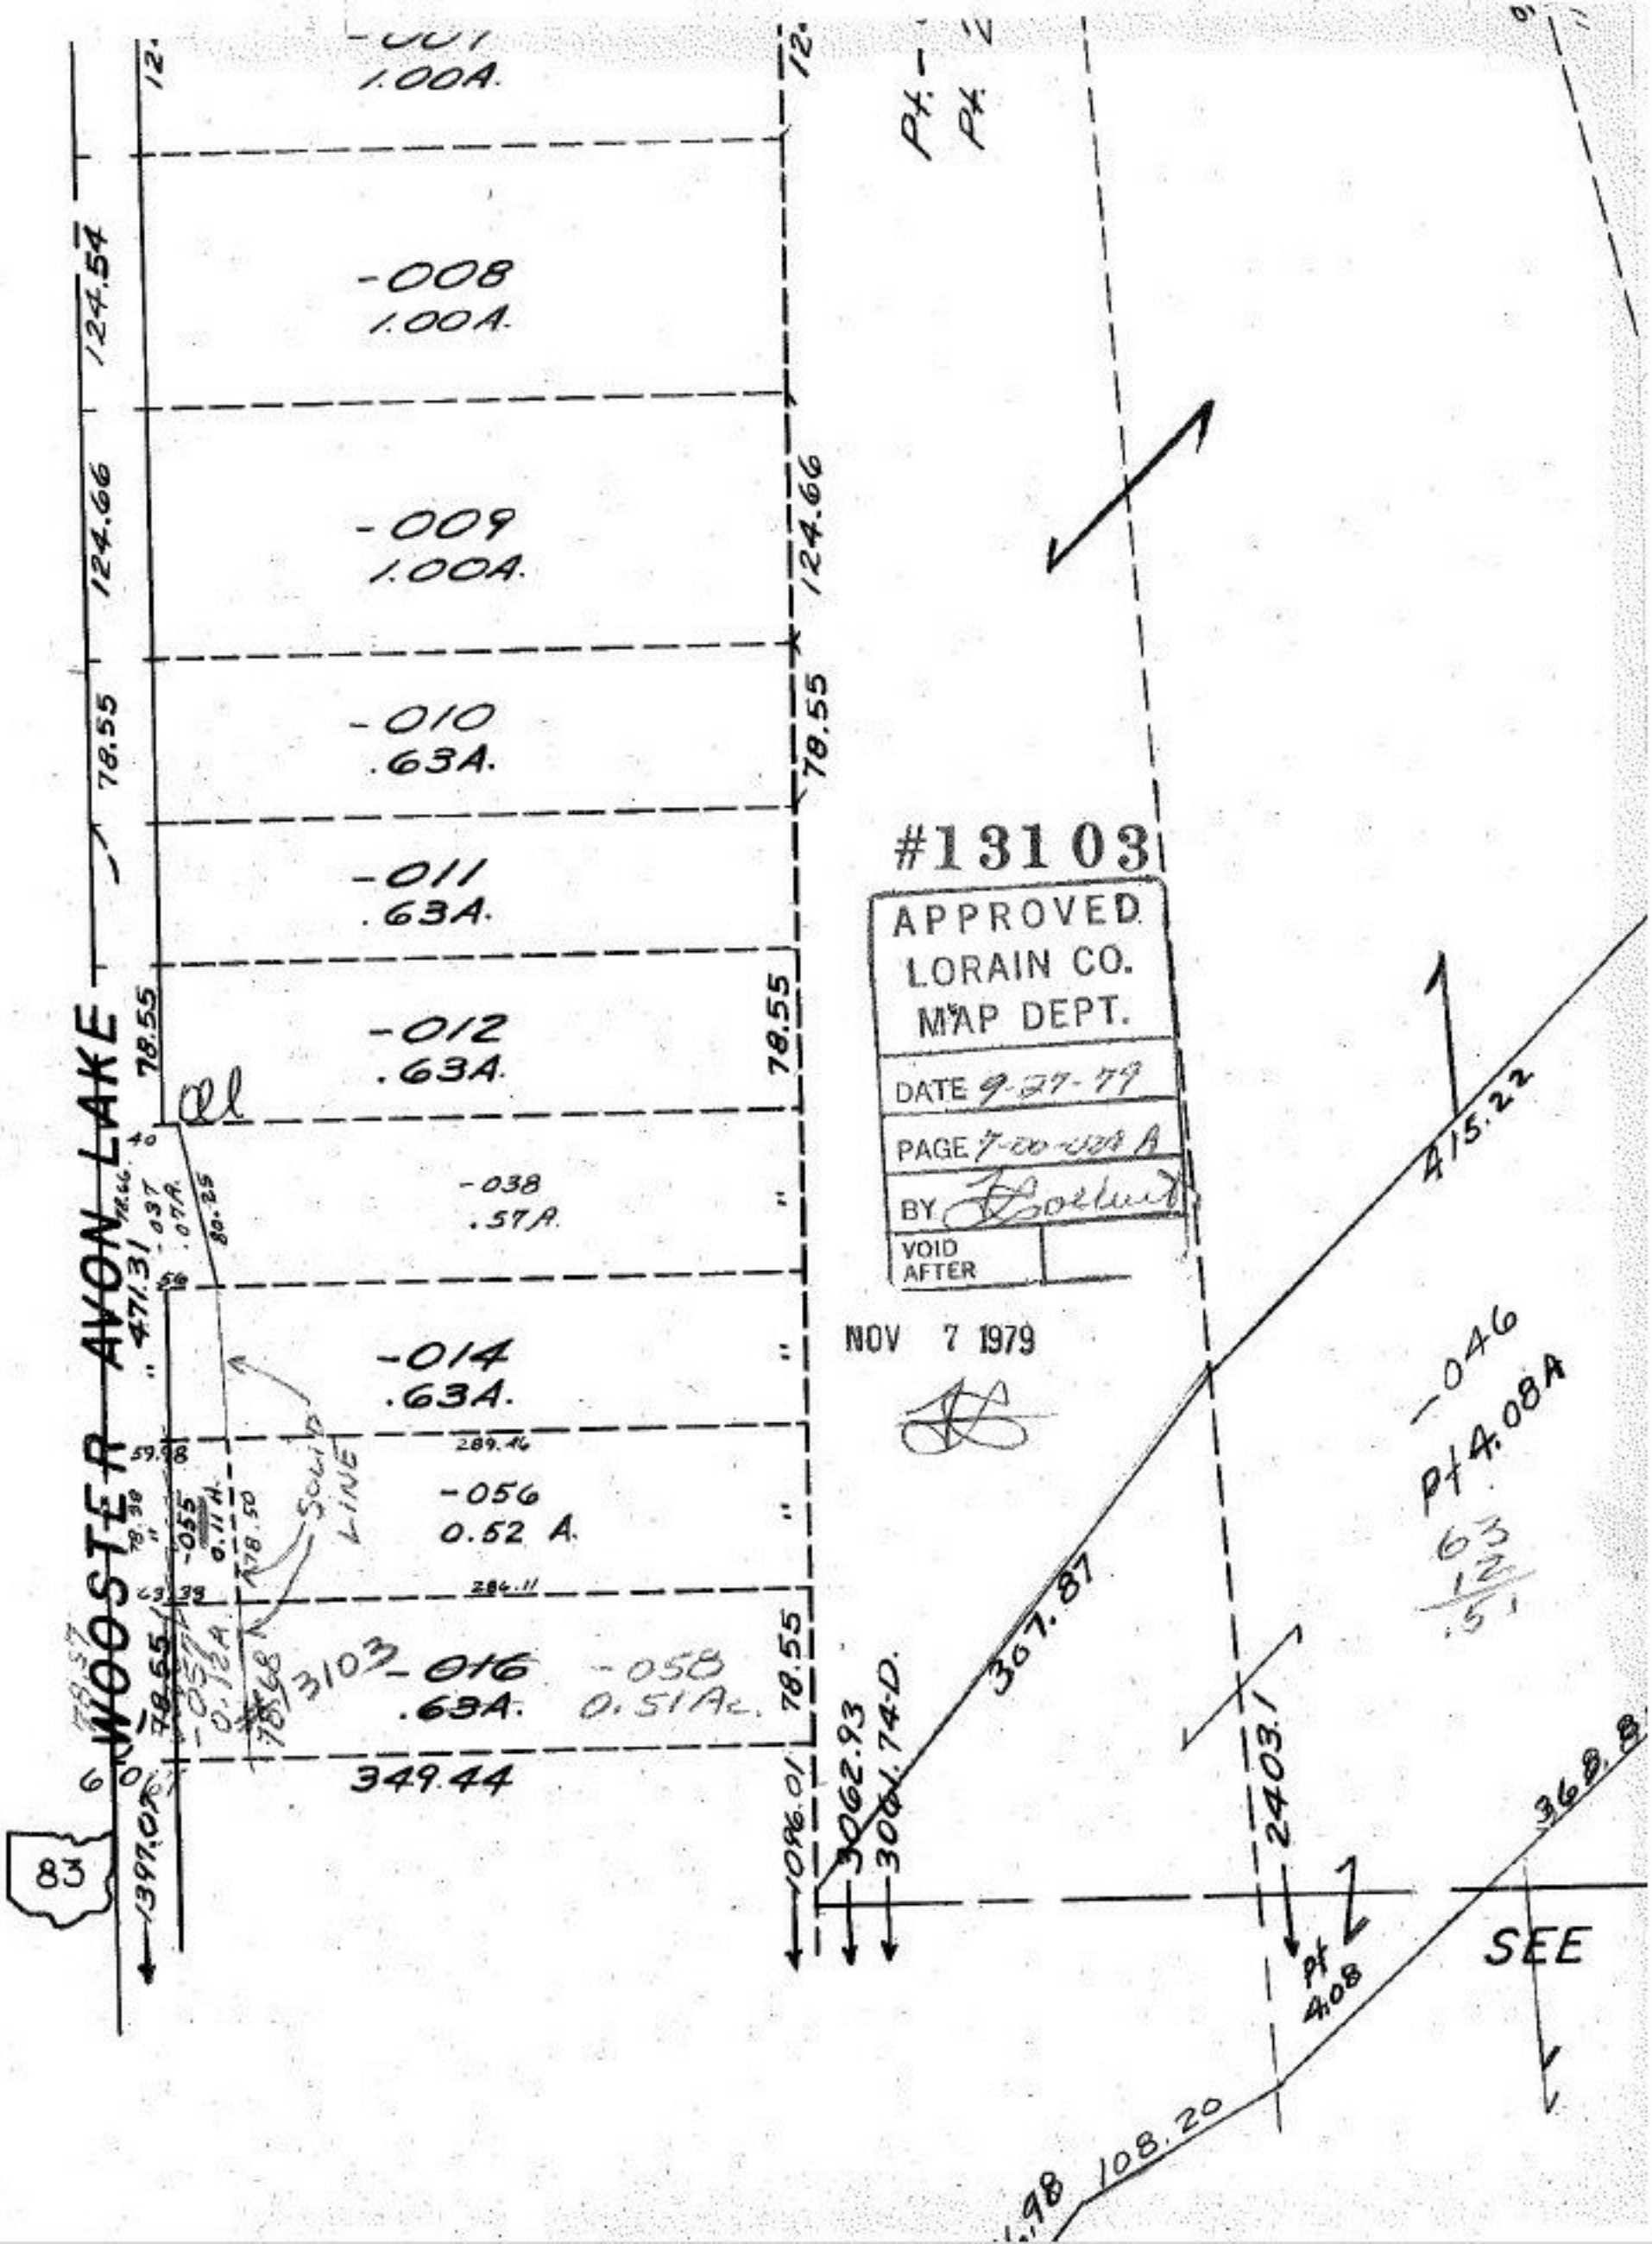

-007
1.00A.
-008
1.00A.
-009
1.00A.
-010
.63A.
-011
.63A.
-012
.63A.
-038
.57A.
-014
.63A.
-056
0.52 A.
-016
.63A.
-058
0.51Ac.
349.44
WOOSTER AVON LAKE
83
124.54
124.66
78.55
471.31
1397.07
1096.01
3062.93
3061.74-D.
307.87
415.22
2403.1
368.8
108.20
Pt 4.08
-046
Pt 4.08A
63
12
.51
SEE
#13103
APPROVED
LORAIN CO.
MAP DEPT.
DATE 9-27-79
PAGE 7-00-024 A
BY
VOID
AFTER
NOV 7 1979